




Urling No. 1 Mine
 36 04852
 SHELICTA, INDIANA COUNTY, PA.
 Scale 1" = 100' Date _____

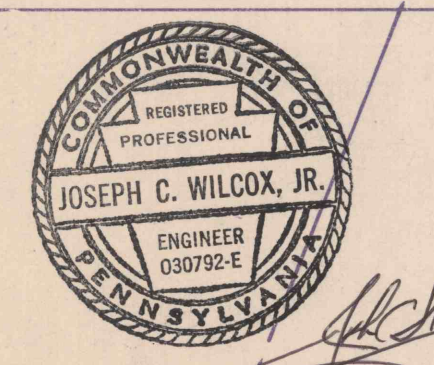

Contemplated Mining
 From 7-1-92 To 1-1-93
 POSTED
 JUL 1, 1992

DDH # 443
 S-1339.9
 E-851.0 3'01"

RECEIVED
 JUL 30 1992
 Dept. of Environmental Resources
 McKeesport District Office

SHEET 6-108
 SHEET 6-137
 SHEET 6-148
 1" = 100'
 URLING NO. 1 MINE
 KEYSTONE COAL MINING CORP.
 ARMSTRONG TWP. INDIANA CO. PA.
 1-136