

CALVIN G. OVERMAN

JAMES BERNARD

DON'T COWN


MARTIN KONKOR

AULTMAN '4' E' SEAM INACTIVE

FINAL SEAL LOCATION #6 #3 SHAFT

FAN DATA: LUCERNE NO. 6 #3 FAN
 TYPE: VOX H-40-36
 SPEED: 1550 R.P.M.
 AMPS: 299 (FULL LOAD)
 VOLTS: 460
 WIND: 130 AMPS
 BLADE SET: 27°
 Q = 81,000 C.F.M.
 4.5 WATER GAGE

"FINAL MINE MAP"

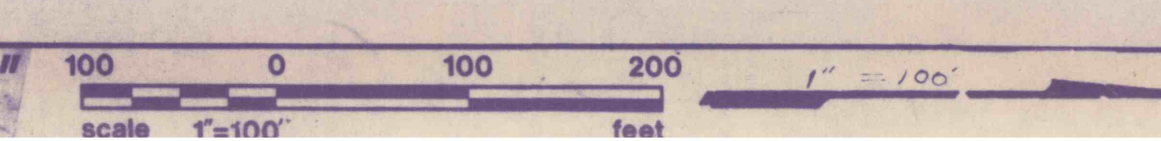

LUCERNE NO. 6 MINE - HELVETIA COAL CO.
 CENTER TWP. INDIANA CO.

11600 9C