



MATCH LINE TO SHEET 32

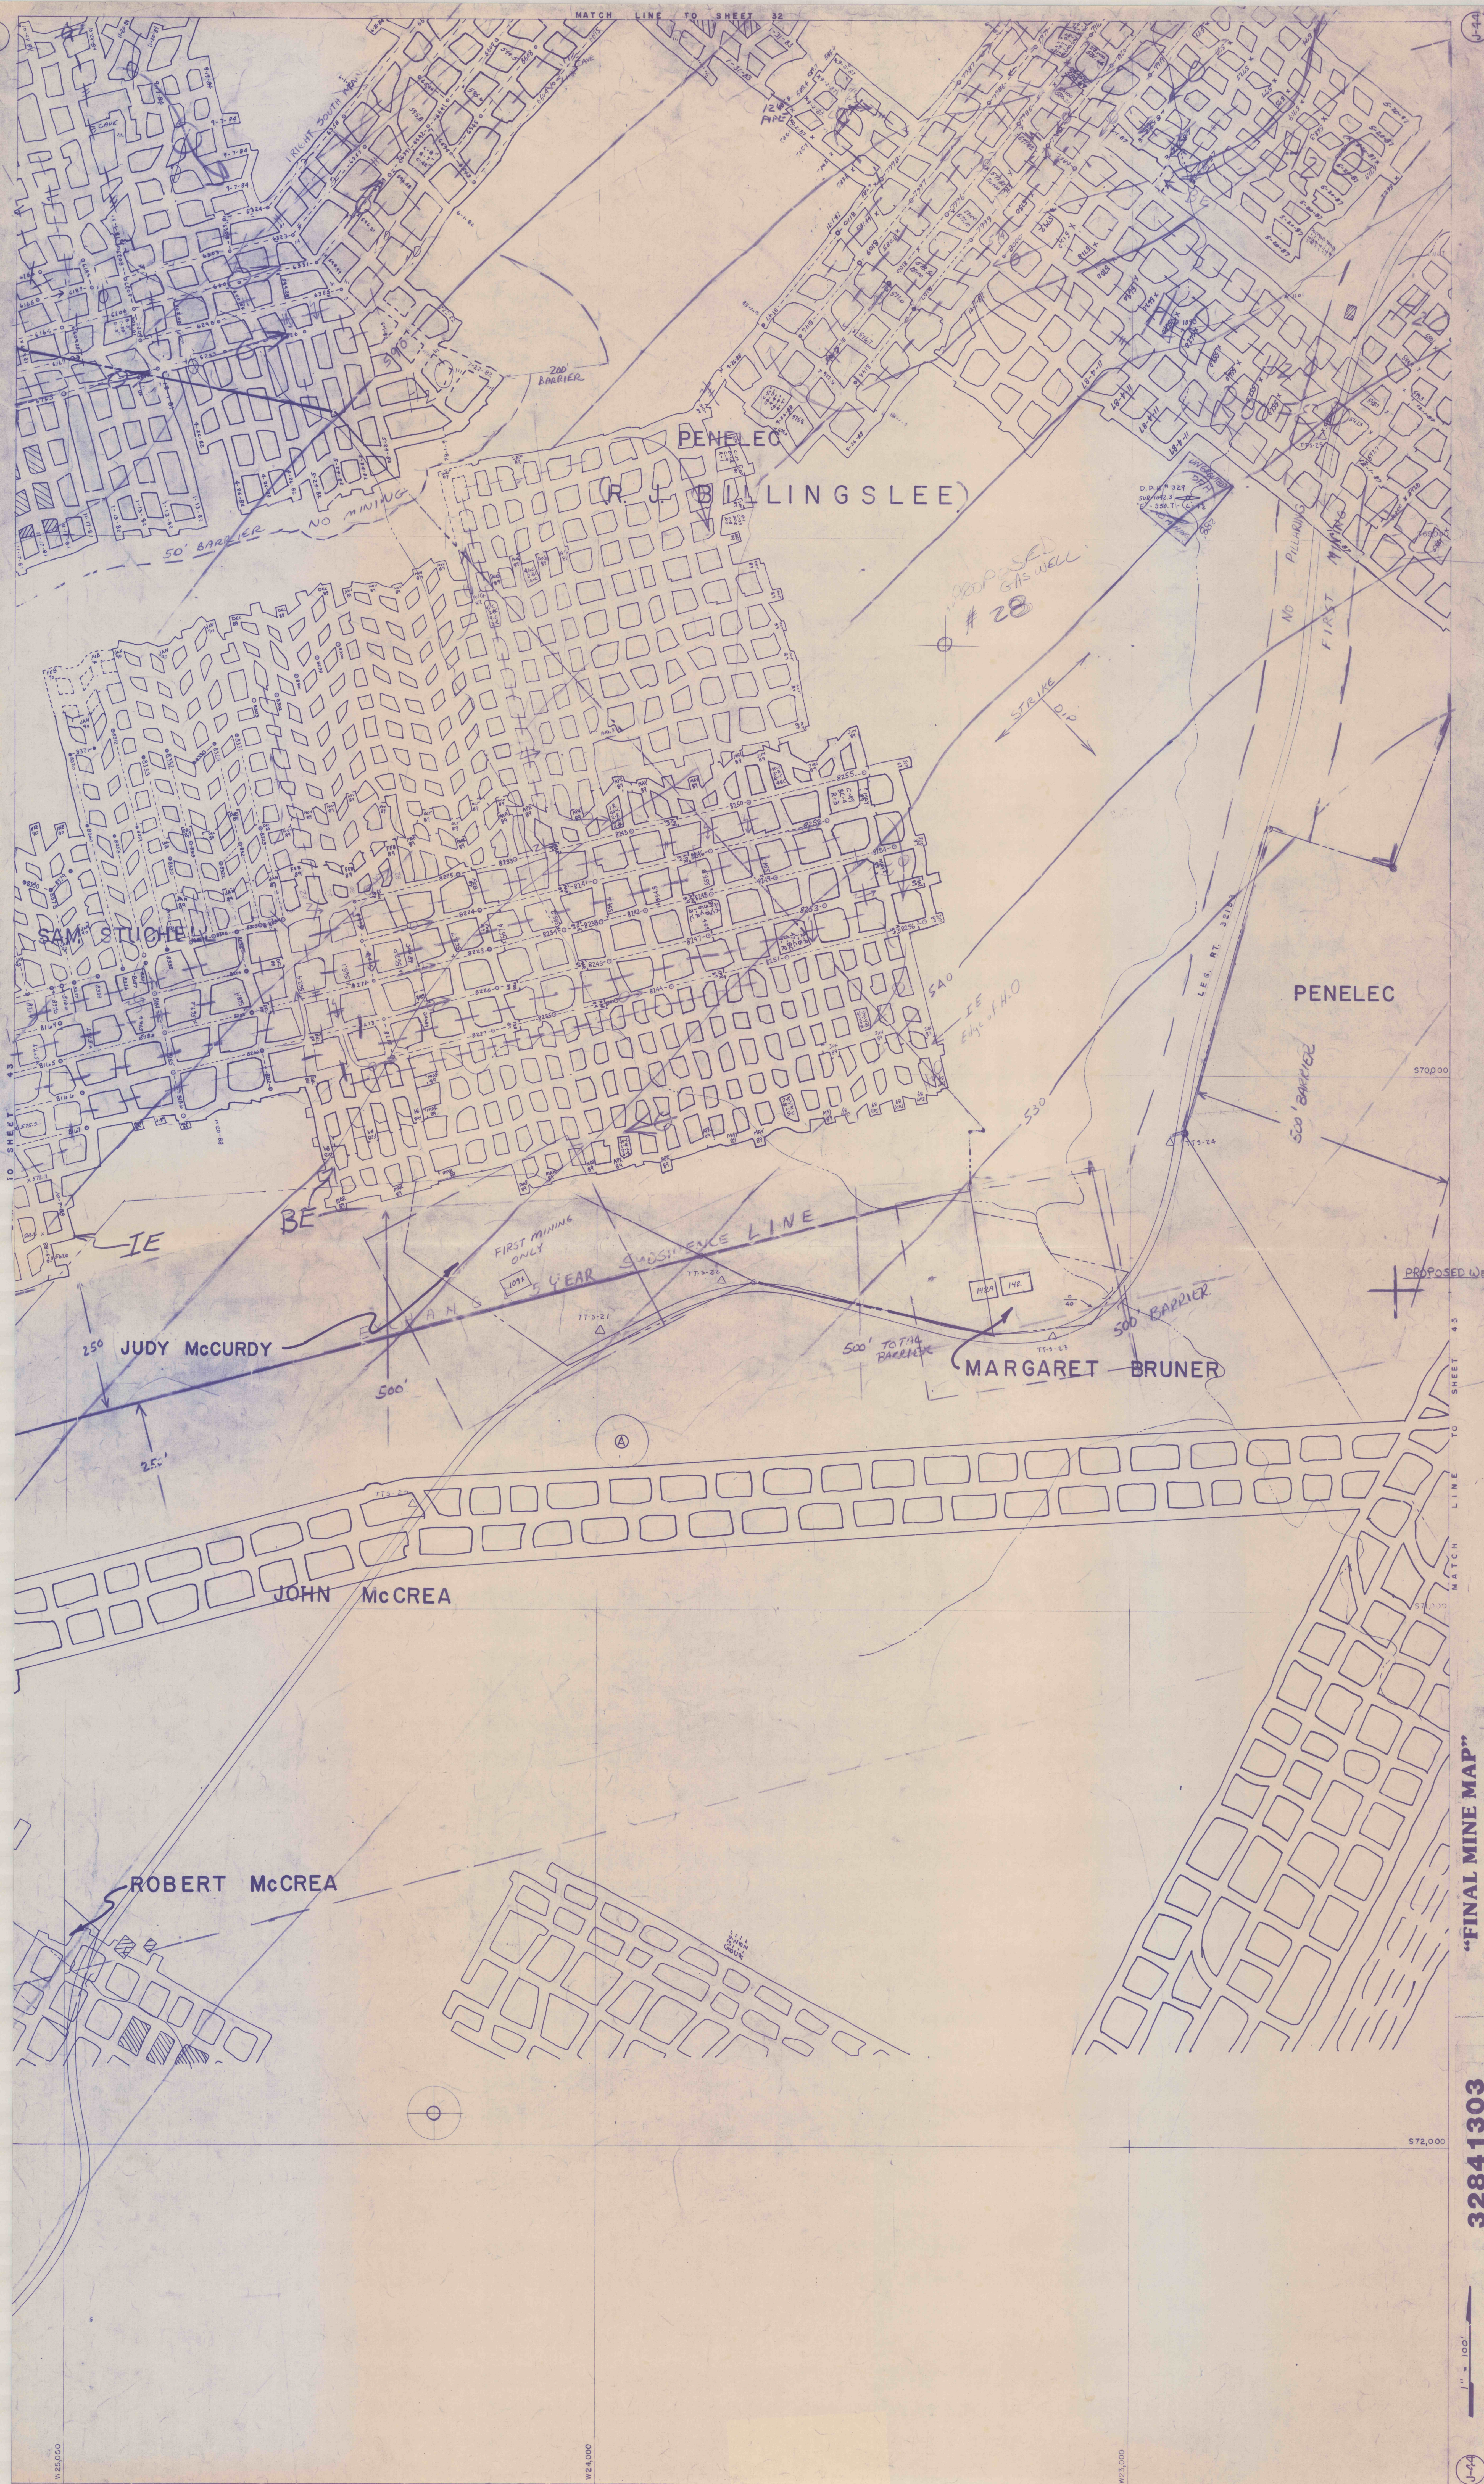

"FINAL MINE MAP"

3284 1303

1" = 100'

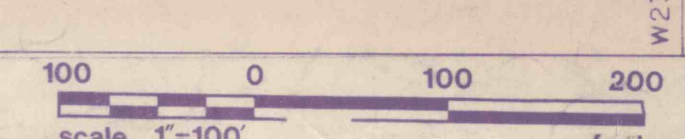

LUCERNE NO. 6 MINE - HELVETIA COAL CO.
 BLACK LICK TWP, INDIANA CO., PA.