


FIT TO 33

MINING COMPLETED
FENCE LINE

L.R. 32163
FIRST MINING

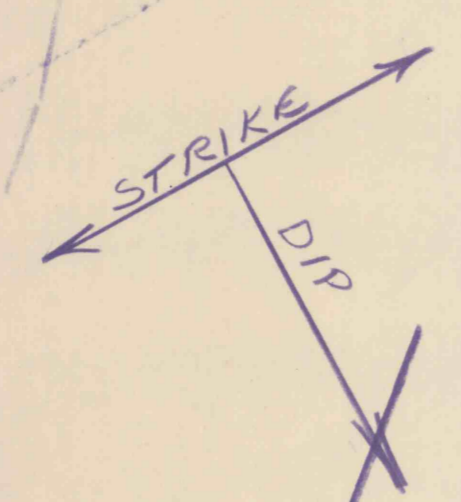

300' BARRIER

PENELEC

569,000

PENELEC

HEEN MINE SLOPE

RETRACTED

(C CRIBBS)

TELEPHONE CABLE

570,000

MINED OUT


571,000

572,000

W 22,000

W 21,000

W 20,000

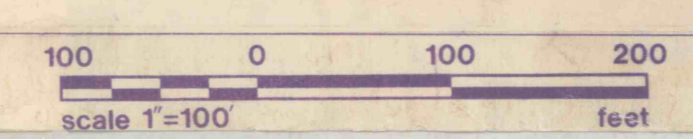

LUCERNE NO. 6 MINE-HELVETIA COAL CO
BLACKLICK TWP., INDIANA CO.

32841303

"FINAL MINE MAP"

1" = 100'