




J-40

FINAL MINE MAP

32841303

J-40

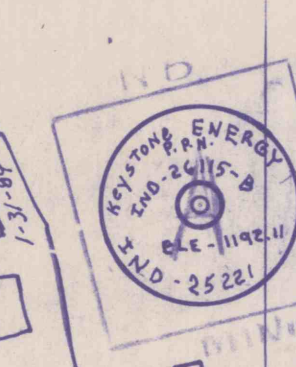

J. H. SWEASEY

ROBERT GLENN SMITH

HENRY S. WILLIAMS

T. F. WILLIAMS

MARK FRITZ
(J. K. MIKESELL)

VERNON E. HILL

STRIKE

DIP

5 YEAR SUBSIDENCE LINE

300 GAL ISLAND
530 DC

250' BARREX