


MATCH LINE TO SHEET 10

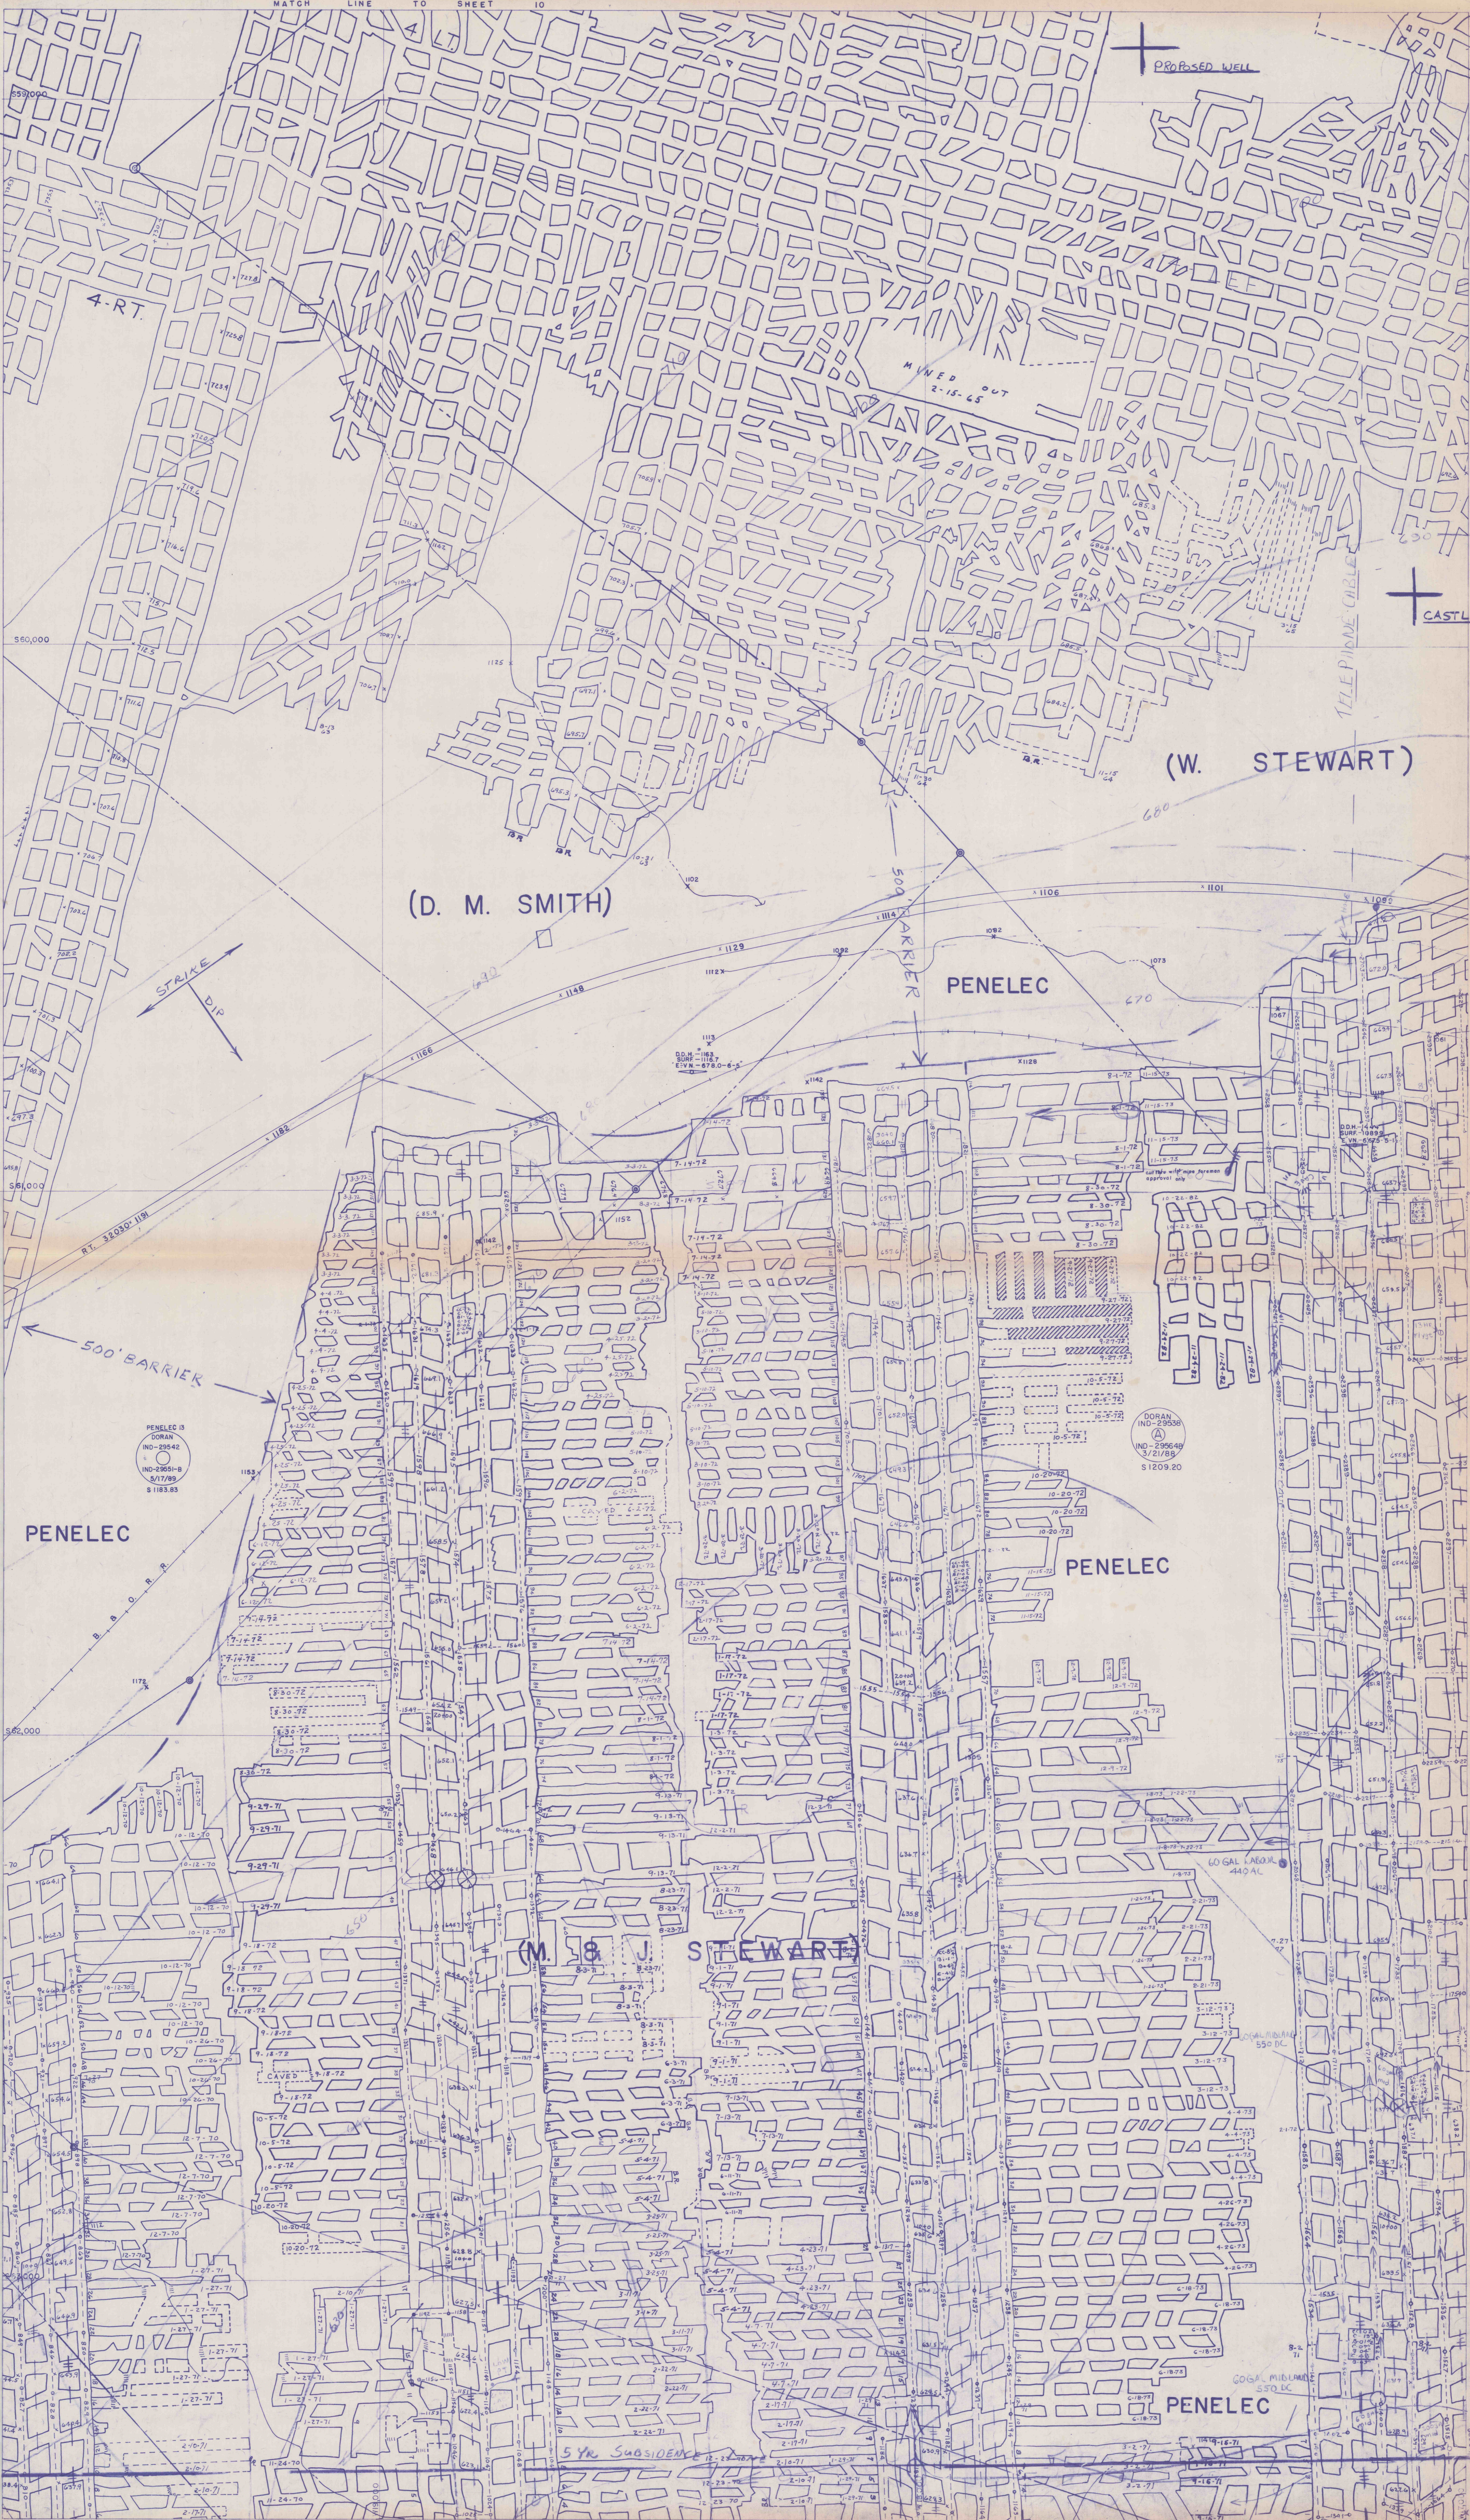

"FINAL MINE MAP"