



LUCERNE #3 "E" SEAM INACTIVE

(S. E. JOHNSTON)

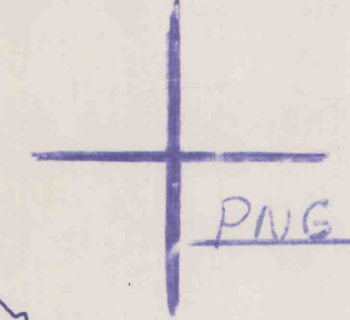

(J. M. JOHNSTON)

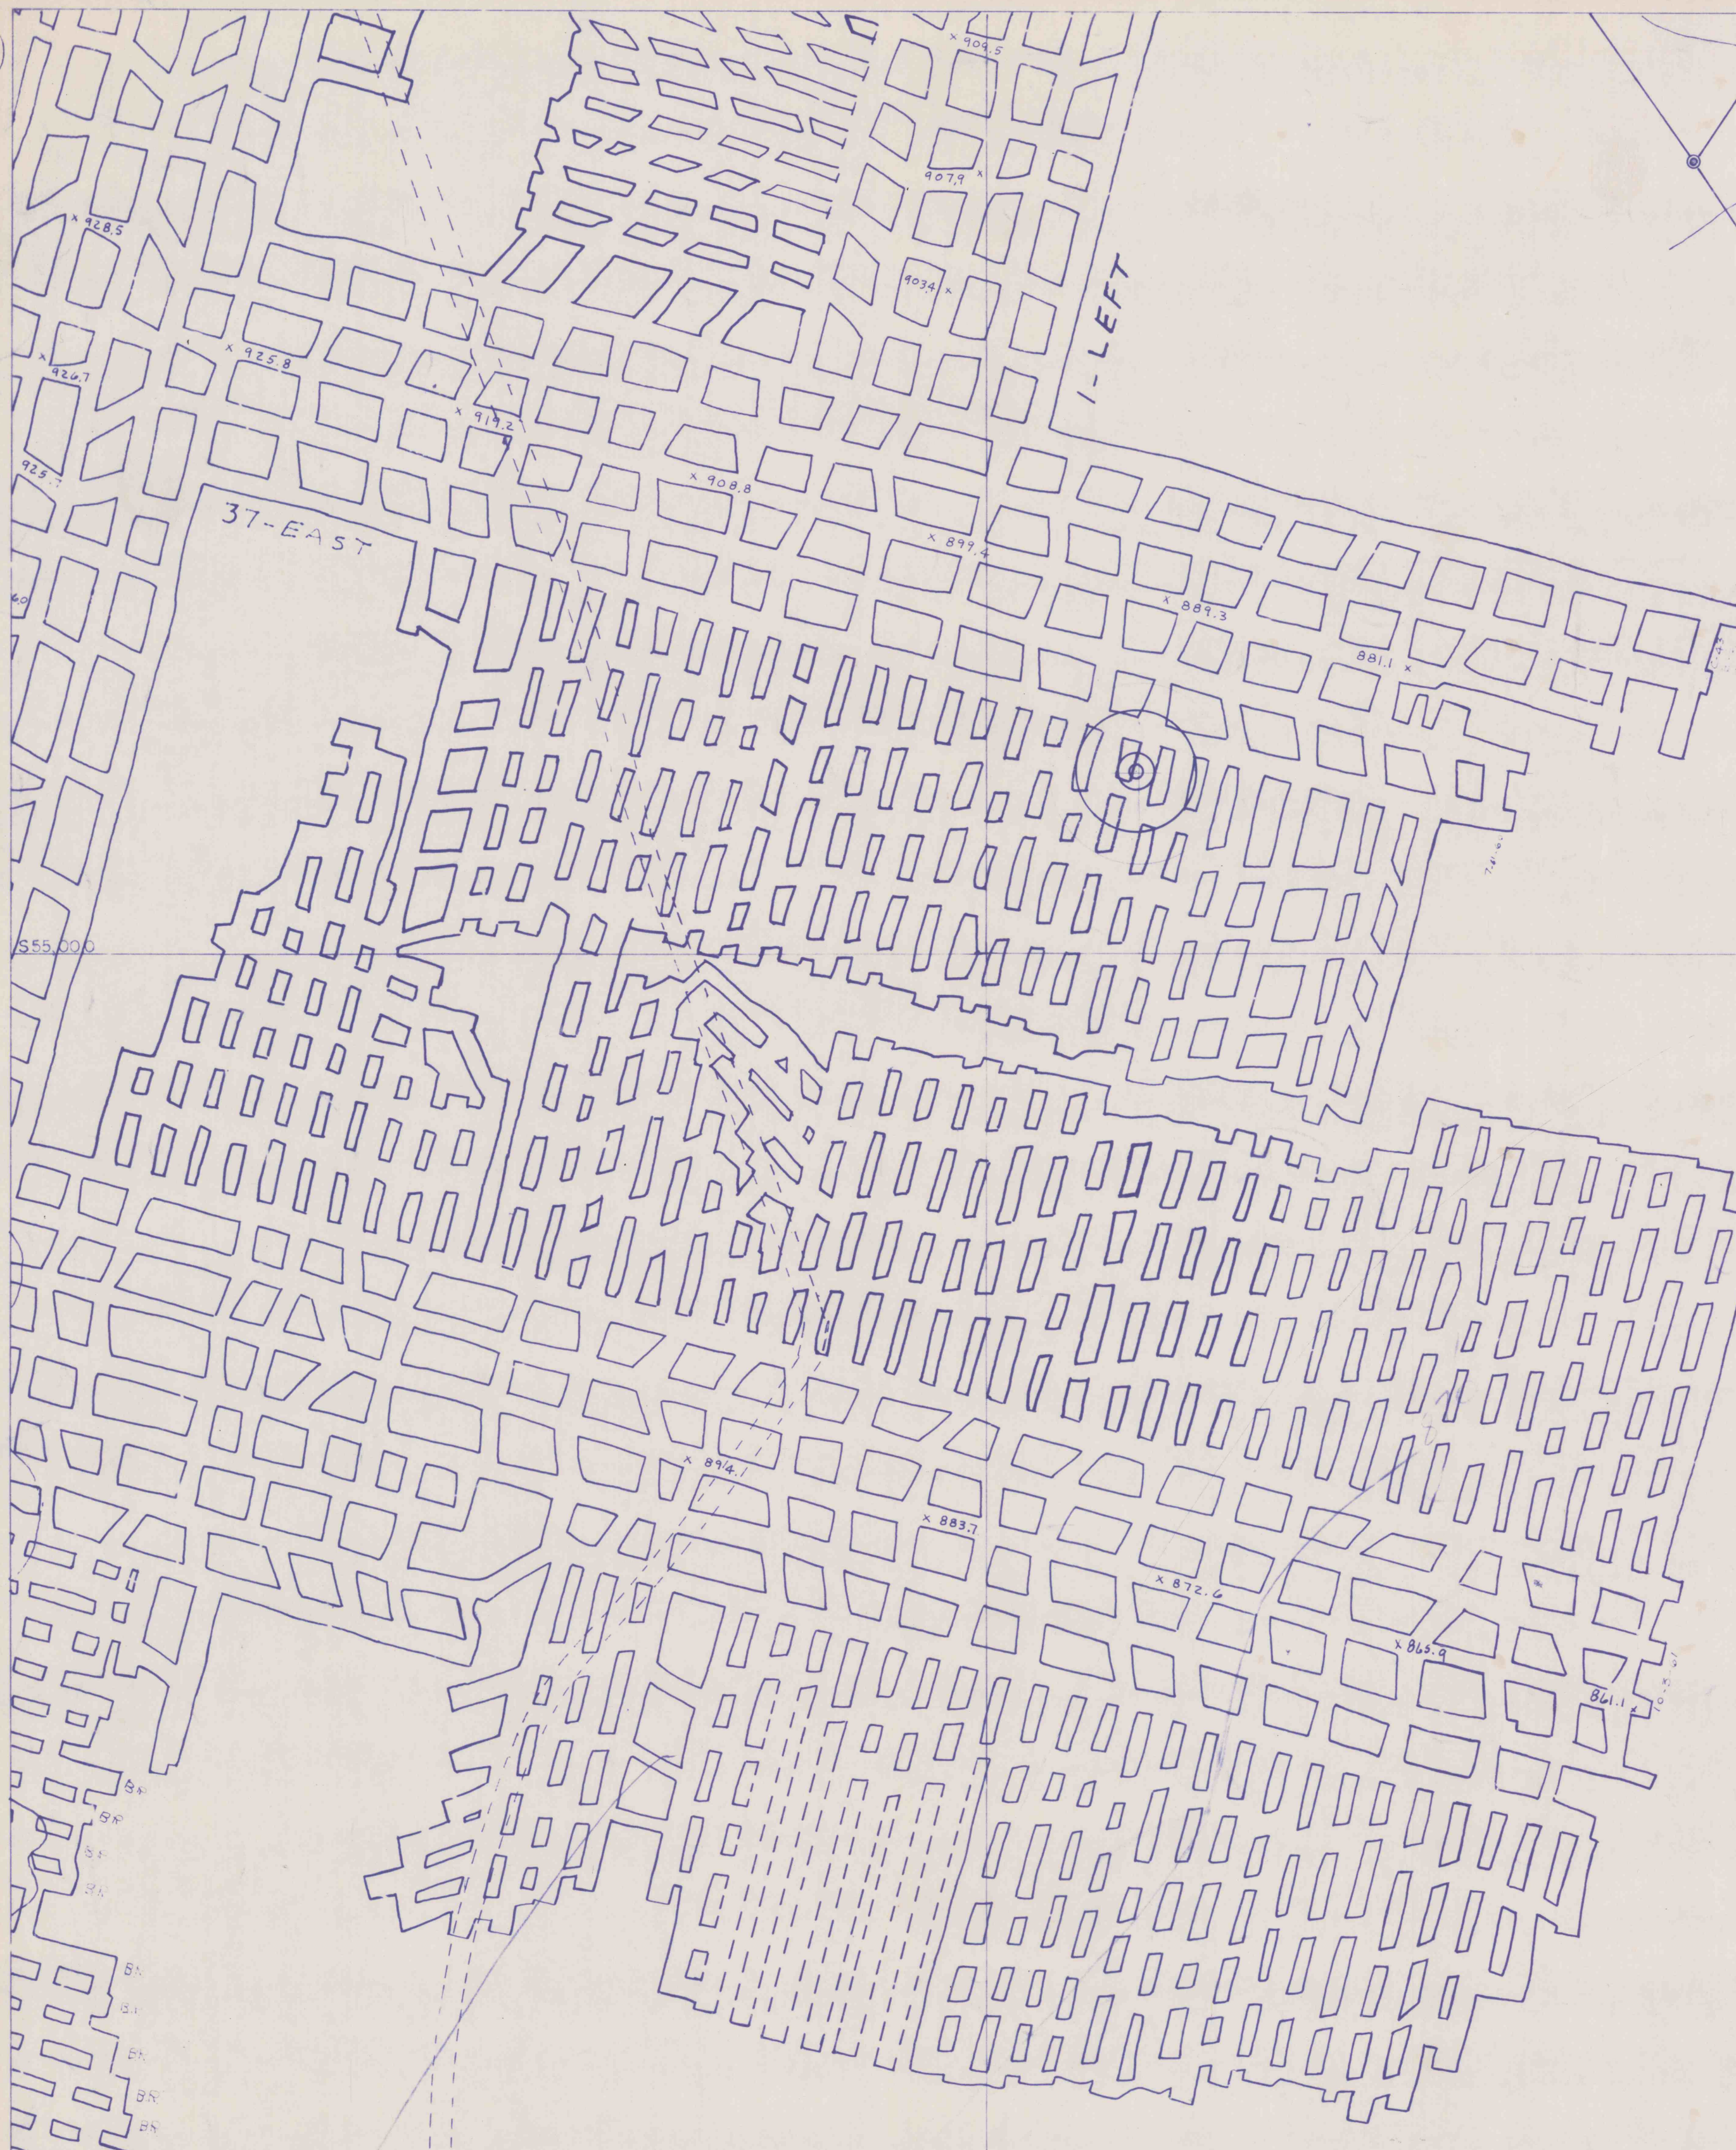

MICHAEL DINARDO

THOMAS DODSON

ALBERT PRIBESH


MARIE MINOR

JOSEPH POLINSKY

LAWRENCE FABIN

(A. KINNAN)
ERNEST PIERCE

TIDE SPORTSMEN CLUB

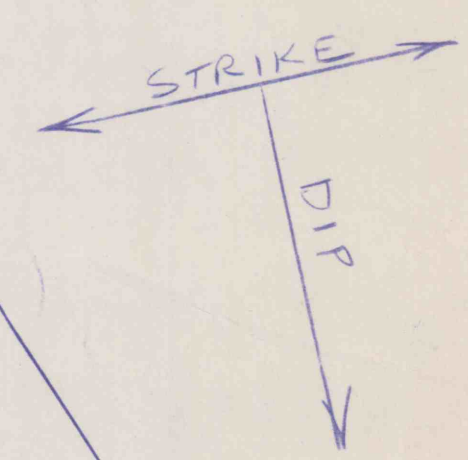

MATCH LINE TO SHEET 10

1" = 100'