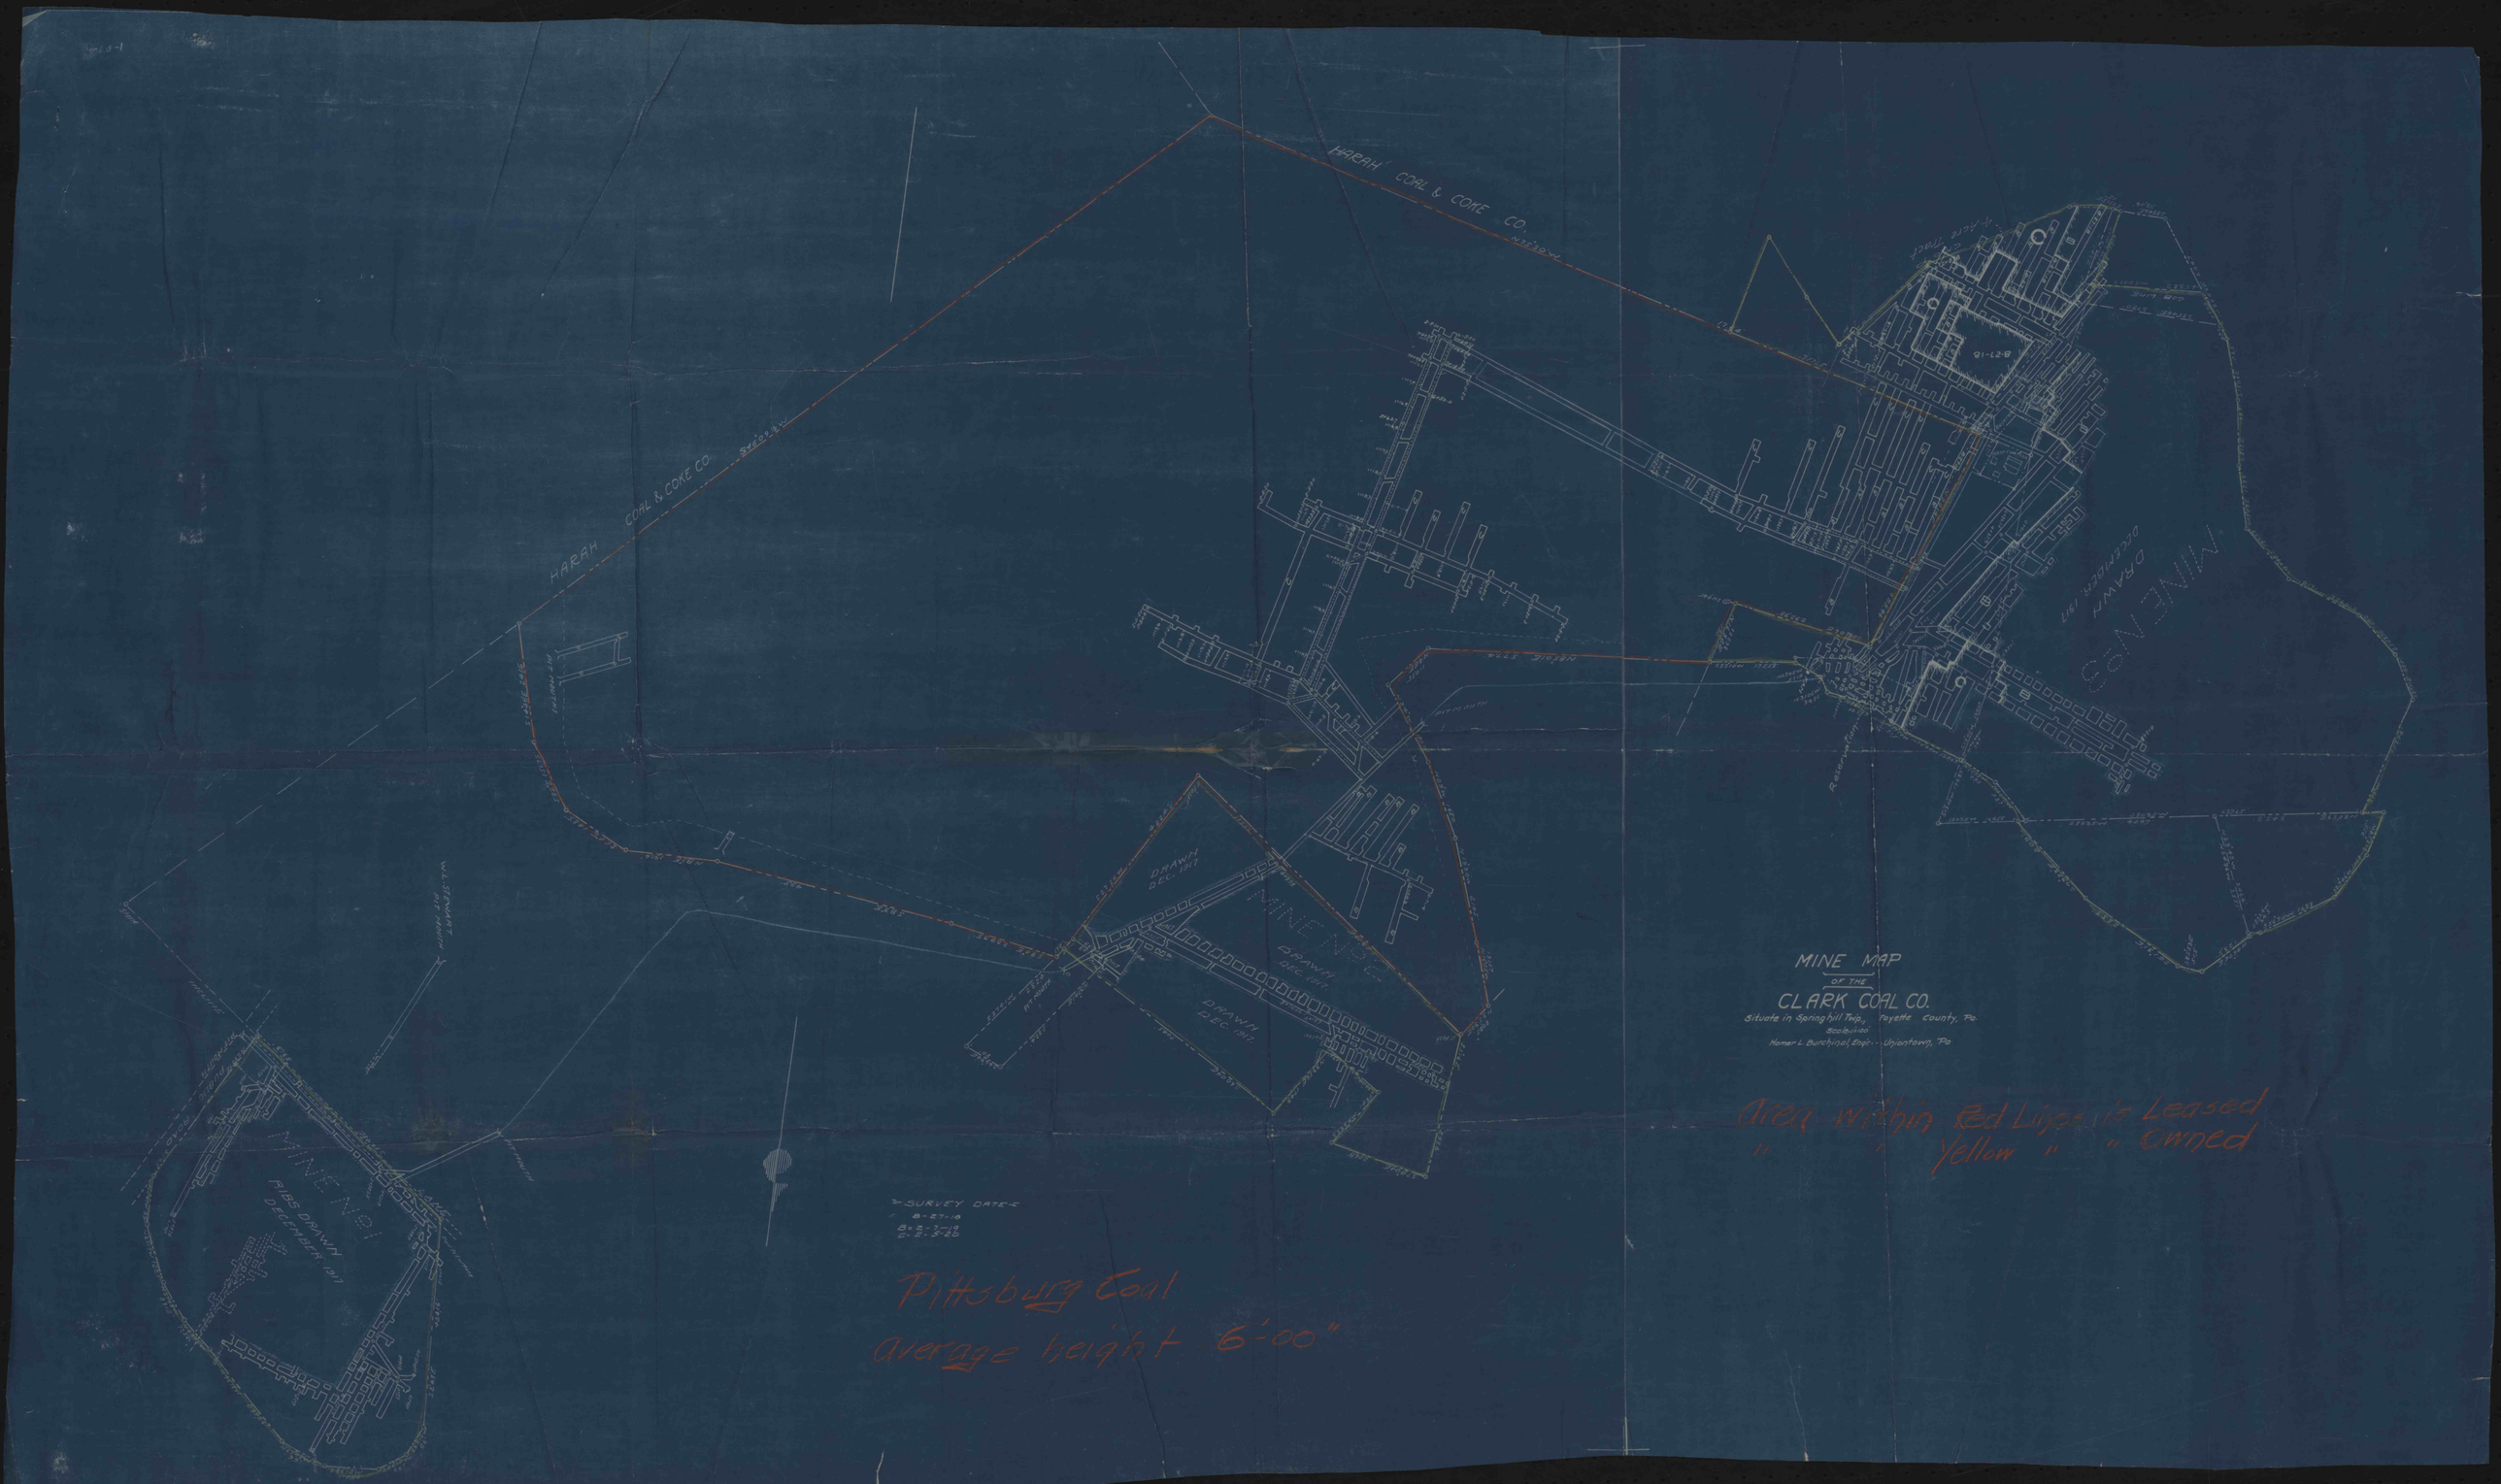
HARAH COAL & COKE CO.
HARAH COAL & COKE CO.
MINE No 3
DRAWN DECEMBER 1917
MINE No 2
DRAWN DEC. 1917
MINE No 1
RIBS DRAWN DECEMBER 1917
SURVEY DATE
8-27-18
B-2-7-19
C-2-5-20
MINE MAP
OF THE
CLARK COAL CO.
Situate in Springhill Twp., Fayette County, Pa.
Scale 1:100
Homer L. Burchinal, Engr. - Uniontown, Pa
Area within Red Lines is Leased
" " Yellow " " Owned
Pittsburg Coal
average height 6'-00"