No. 12

MAP OF

SONMAN RUN COAL CO.

MINE IN 'D' SEAM

ON LANDS OF

CAMBRIA MINING & MANUFACTURING CO.

SONMAN, CAMBRIA CO., PA.

SCALE 1"=100'
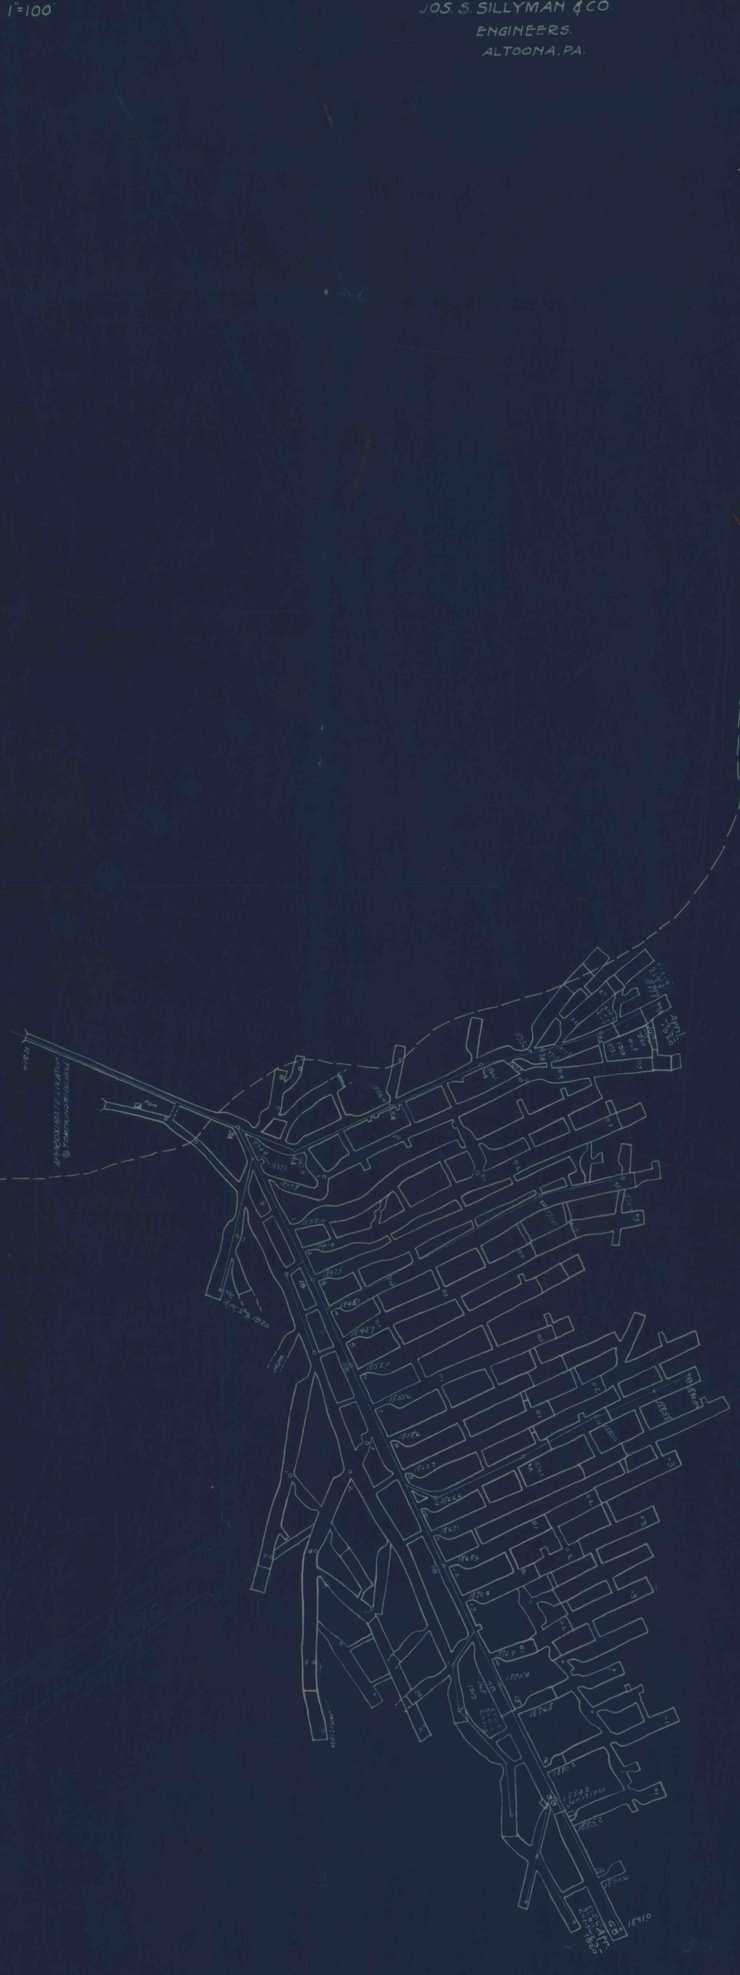
JOS. S. SILLYMAN & CO.
ENGINEERS.
ALTOONA, PA.