




EMELINE T. FINLEY
N. 7000

Wm. Mc SHANE
N. 6000

CINCINNATI MINE

SCALE 1" = 500'

Survey 7-28-03

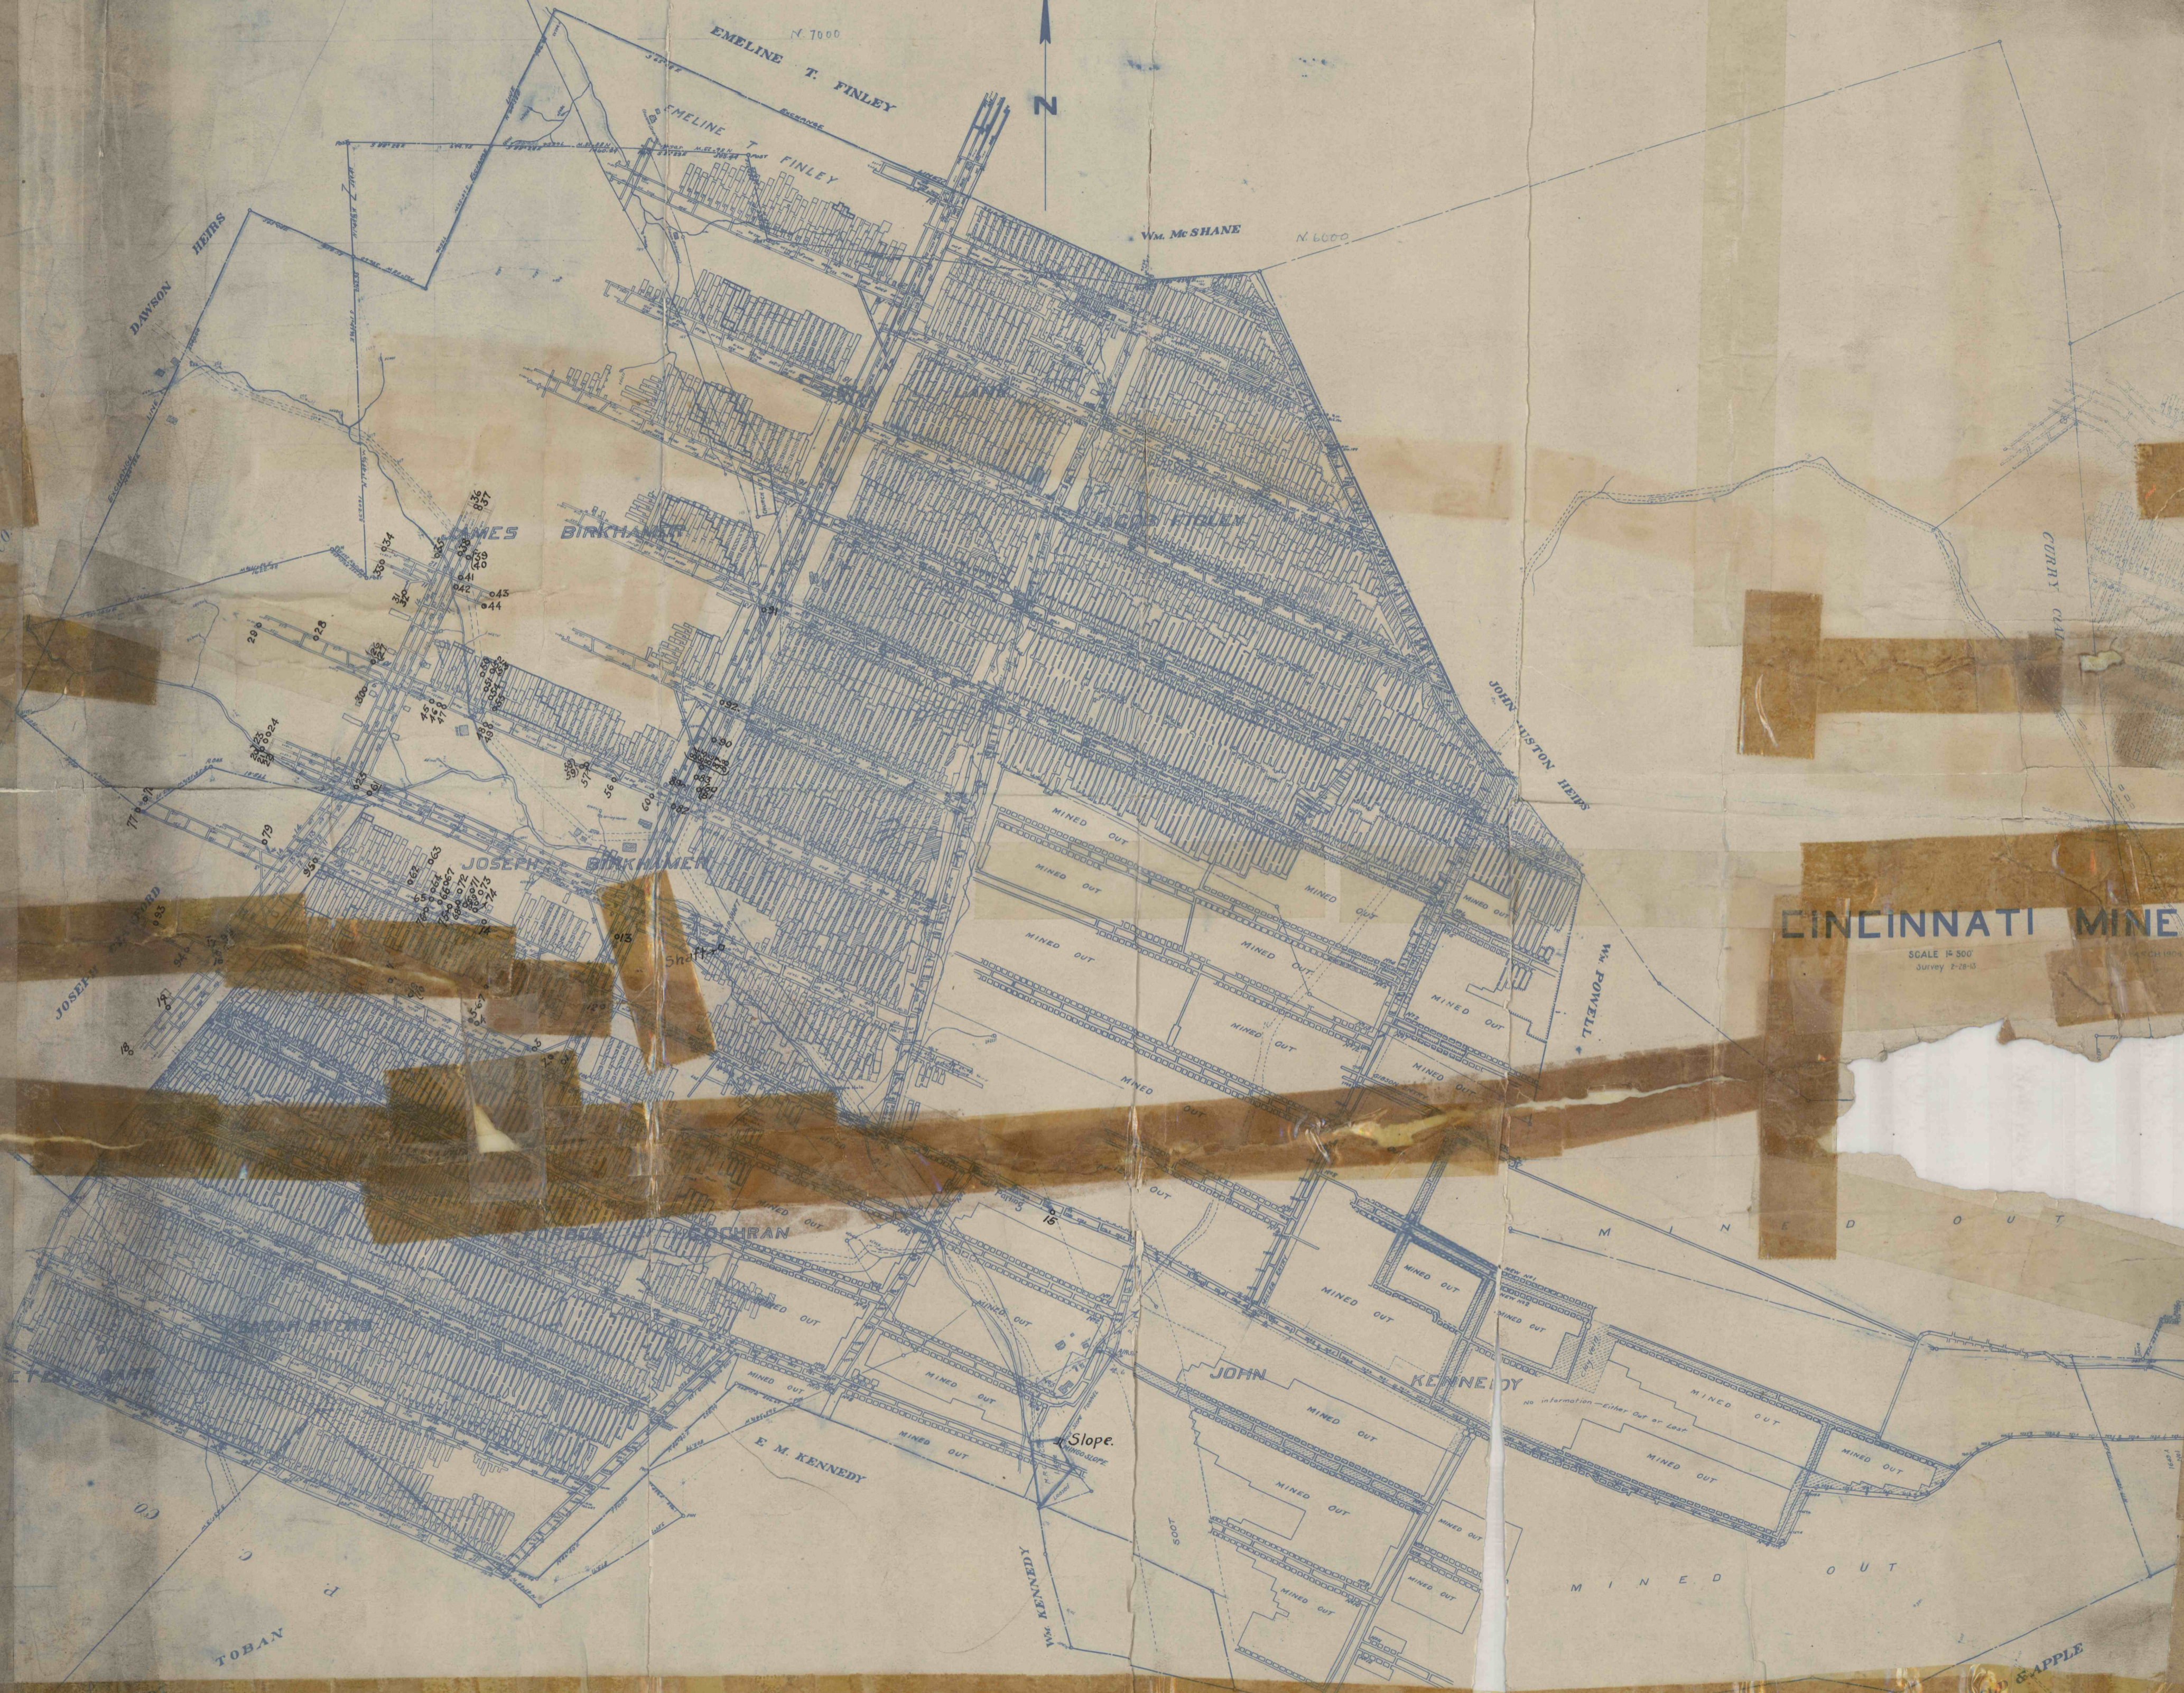

TOBAN

DUNN & APPLE