


Doverspike Bros Coal Co.  
Ramseytown Mine  
Knox Twp., Jefferson Co.  
MSHA I.D. No. 36-08487  
Final Seal Location  
Portion of sheet 1  
Scale: 1" = 100'  
CMAP. No. 33941301

RECEIVED  
FEB 12 1999  

PROPOSED  
CLAY SEALS

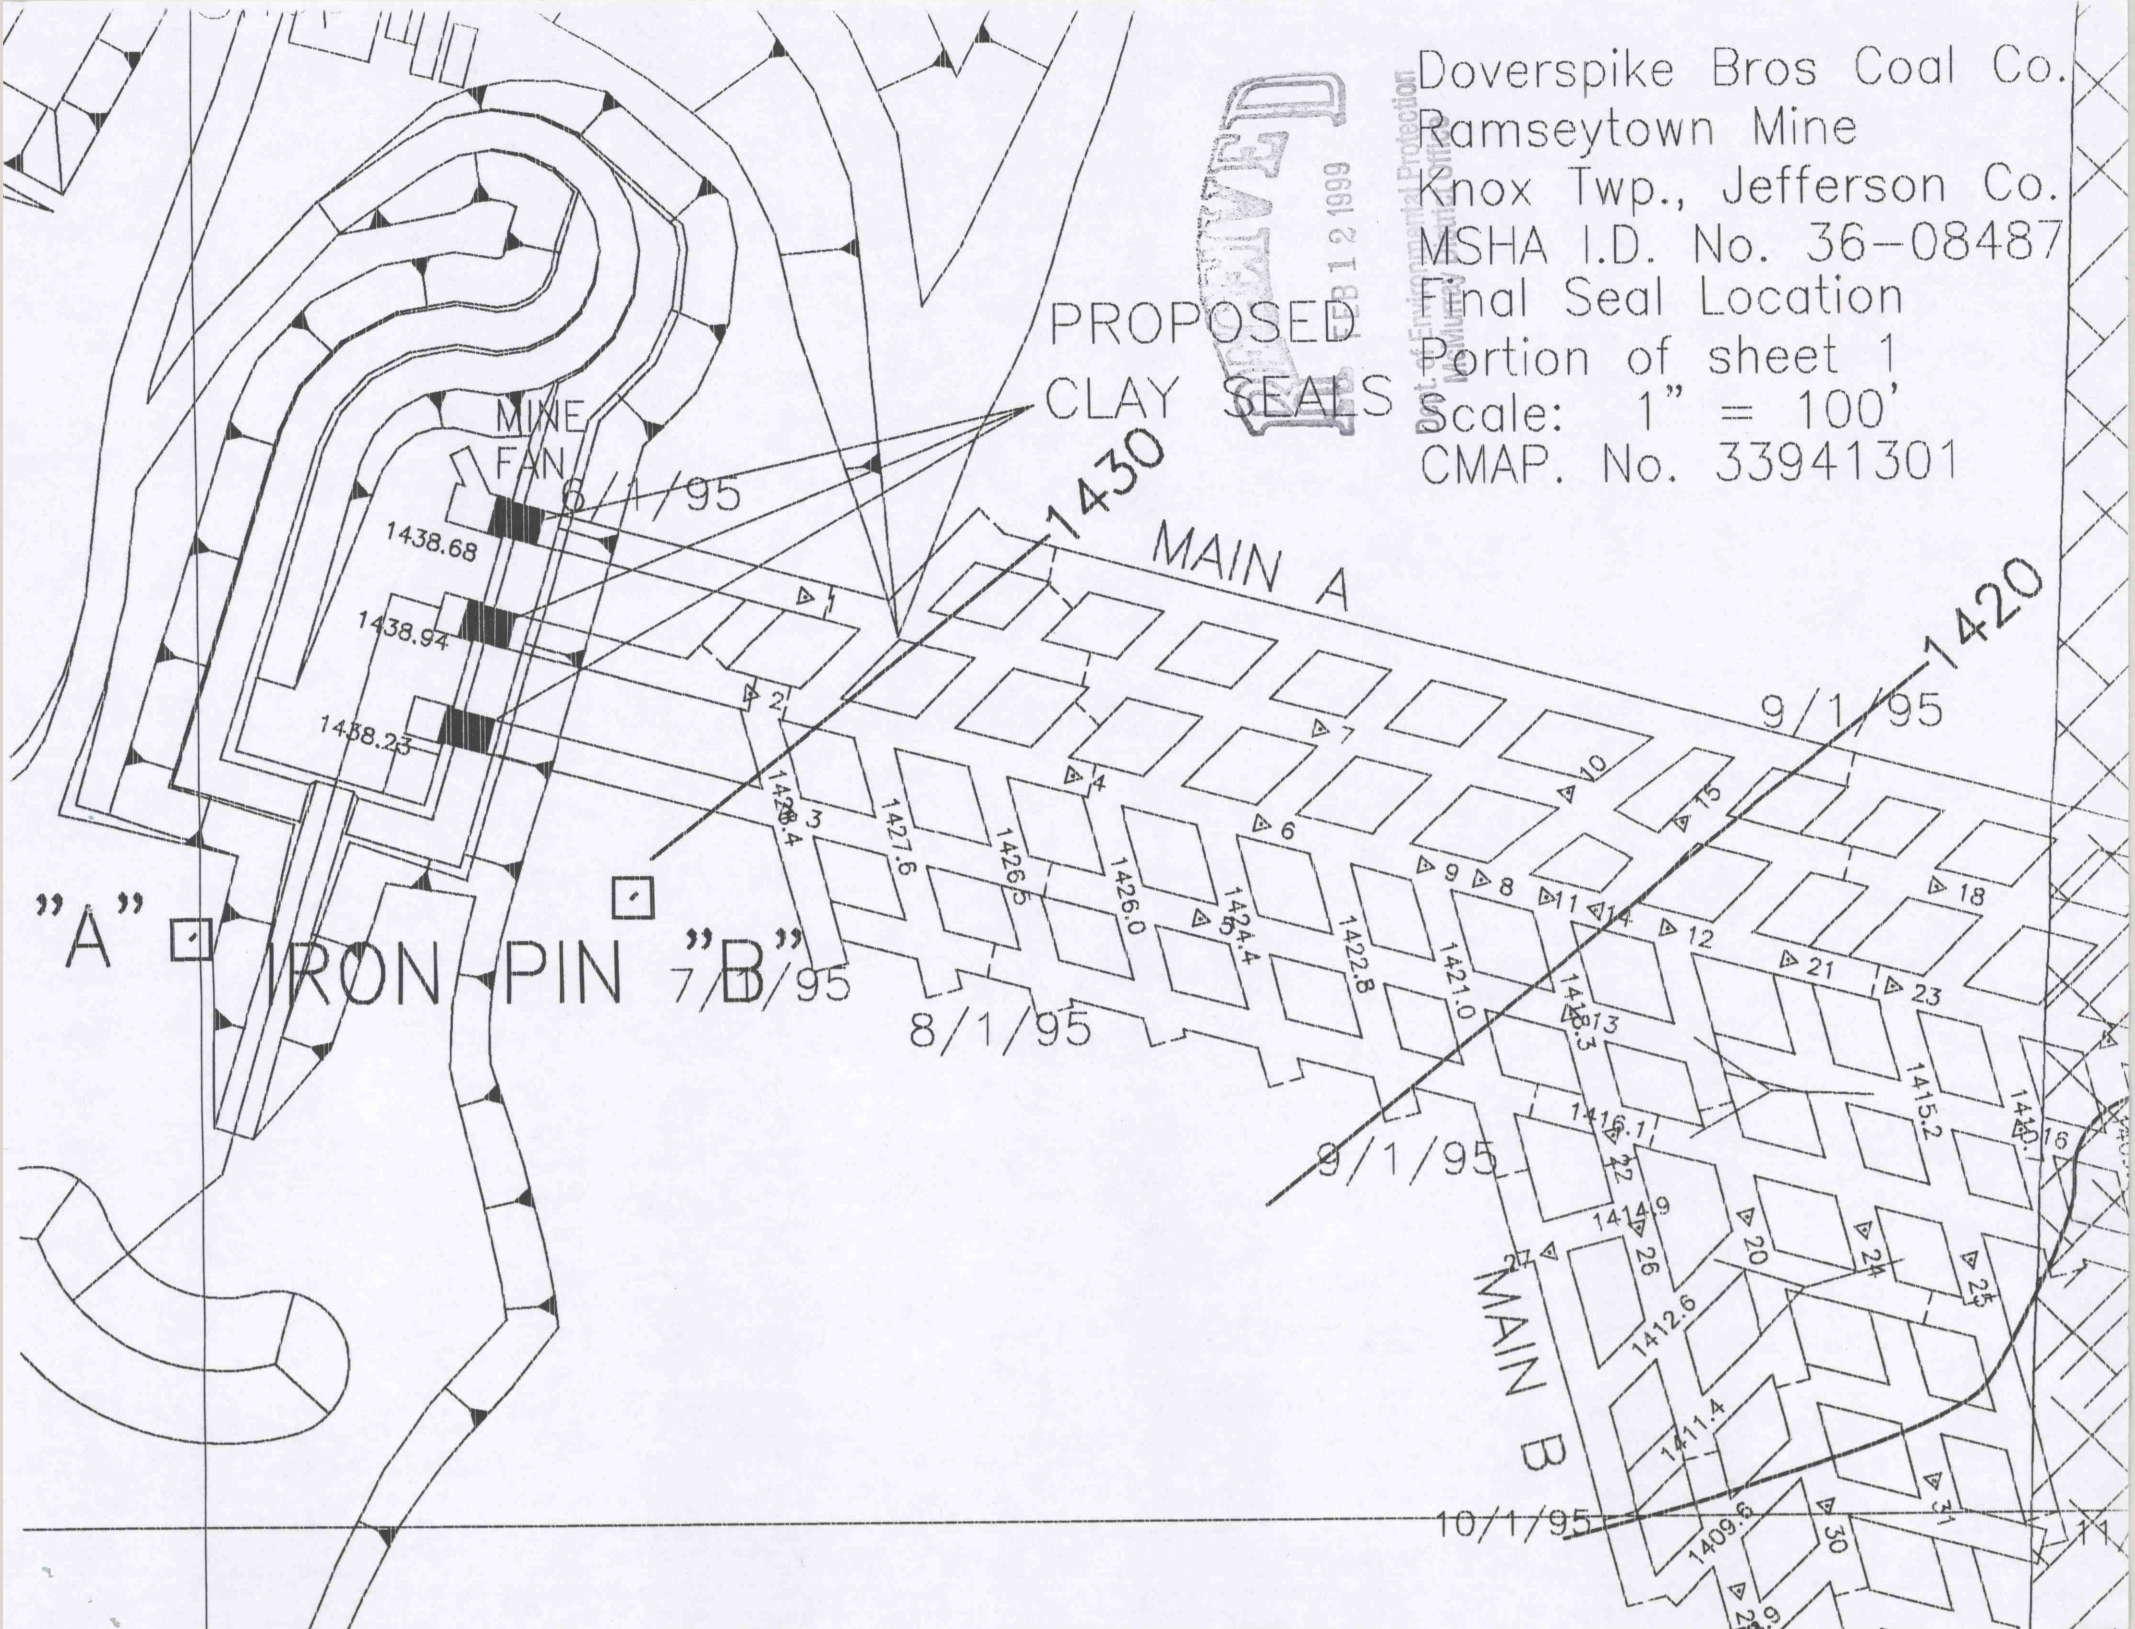

"A" IRON PIN "B"