



10-1-56


H-57

H-57

249  
RIGHT  
PLATE

585° 36' F

447.76'

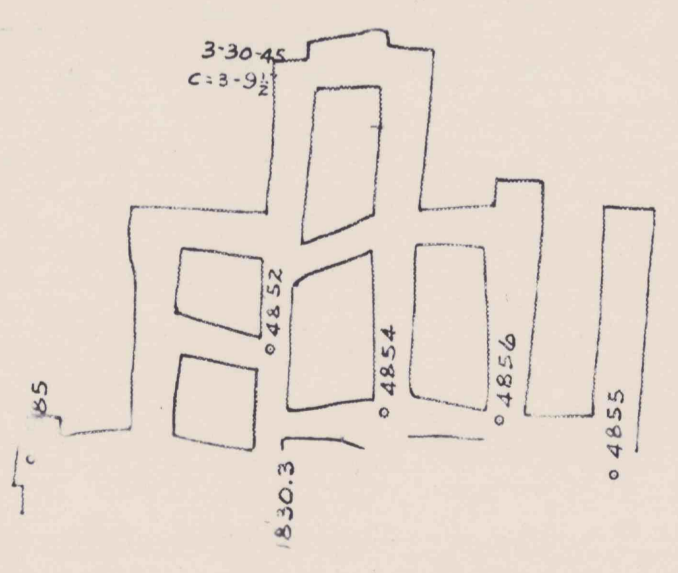

SHEET # 55  
23