

0-5


WATER BARRIER

COLTAR MINE

SHEET-05

000L W

N 5° 16' E

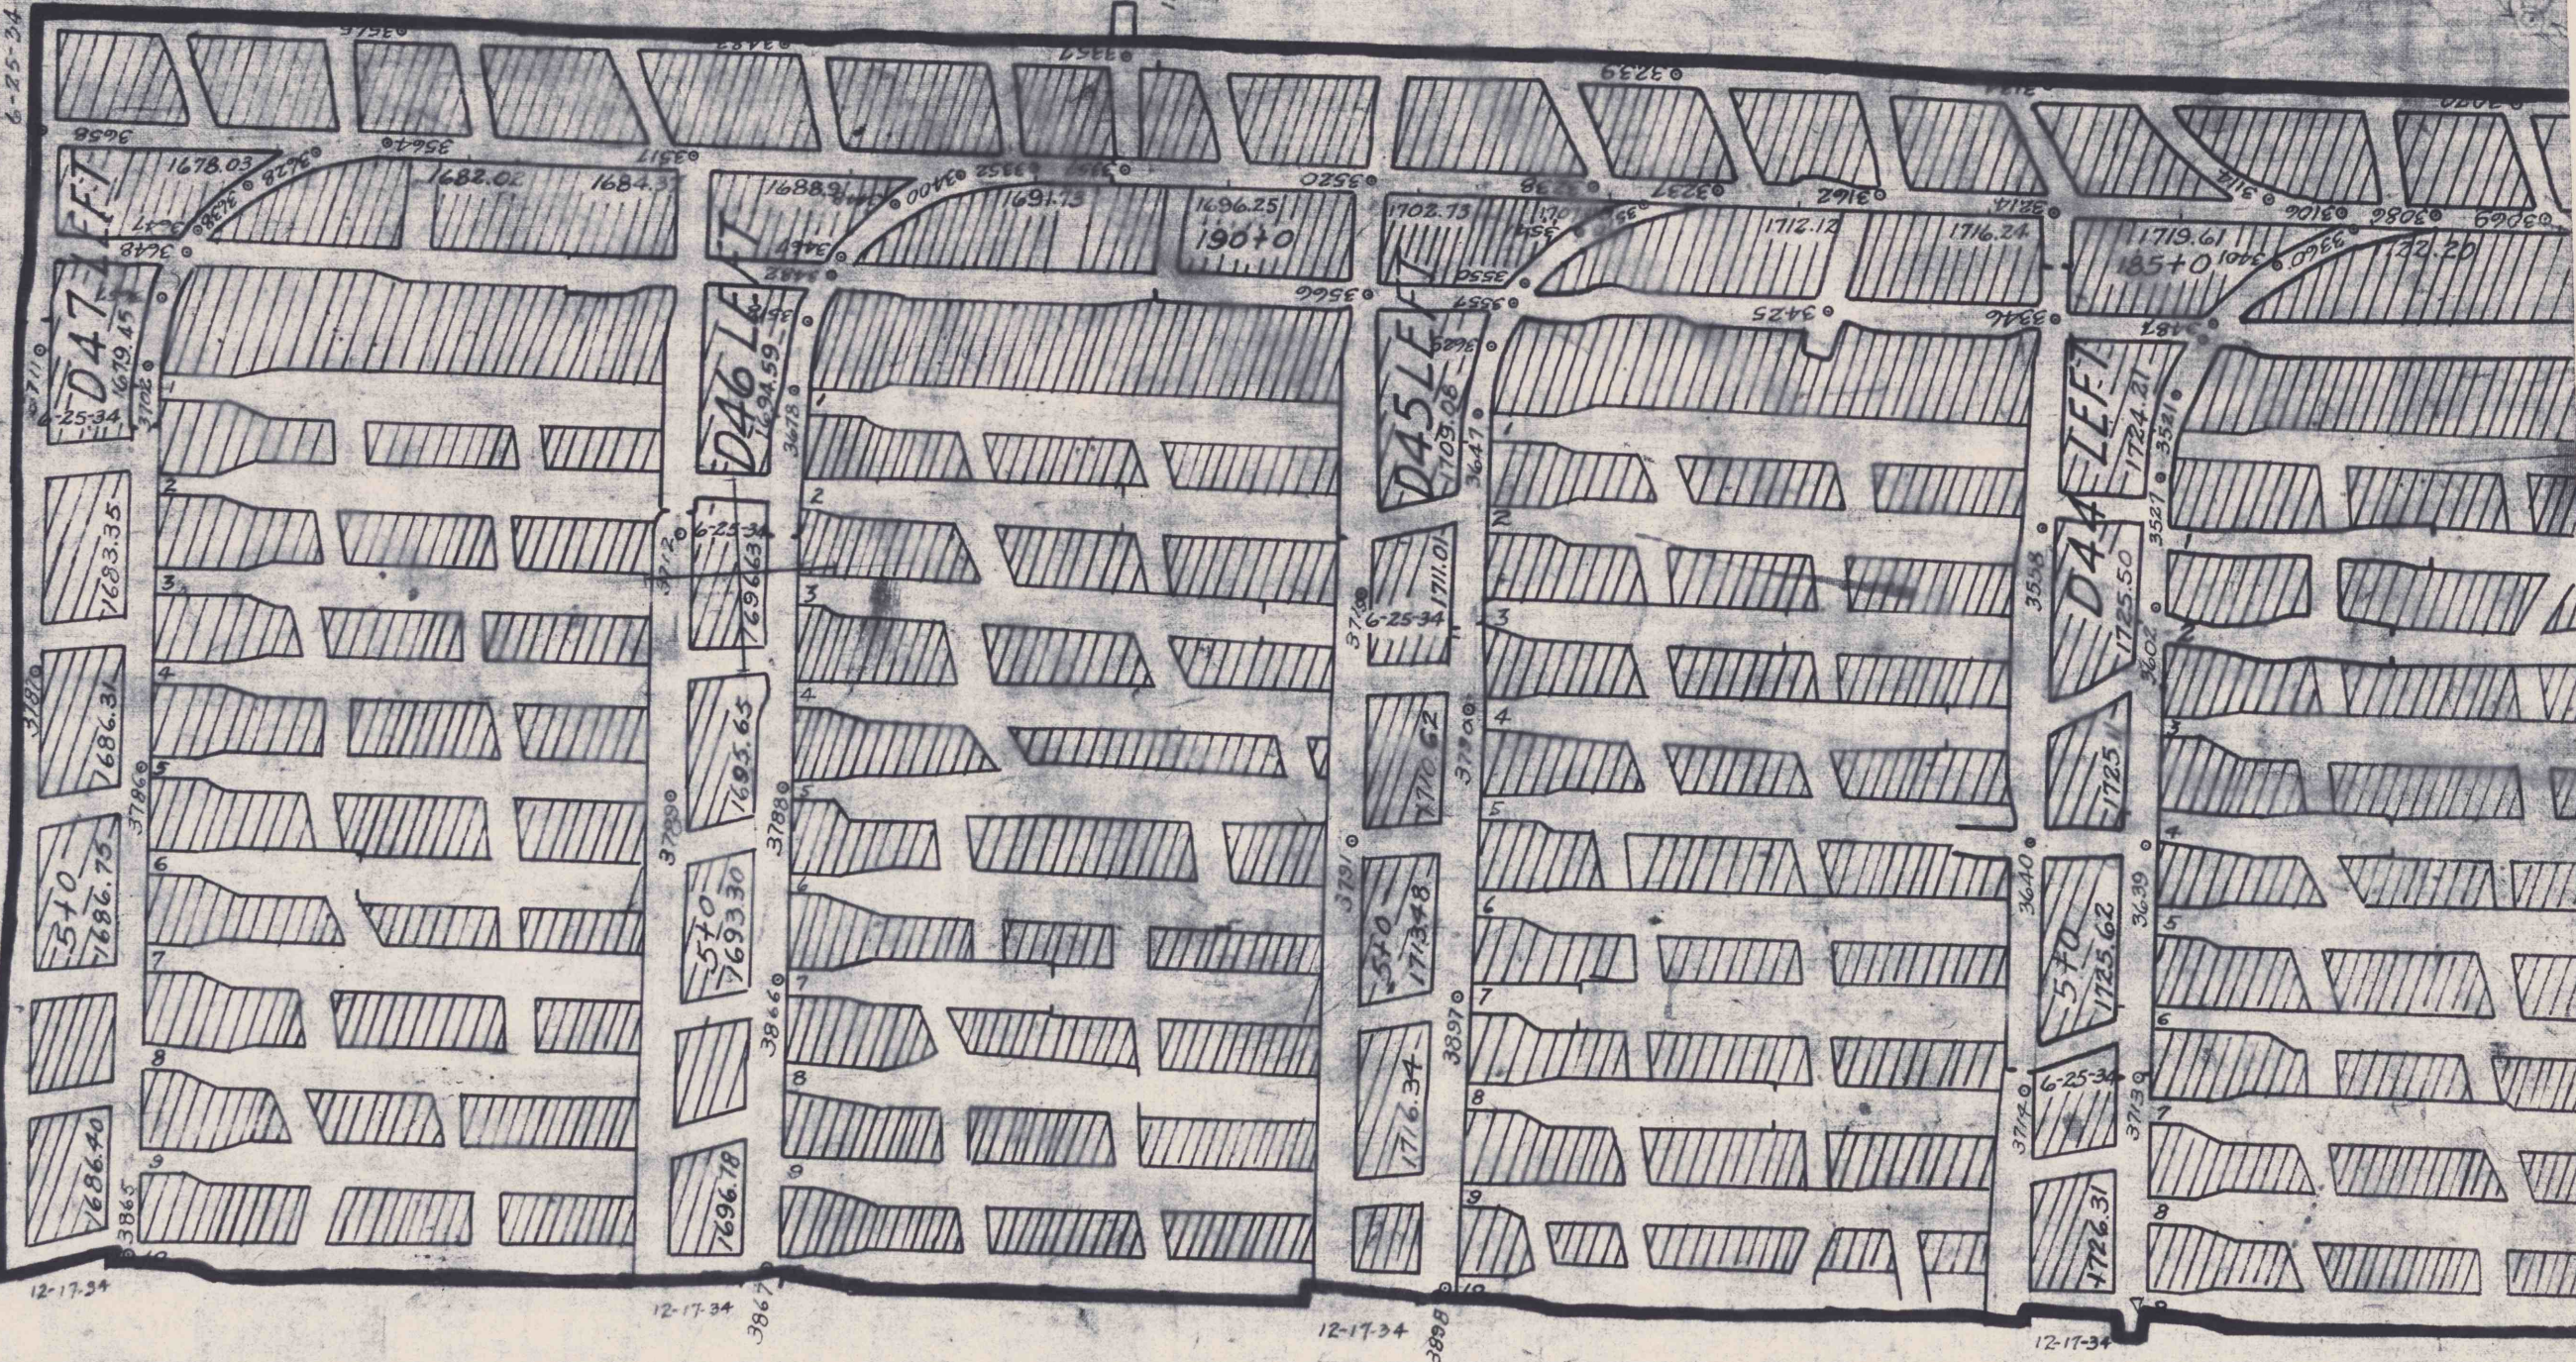


N 34° 00'

779.84

N 84° 52' W

1786.33

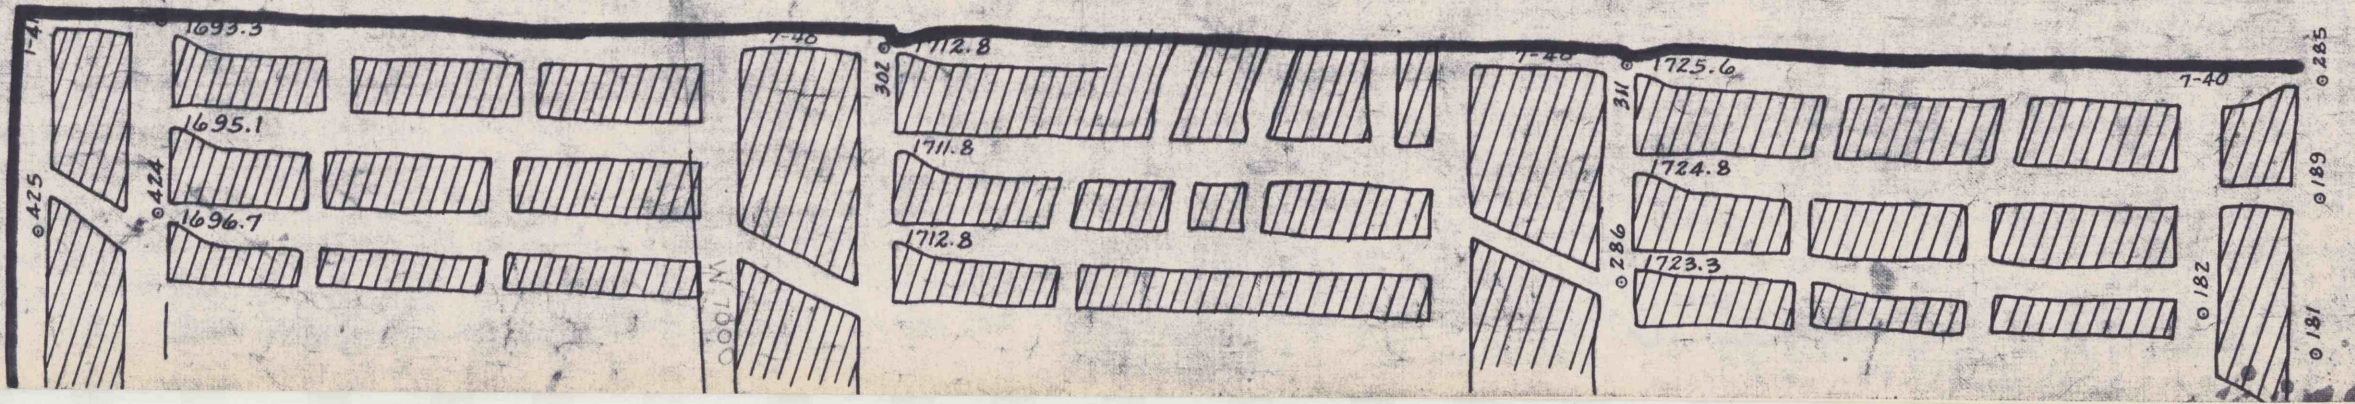

0.425

436

000L W

0.285

0.189

0.181

STAIRING
COOL