

COLVER MINE
SHEET-01

SHEET 0-1

S 5° 58' W

2230.0

1047.05

N 5° 18' E

M 4000




N 33° 00' E

NO RECORD

S 84° 42' E

1000.0

M 5000

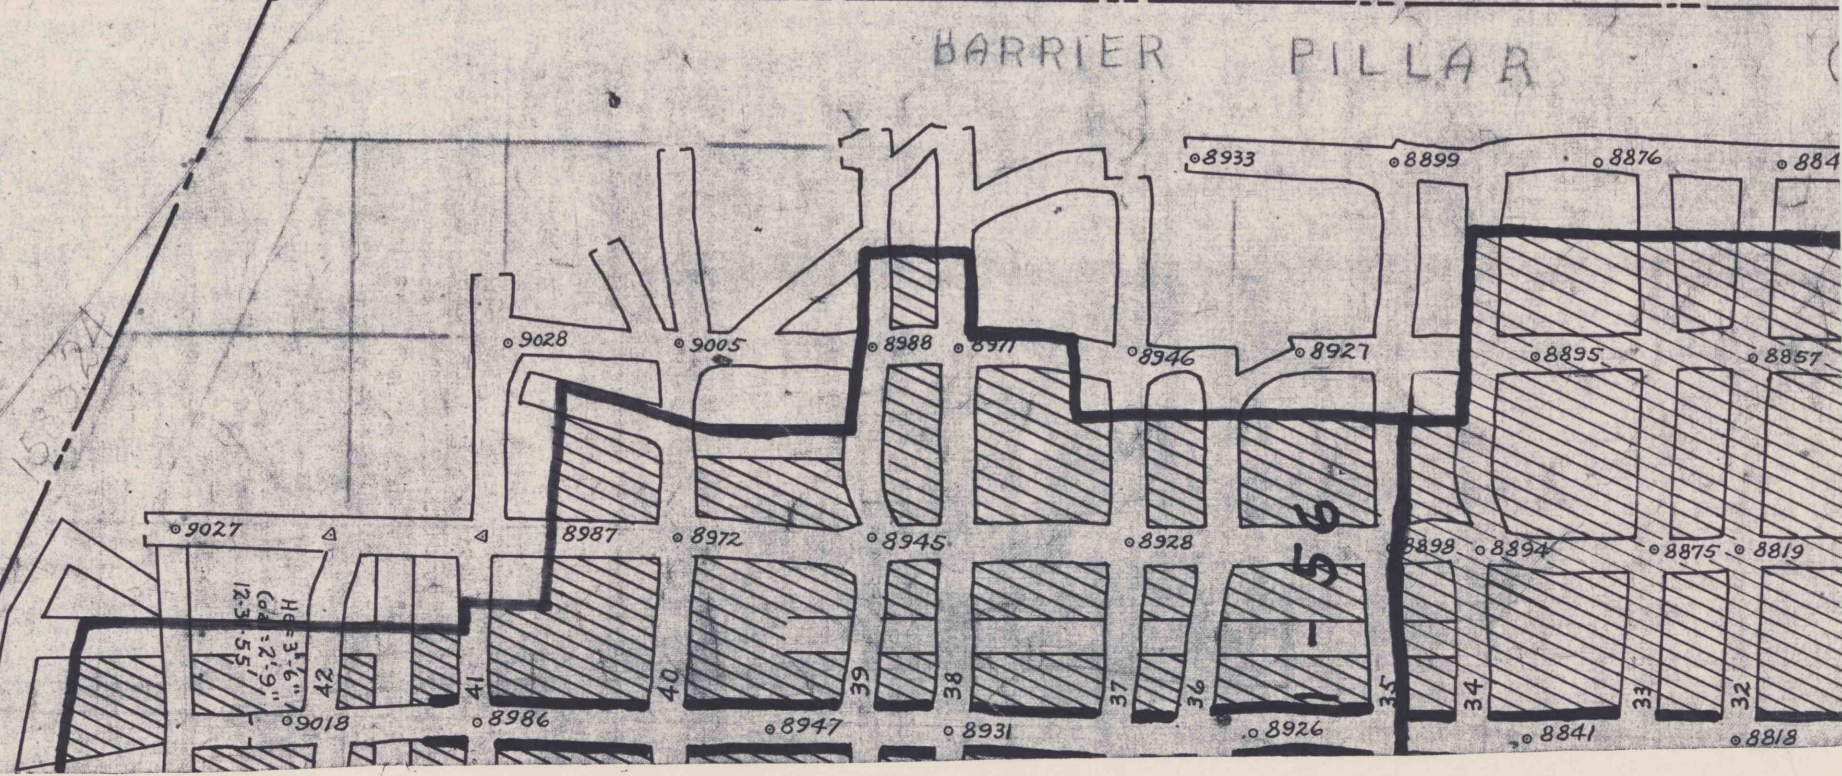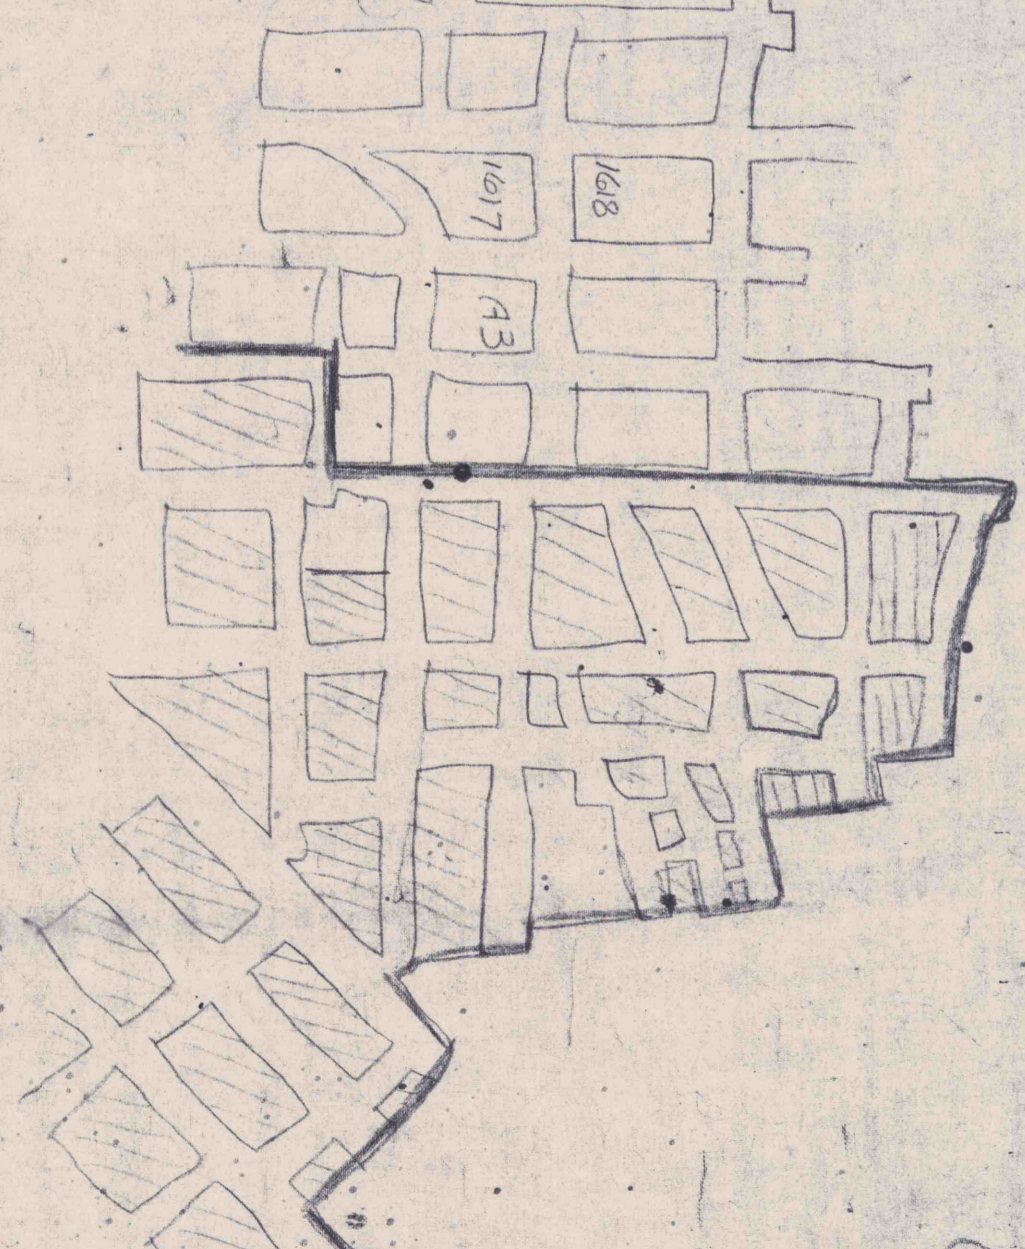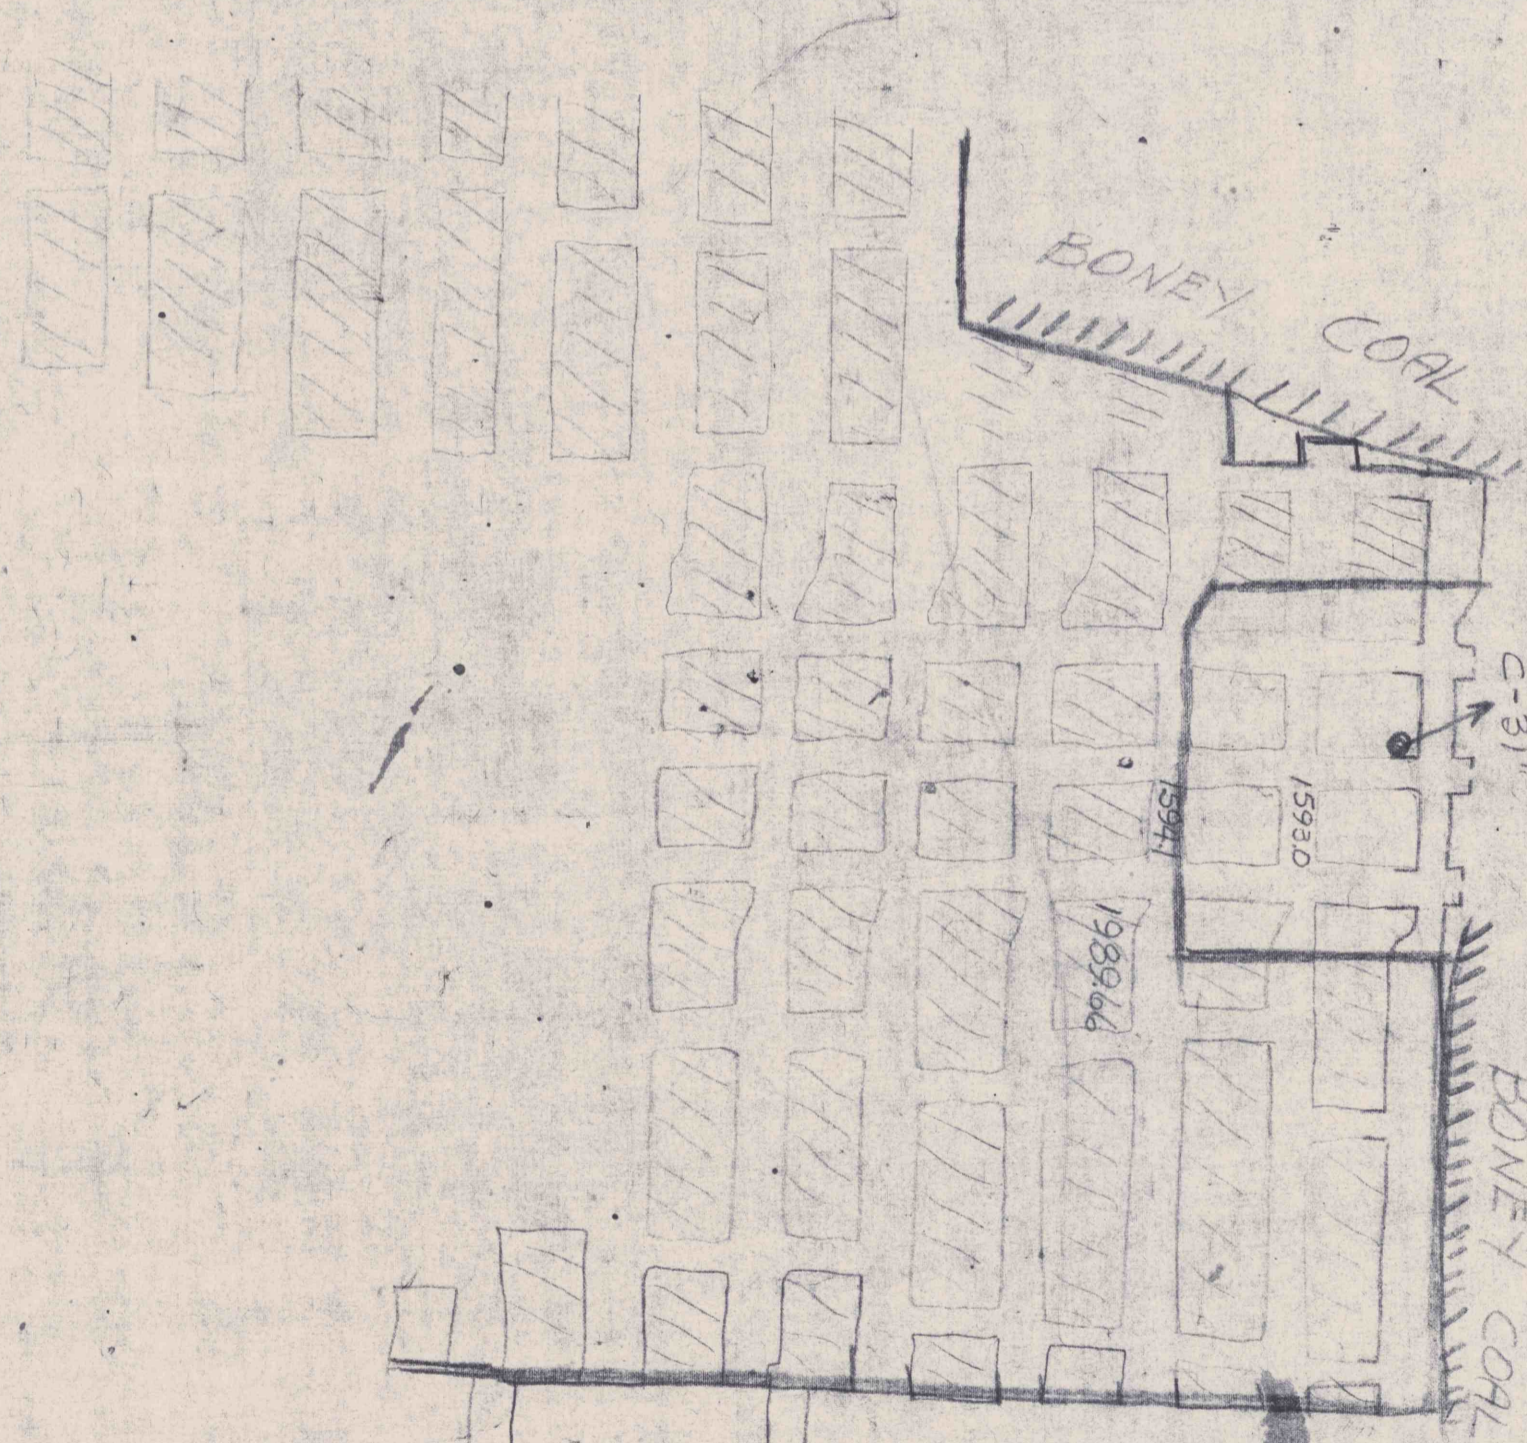

BARRIER PILLAR