


COVER WANE  
SHEET 0-23

COVER WANE  
SHEET 0-23

D.D.M. 9R-55  
S.E. 1726  
S.S. TOP  
C-44  
S.C. 28  
F.C. Bot.

CONTINUOUS ROW OF BLEEDER PIPES  
OF 6" WIDTHS TO BE LEFT IN PLACE

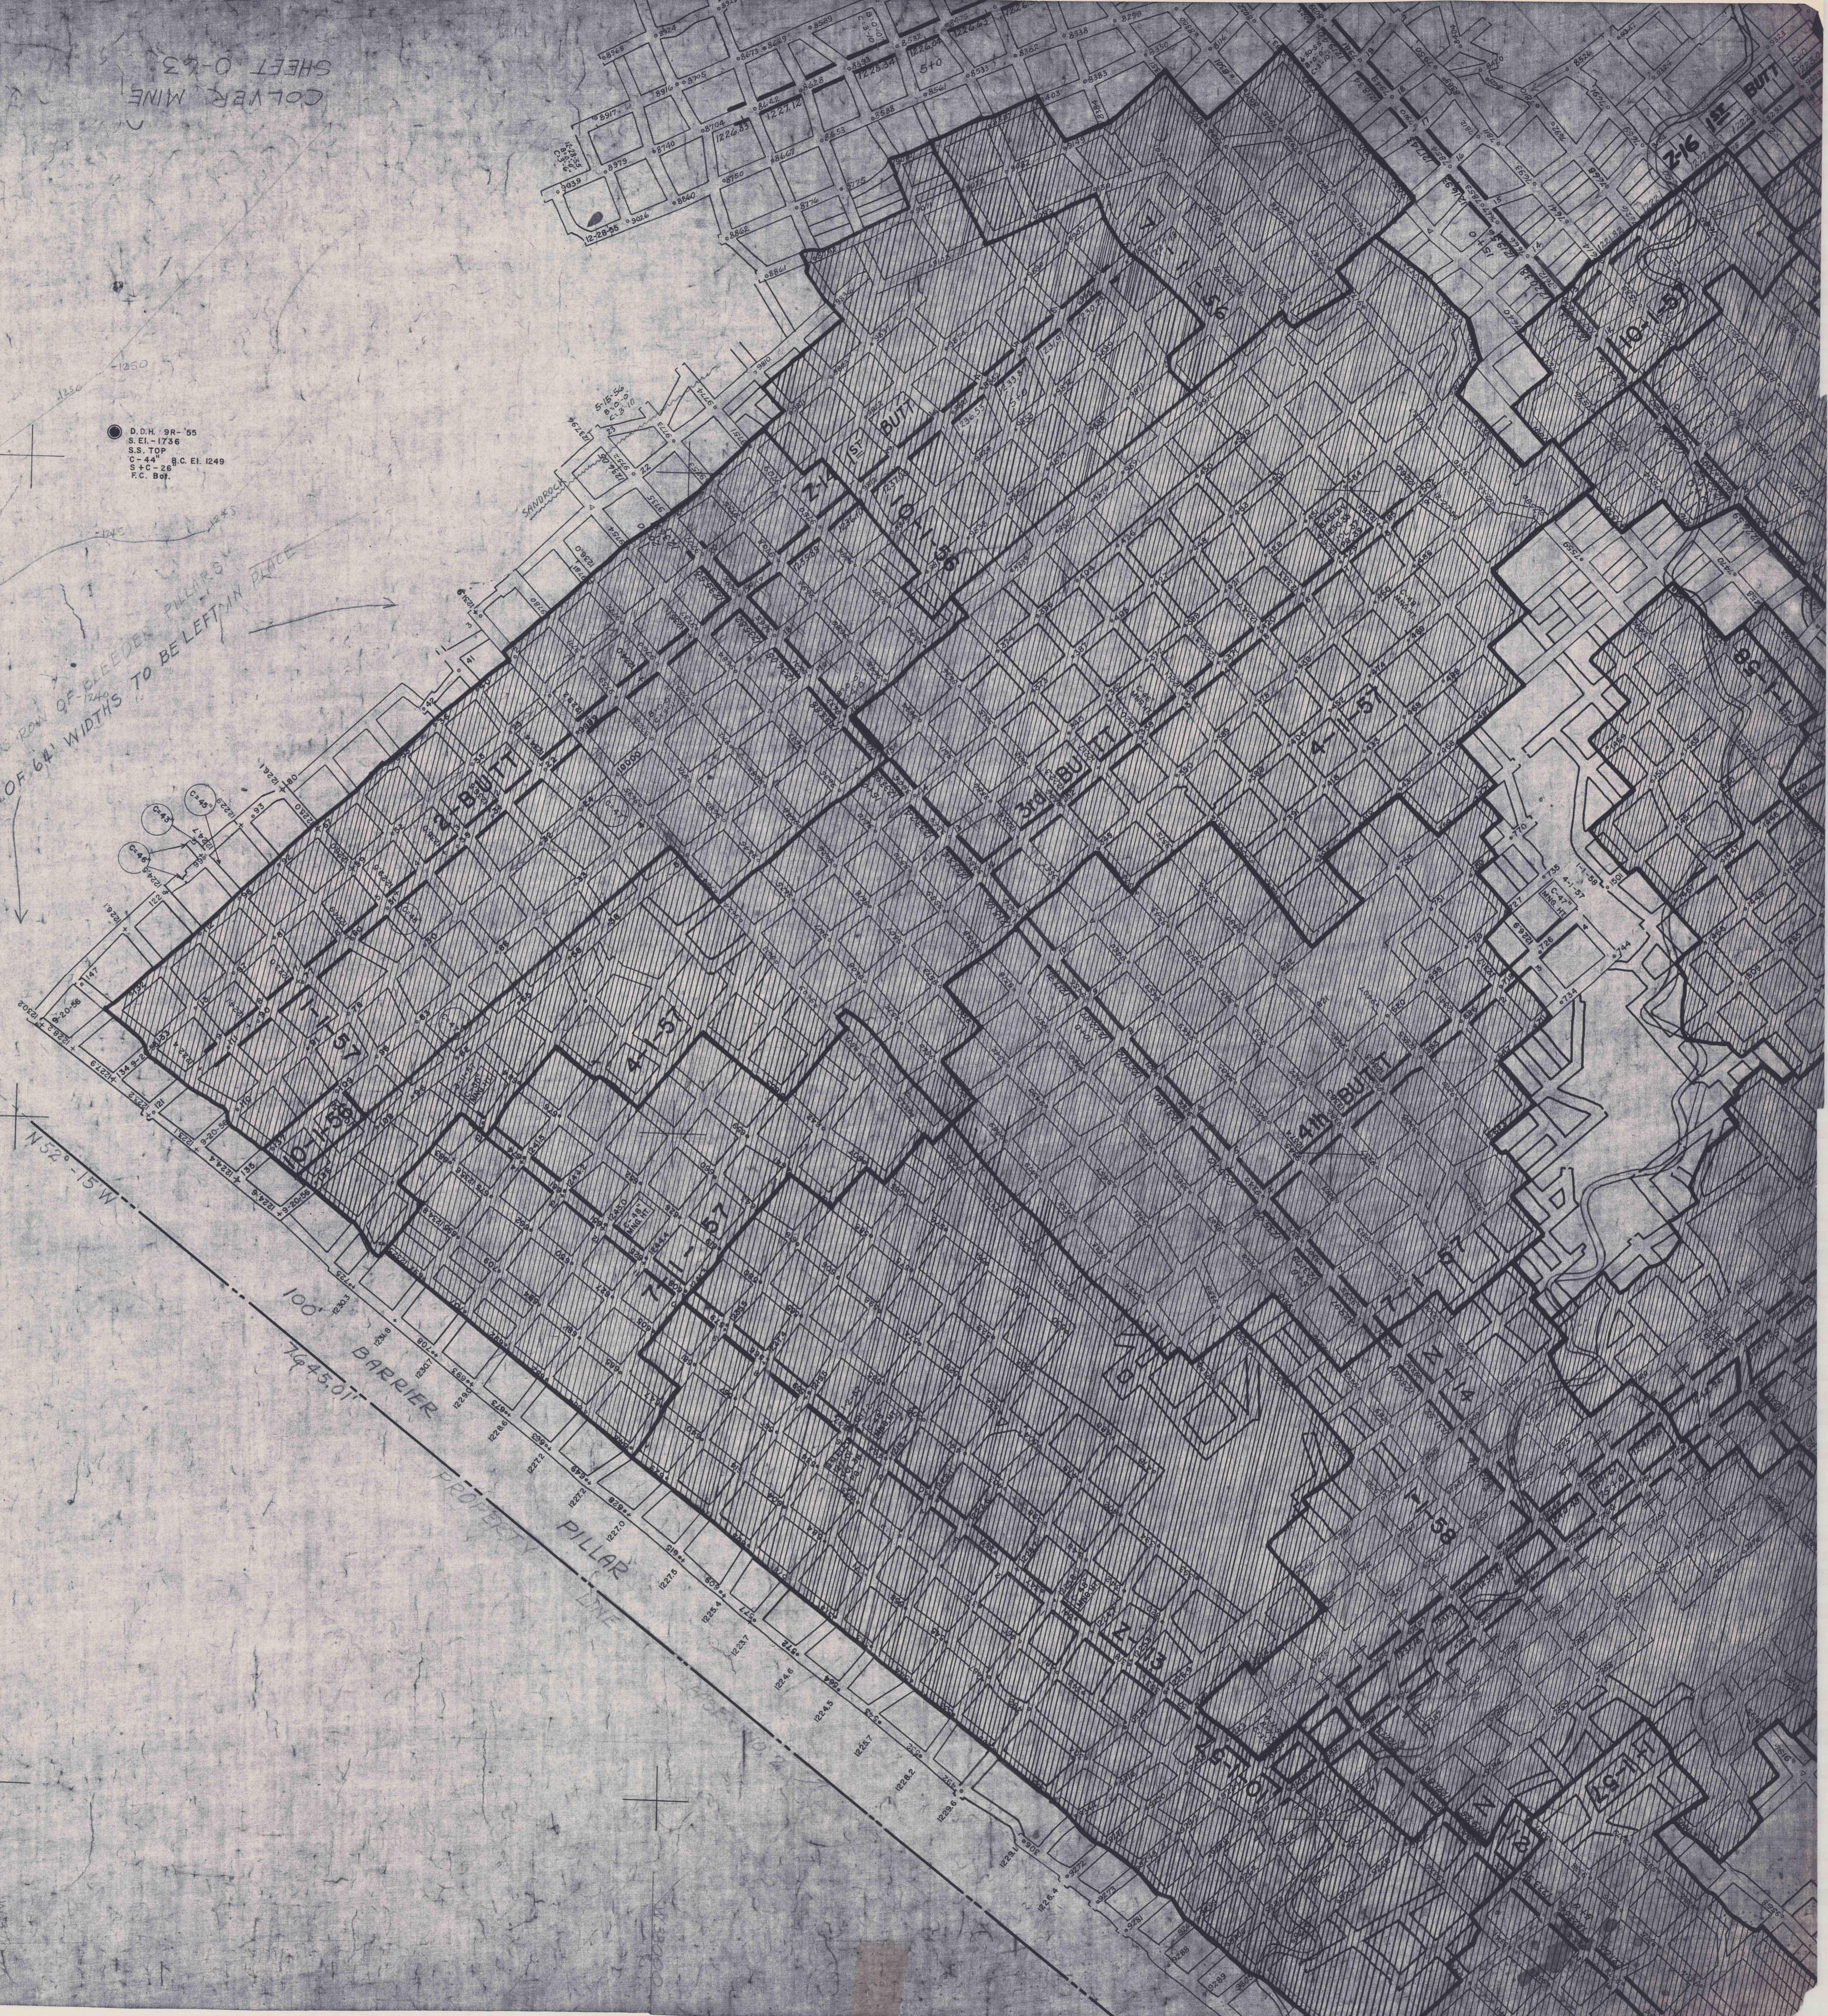

00000N

00000N

00000N