

N 3000

N 70° 40' W

2179.44


N 79° 58' W

SHEET 0-72

N 2900

W 4100

W 4100

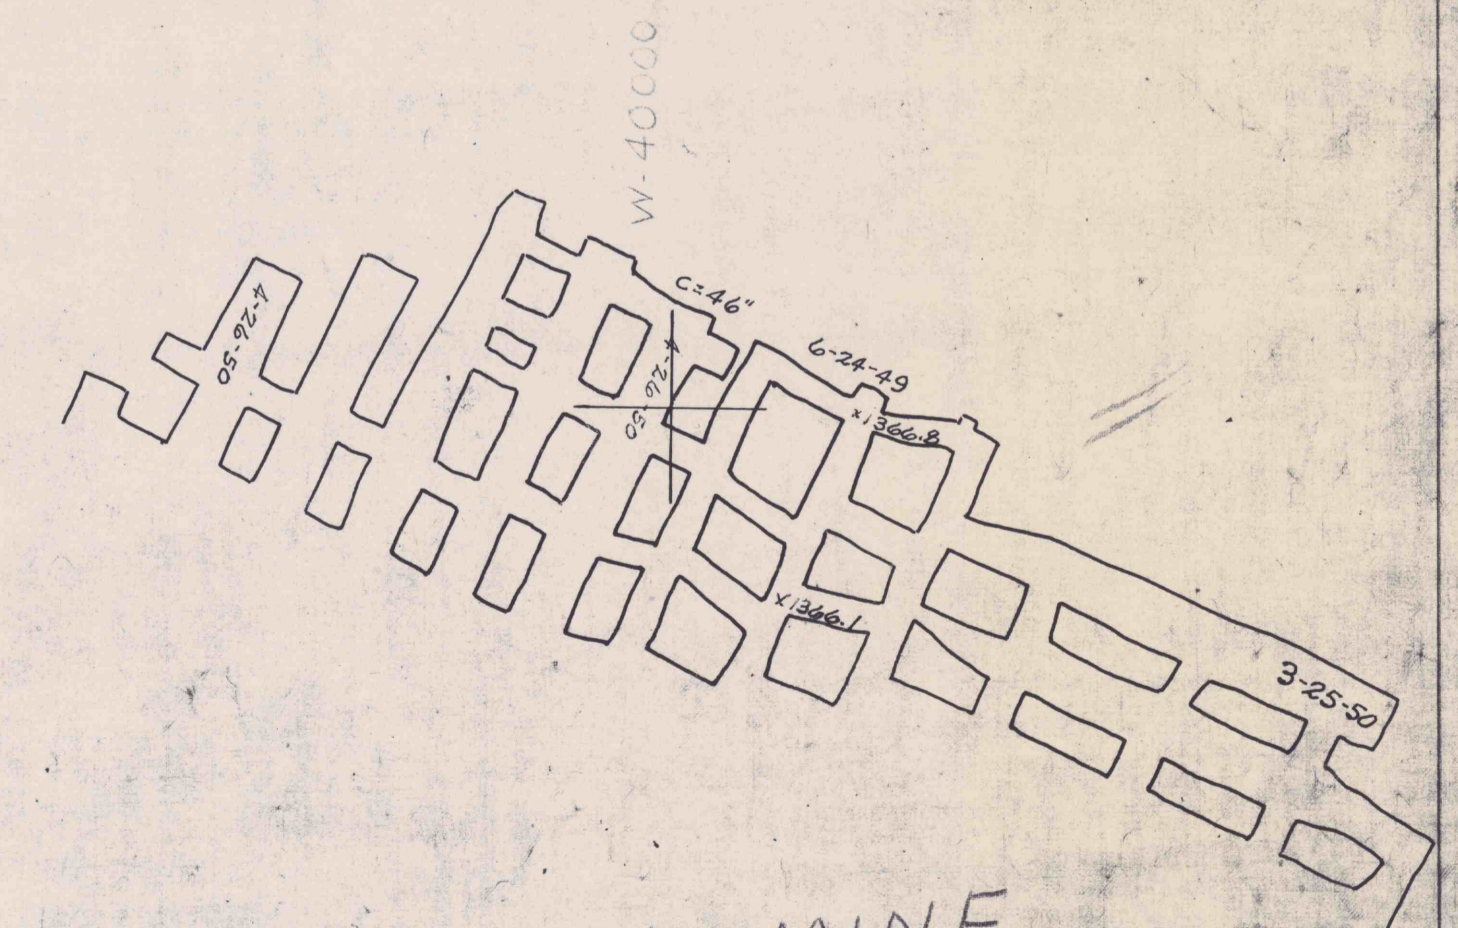

COLVER MINE  
SHEET 0-72