


COLLEGE MINE  
SHEET 0-13

COLLEGE MINE  
SHEET 0-13

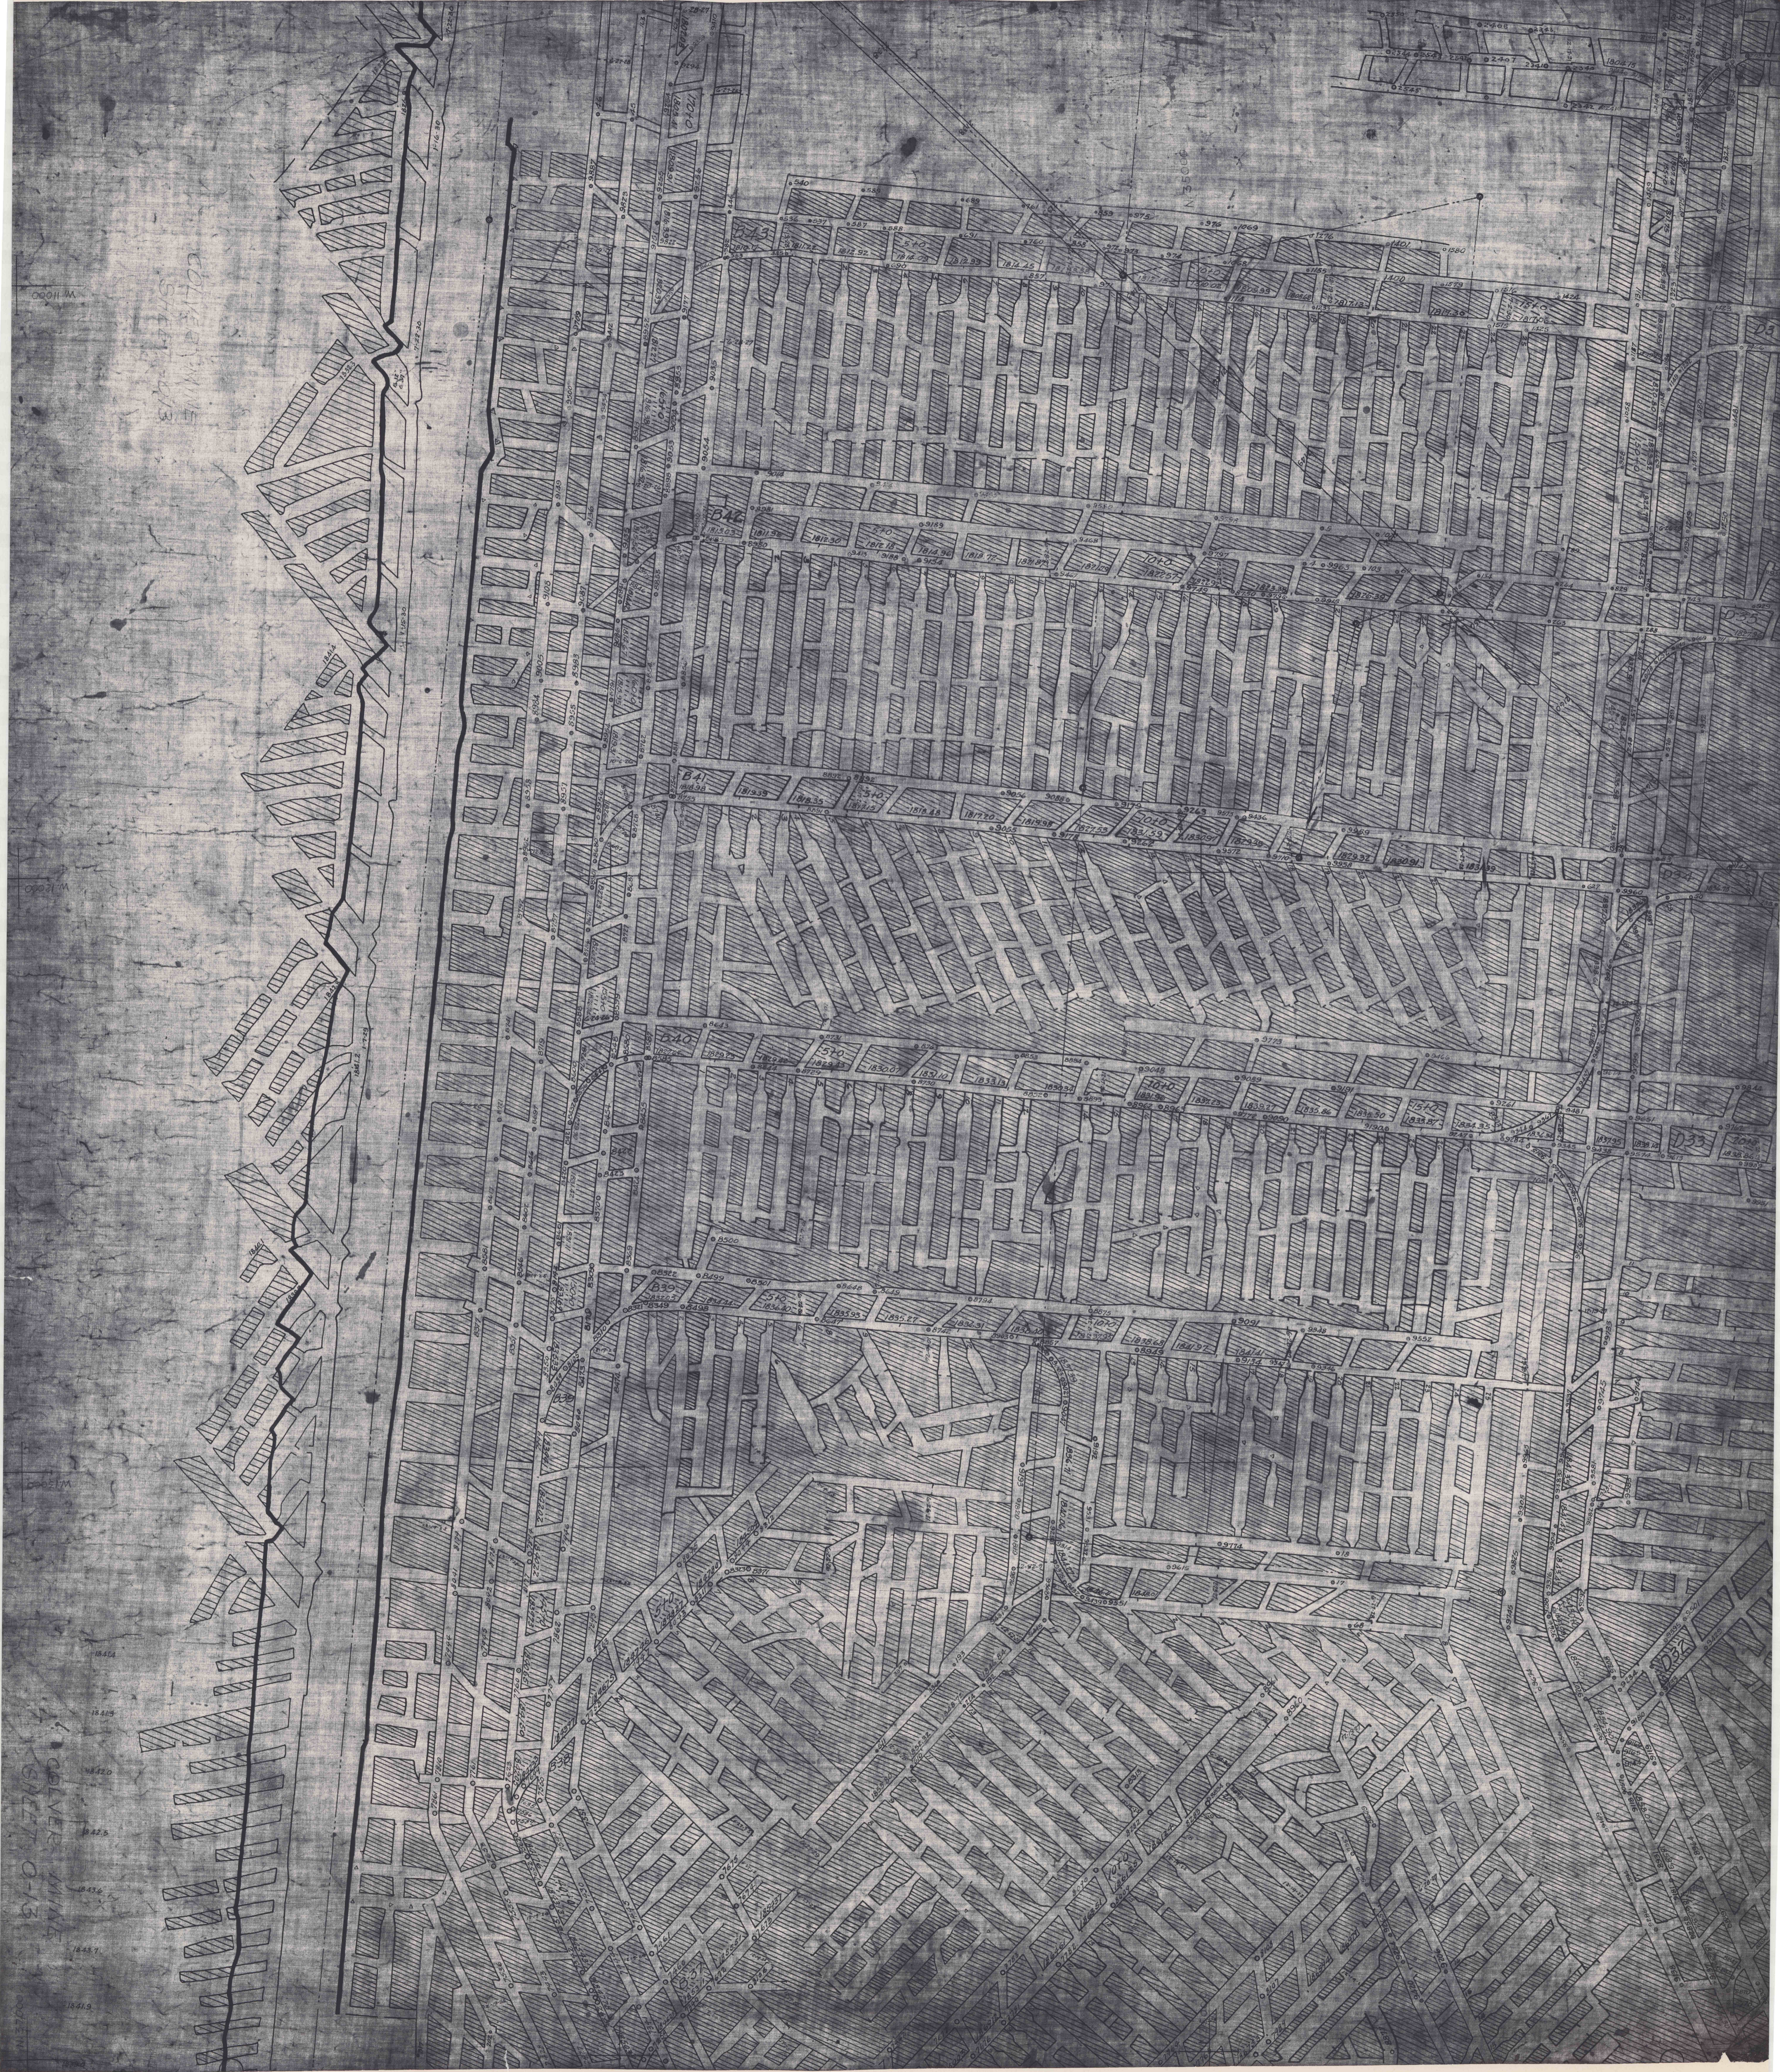

00011 W

00011 W

00011 W

18414

18415

18420

18425

18436

18437

18415








