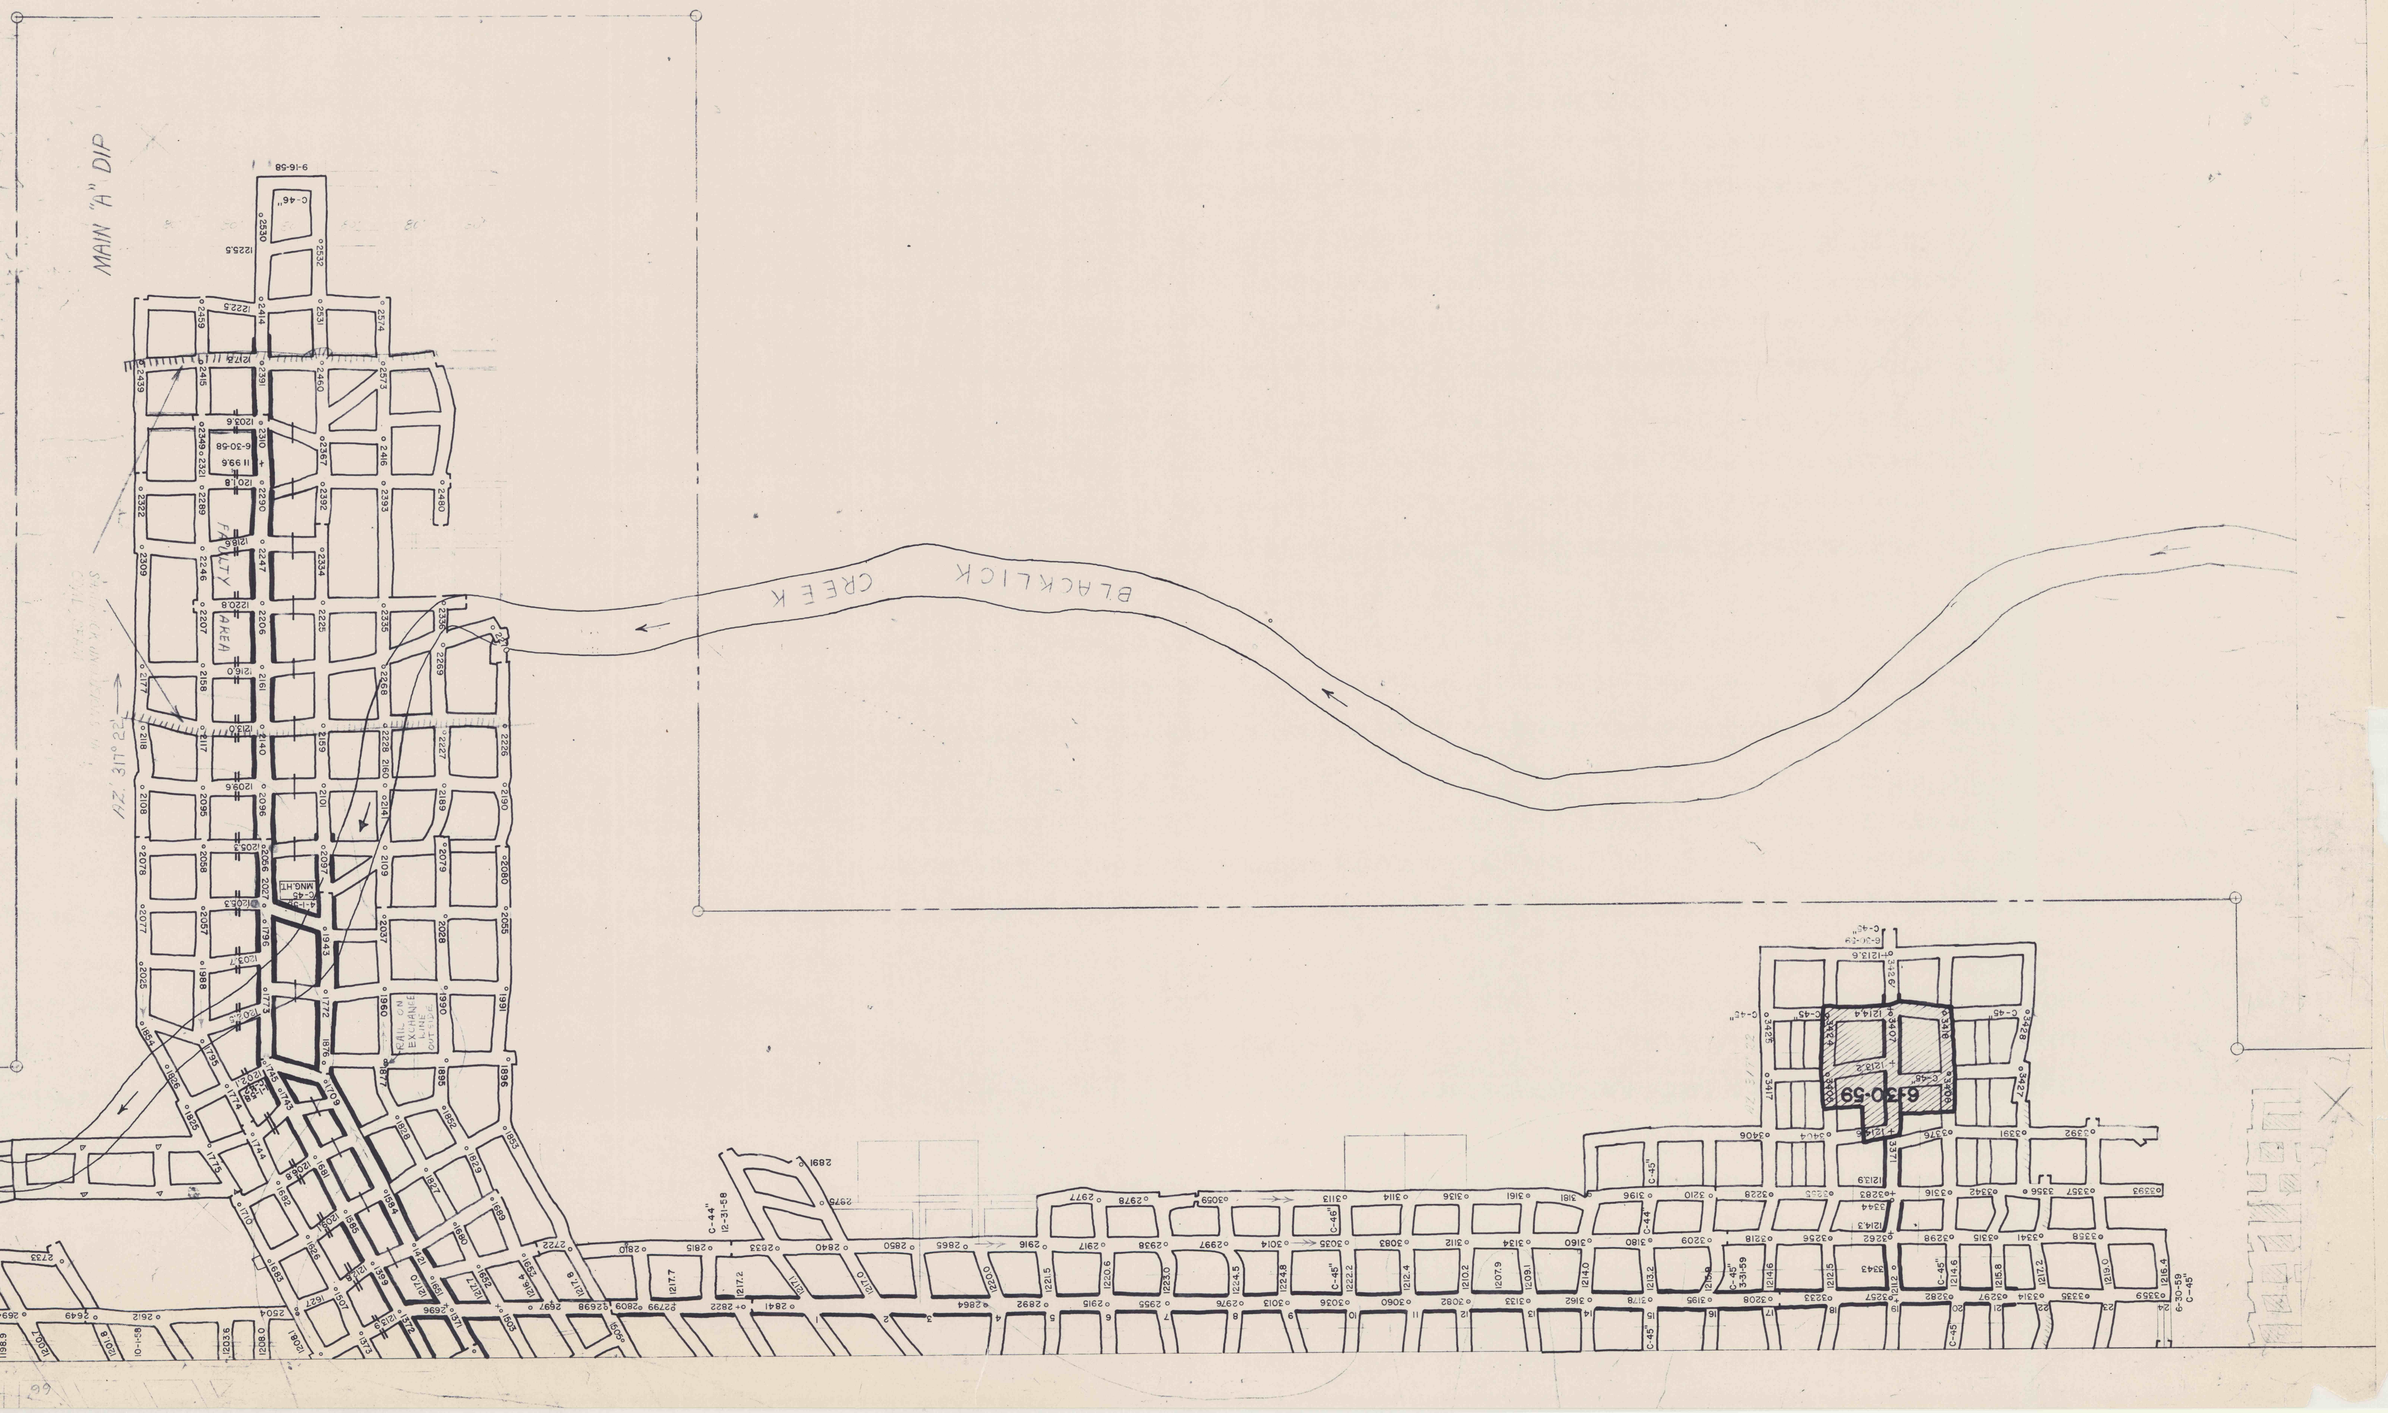
MAIN "A" DIP
SHEET No. 0-77
BLACKLICK CREEK
FALTY AREA
6-30-59
C-44"
12-31-58
9-16-58
6-30-58
4-15-58