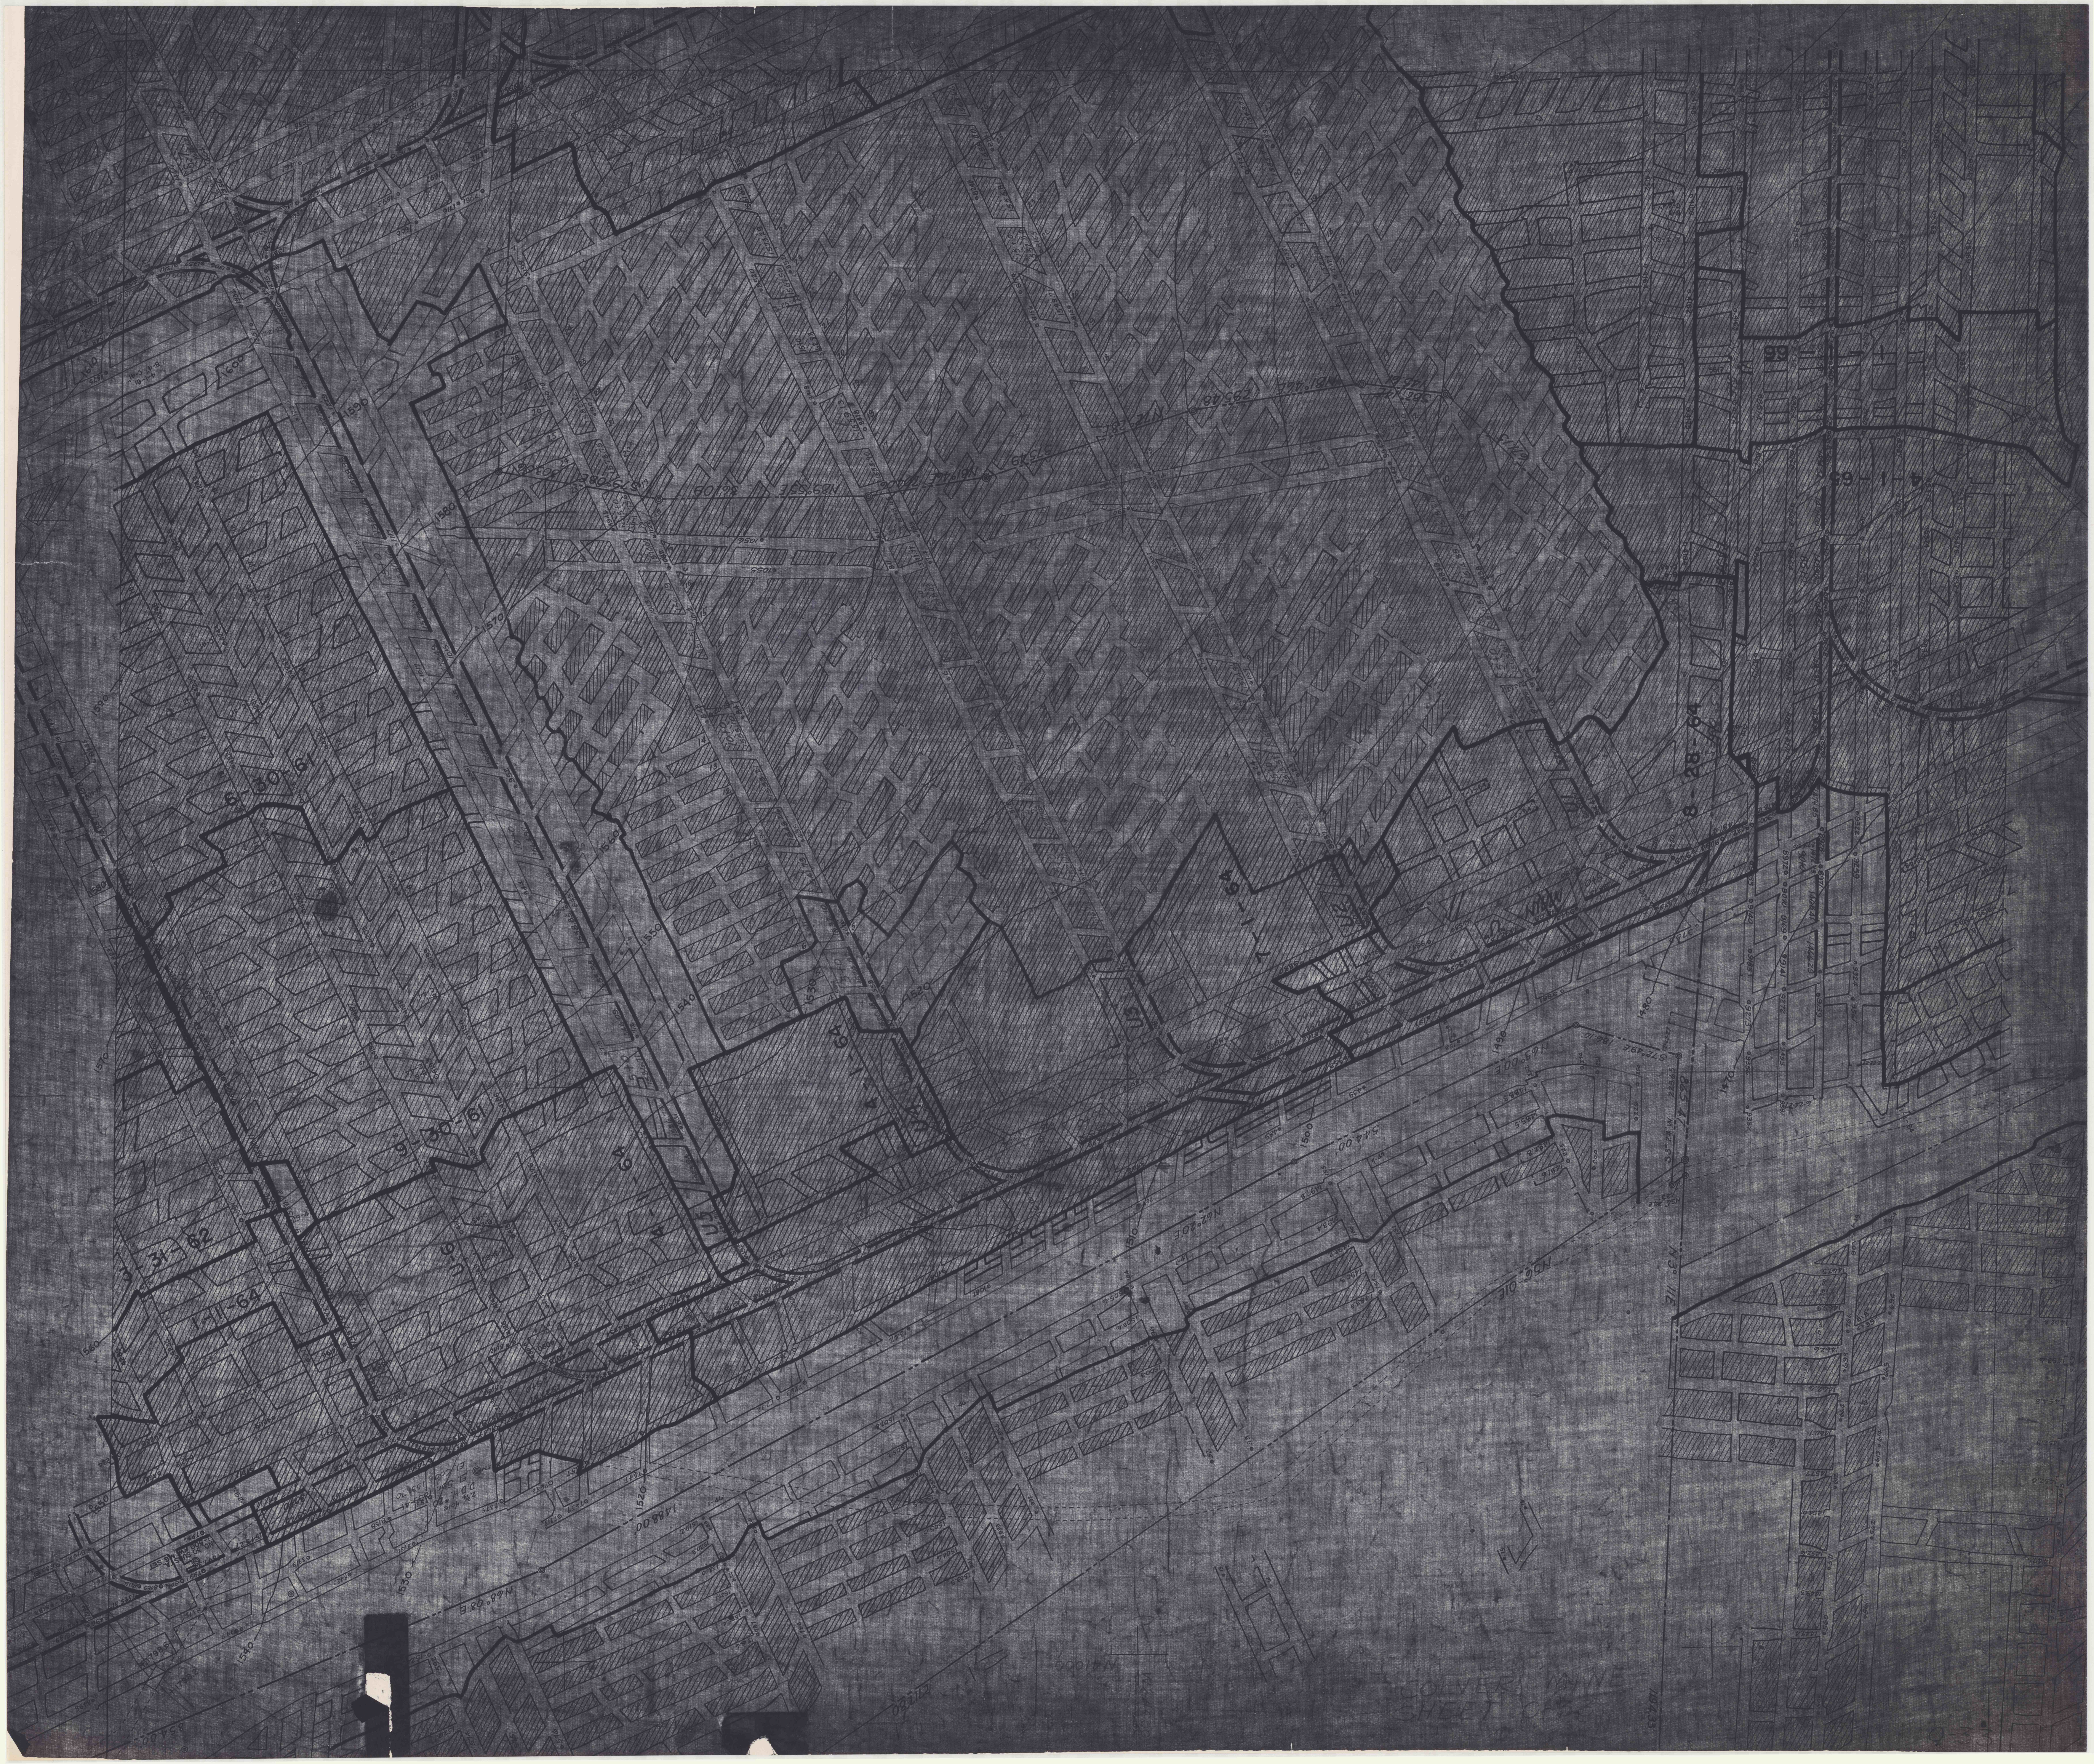
6-30-61
9-30-61
3 31-62
1-1-64
U-6
4-1-64
U4
U5
U3
1-1-64
UK
8-28-64
4-1-65
66-1-1
1610
1600
1590
1580
1570
1560
1550
1540
1530
1520
1510
1500
1490
1480
1470
N89°55'E 861.08
N61°44'E 290.06
N72°28'E 373.49
N81°46'E 285.48
382.14
146.61
B-4' Coal 4-1-61
No 30 SUSP. WIRE SET
2½ Hole D.D.H. #20 El. 5th 1539.4 El. Coal 1531.70
N68°08'E
1488.00
854.00
544.00
N62°20'E
N65°00'E
S72°49'E 186.10
865.47
S3°24'W 223.65
N56°01'E 310
311°E
N41000
1194.33
COLVER MINE
SHEET O-33
O-33