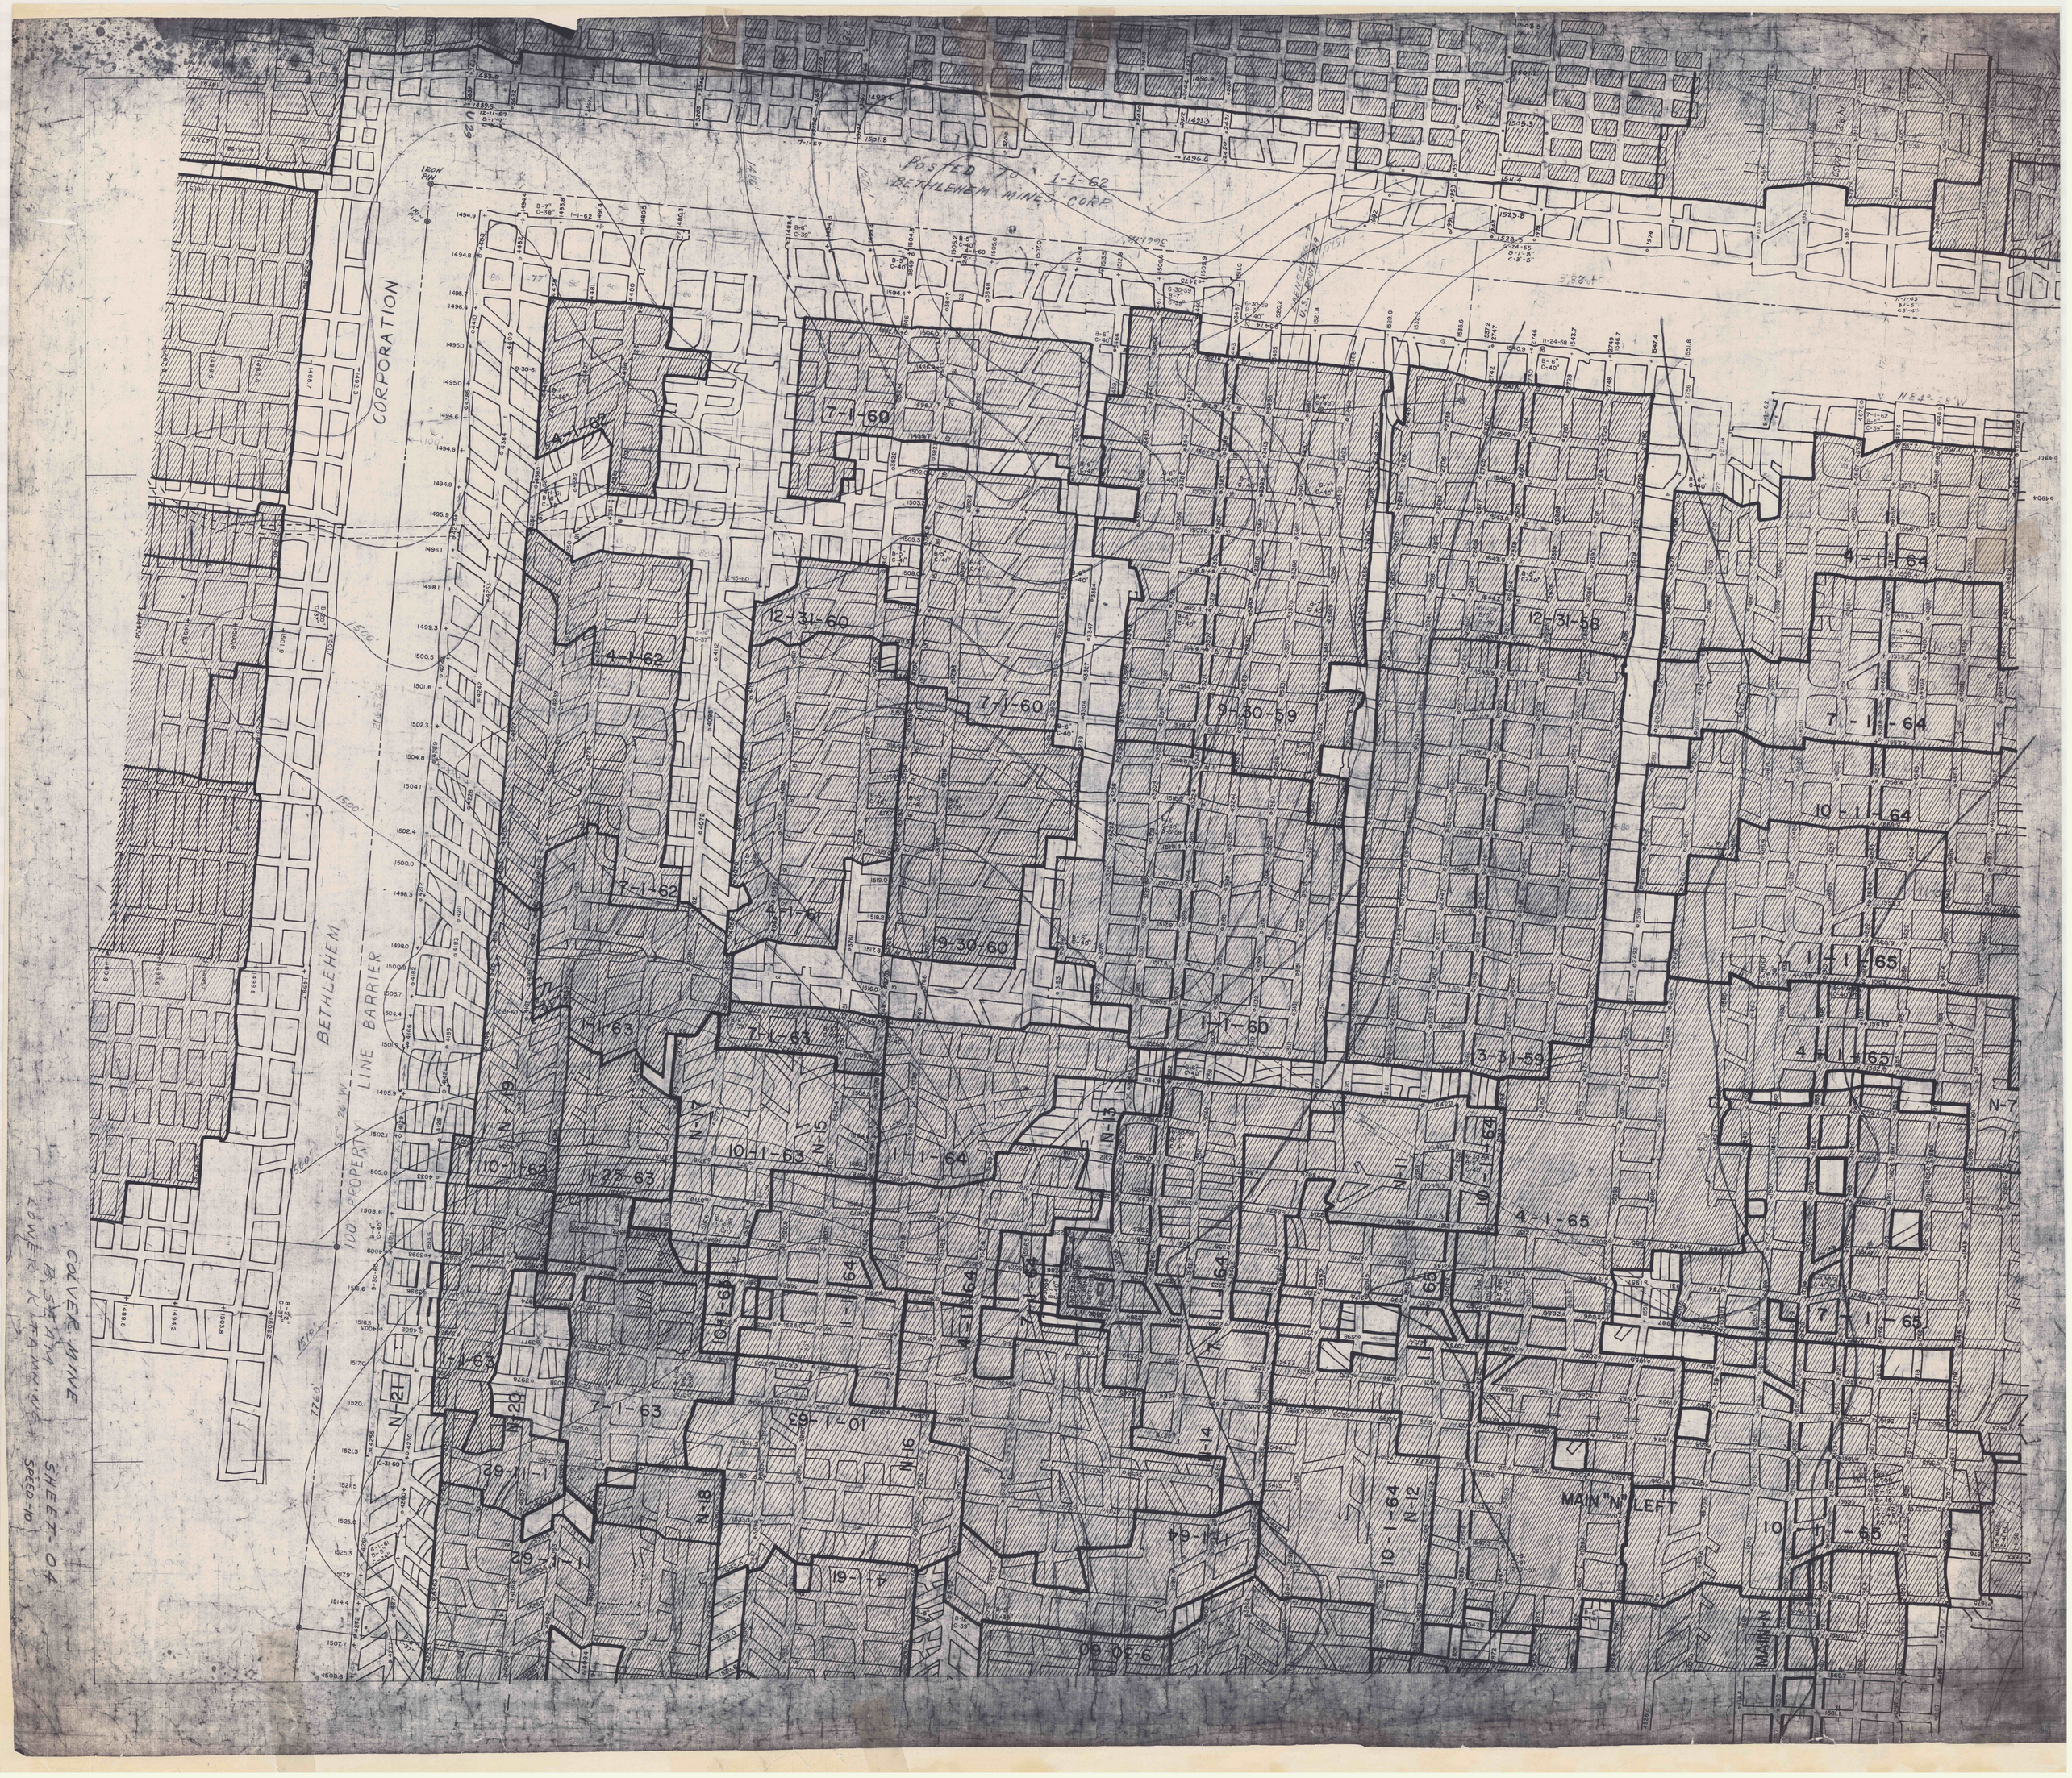
POSTED TO 1-1-62
BETHLEHEM MINES CORP.
CORPORATION
BETHLEHEM
LINE BARRIER
100' PROPERTY
MAIN "N" LEFT
MAIN-N
COLVER MINE
B. SHAM
LOWER KITAMMING
SHEET-04
SPEED-10