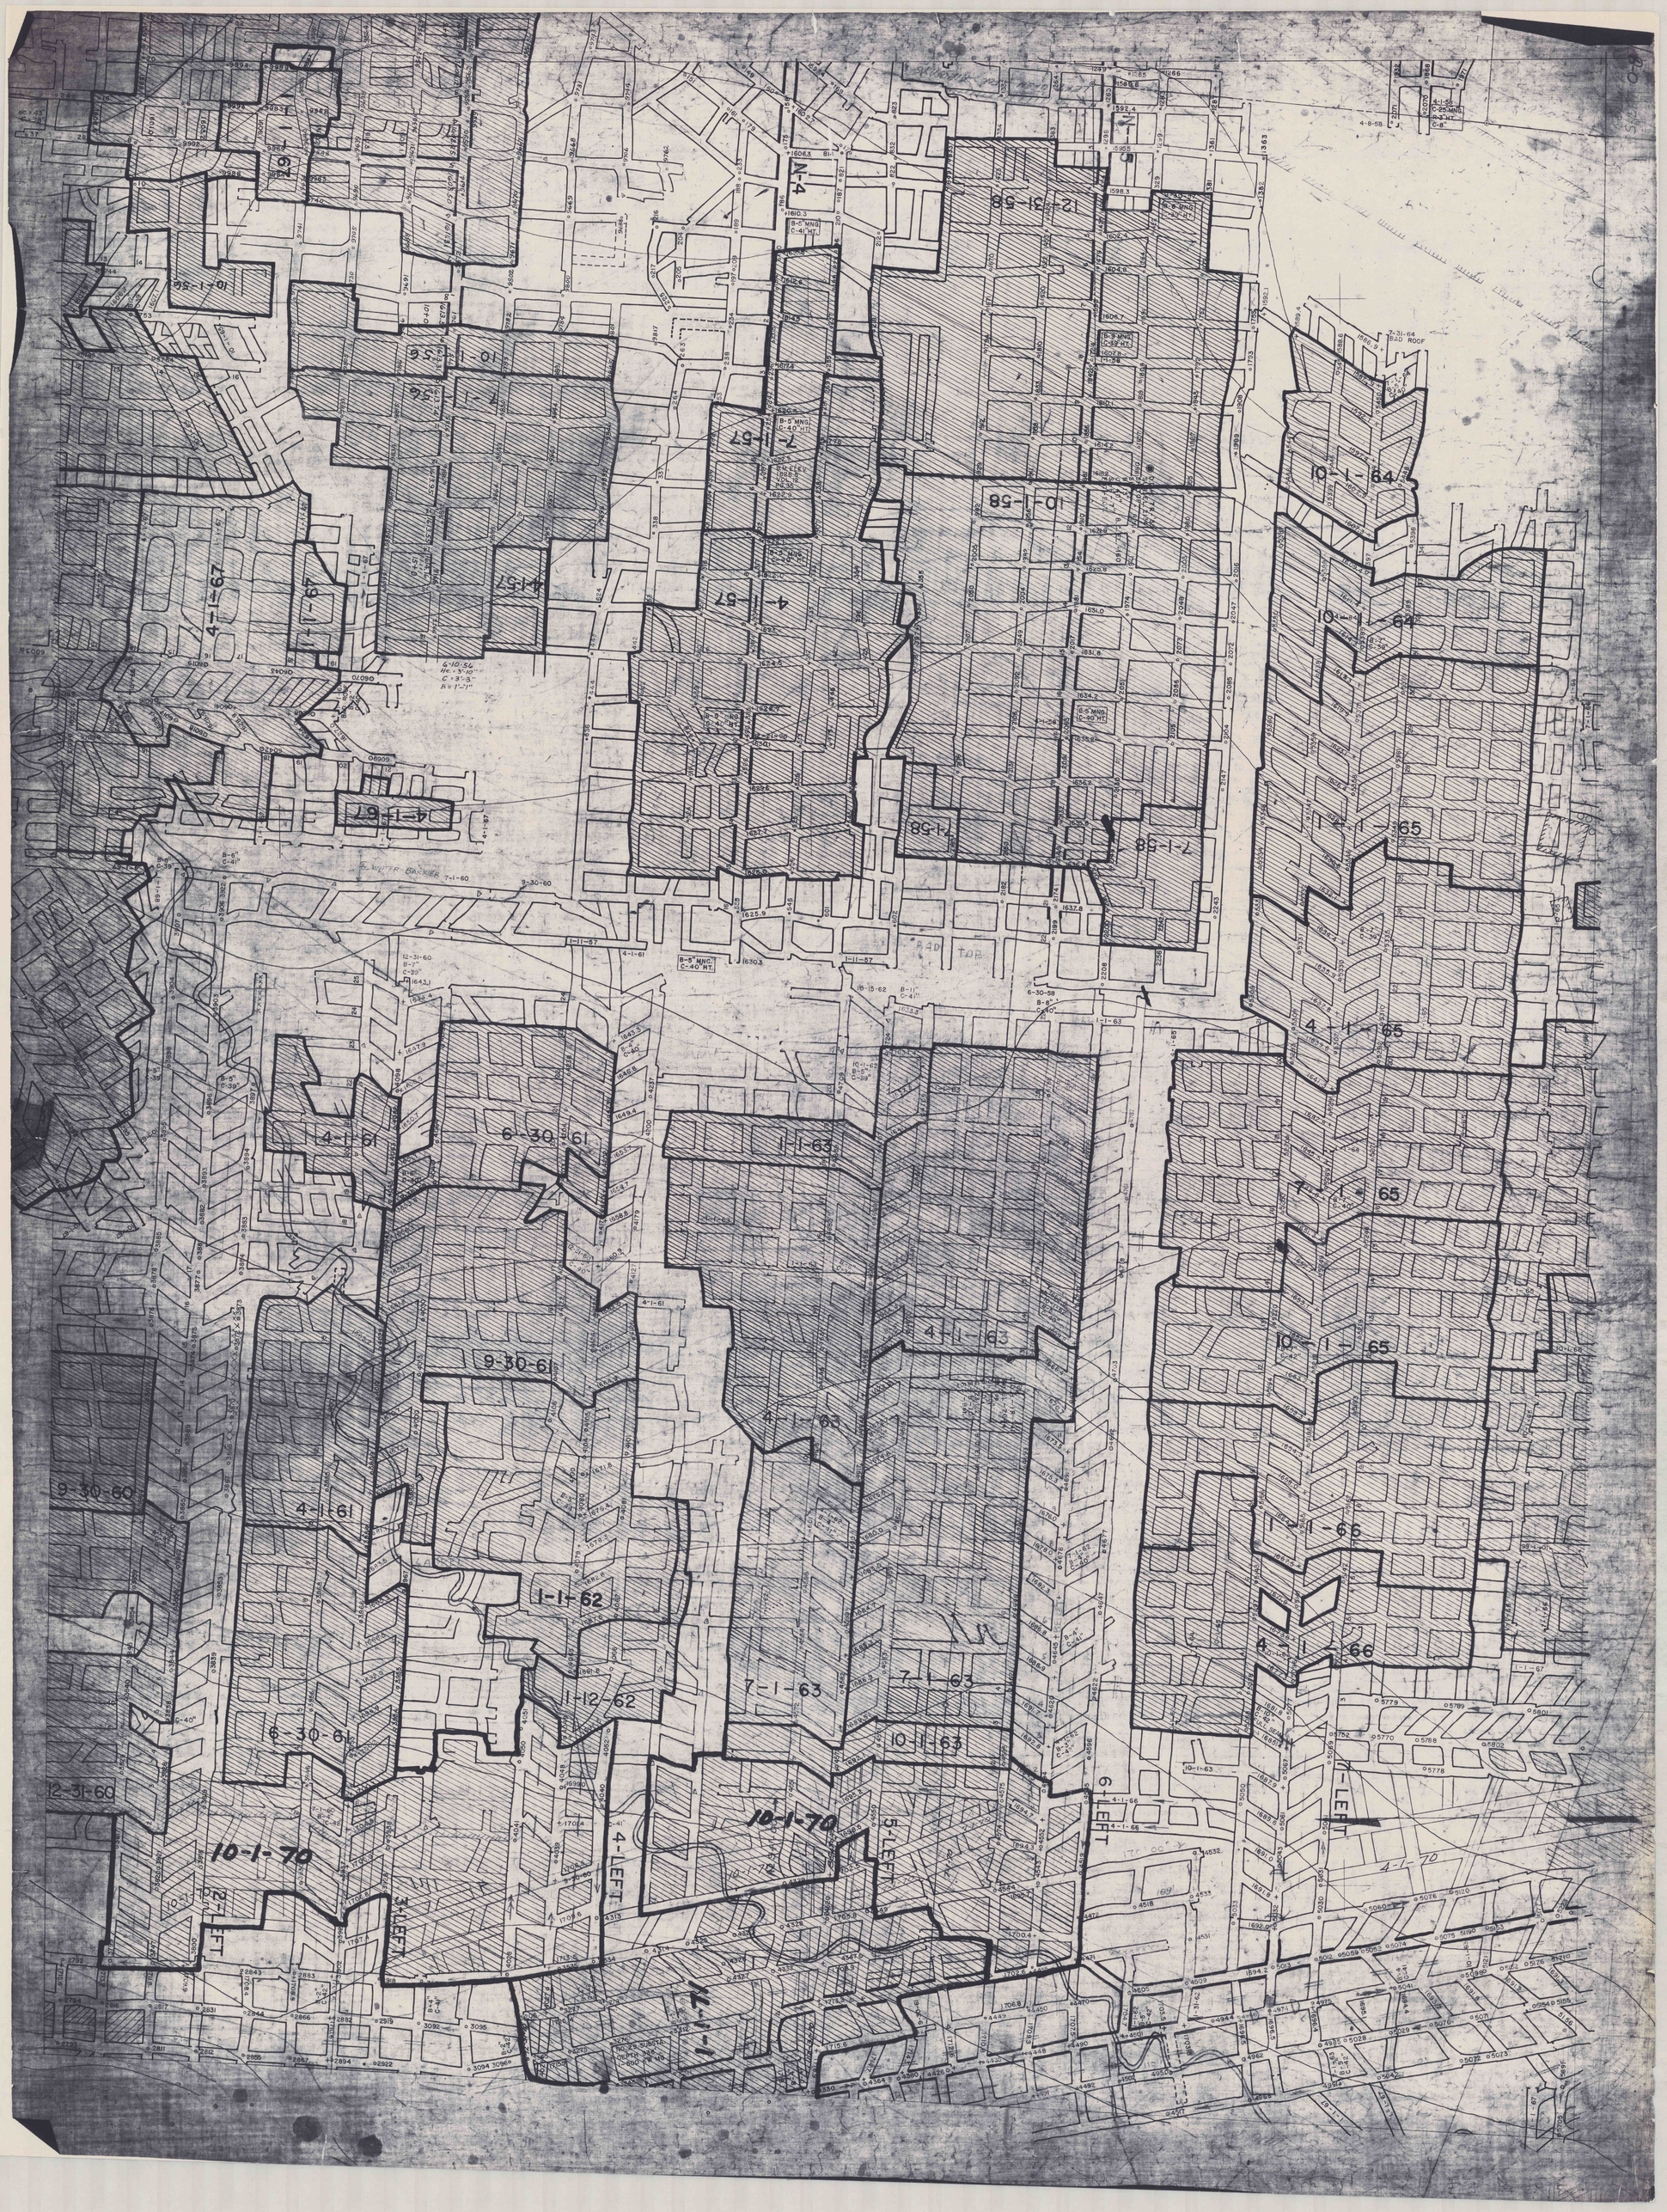
12-31-58
10-1-58
4-1-57
7-11-57
10-1-56
4-1-67
4-1-61
6-30-61
9-30-60
12-31-60
10-1-70
1-1-62
1-12-62
7-1-63
4-1-63
1-1-63
10-1-63
4-1-66
10-1-64
10-1-65
4-1-65
7-1-65
1-1-66
4-1-66
7-1-58
4-1-70
6-LEFT
5-LEFT
4-LEFT
7-LEFT
11-LEFT
B. WALTER BACKER
4-10-56
7-31-64
ROAD TOP