


SEALED

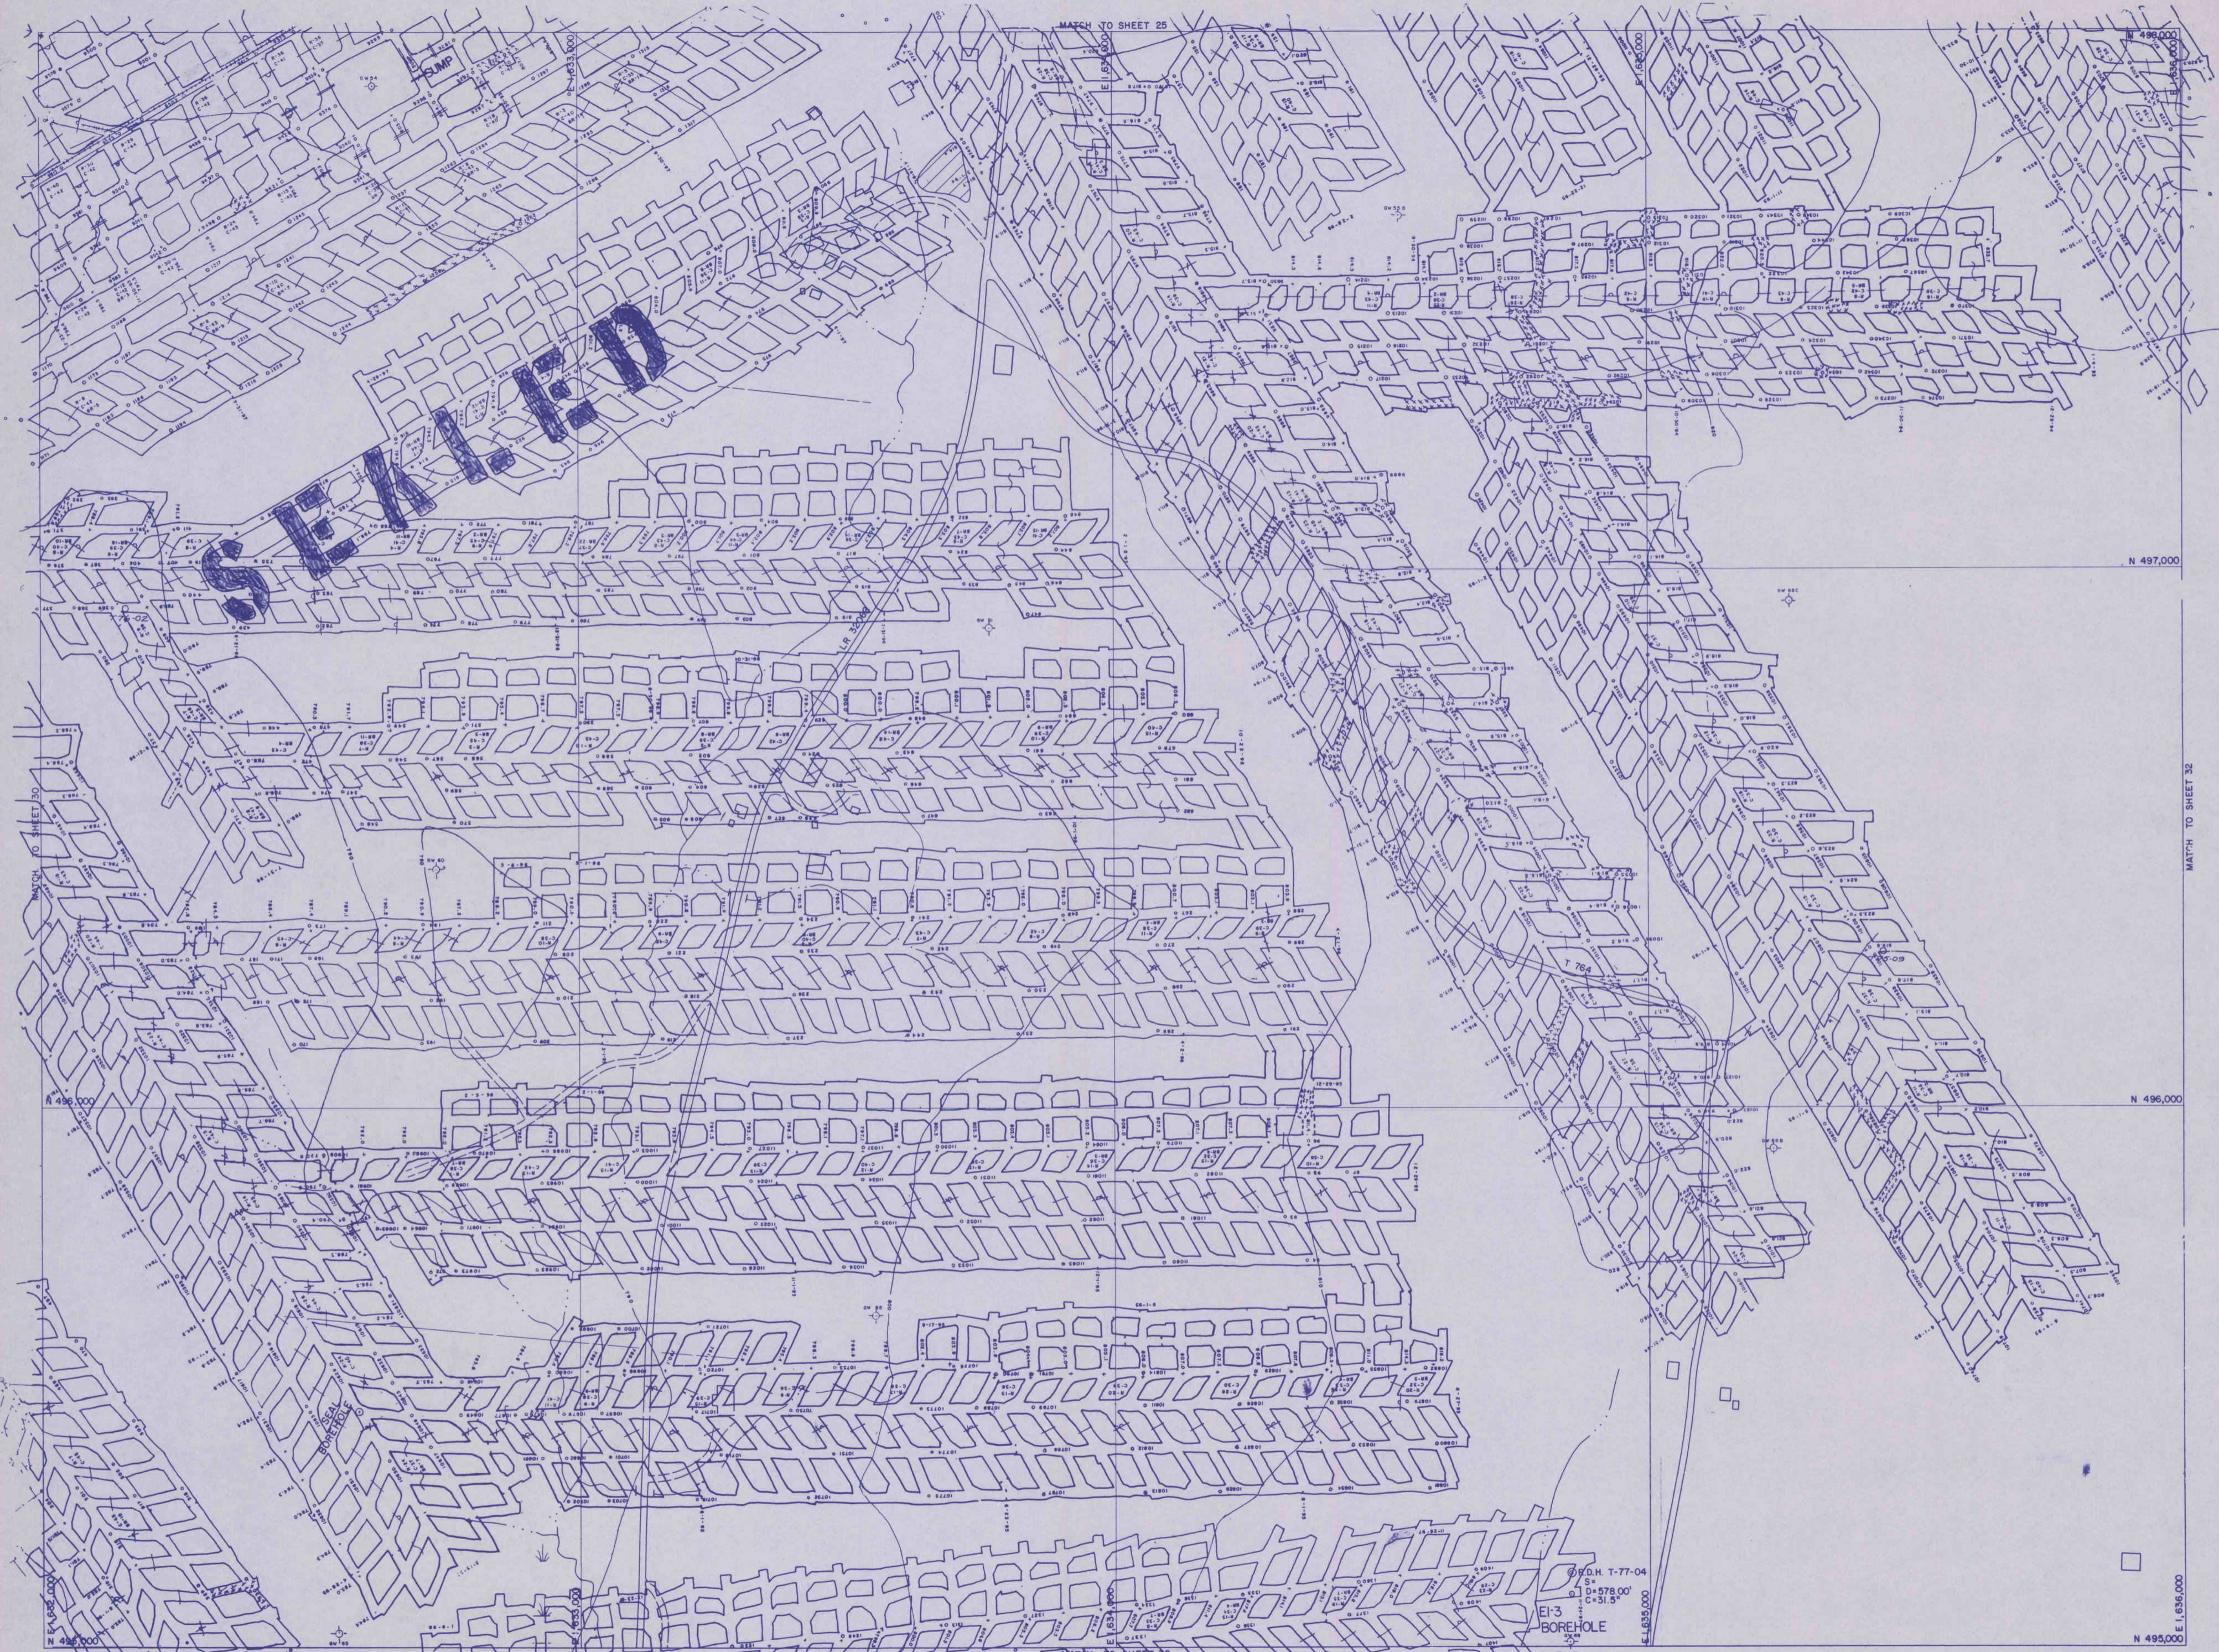

This map compiled from aerial photography taken April, 1979  
L. Robert Rimball, Consulting Engineers, Pennsylvania for  
BARNES & TUCKER COMPANY



- LEGEND
- MONUMENT & ELEVATION
  - △ MONUMENT
  - ⊙ PROPERTY CORNER
  - ⊕ GAS WELL
  - ⊙ IRON PIN
  - ⊕ DIAMOND & ROTARY DRILL HOLE

PLANIMETRIC MAP  
TANOMA MINE  
RAYNE TOWNSHIP, INDIANA CO. PA.  
SCALE: 1" = 100'  
31 OF 59