

FORMERLY  
KRISTIANSON & JOHNSON COAL CO.  
NOW SHANNON LAND & MINING CO.

JOHN E. LONG

FORMERLY  
MAXWELL  
NOW JANCE M. ZIMMERMAN

PAUL


**LEGEND:**

- Extent of Permit —
- Subsidence Control Area —
- Contemplated Mining 7/31/92 to 1/31/93 —
- Mining Completed 1/31/92 to 7/31/92 —
- Lower Kittanning Coal Seam —

NOTE: There are no structures on Sheet 2A.

RECEIVED  
AUG 5 1992

Dept. of Environmental Resources  
McMurray District Office

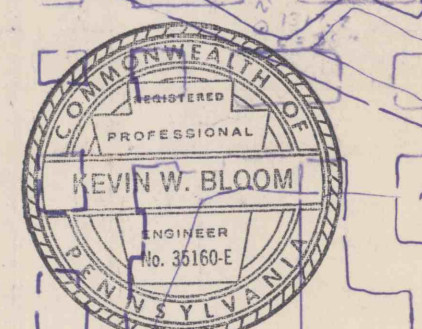

*Kevin W. Bloom*  
7/31/92

MANOR MINING & CONTRACTING CORP.  
Manor #44  
Permit #17841301  
Subsidence Map - Sheets 2A  
Girard Township,  
Clearfield County  
Scale 1" = 100'  
7/31/92

