

LEGEND:

- Extent of Permit
- Subsidence Control Area
- Contemplated Mining 7/31/92 to 1/31/93
- Mining Completed 1/31/92 to 7/31/92
- Protected Structure
- Non-protected Structure
- Calculated Support Area
- Lower Kittanning Coal Seam


FORMERLY
KRISTIANSON & JOHNSON COAL CO.
NOW SHANNON LAND & MINING CO.

FORMERLY
KRISTIANSON & JOHNSON COAL CO.
NOW SHANNON LAND & MINING CO.

FORMERLY
KRISTIANSON & JOHNSON COAL CO.
NOW SHANNON LAND & MINING CO.

FORMERLY
KRISTIANSON & JOHNSON COAL CO.
NOW SHANNON LAND & MINING CO.

RECEIVED
AUG 5 1992
Dept. of Environmental Resources
McMurray District Office

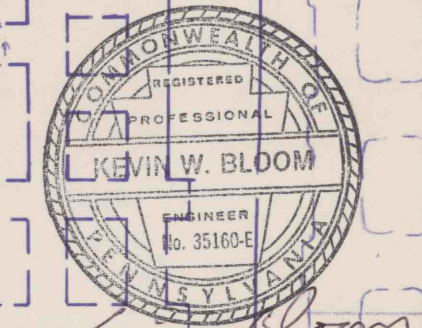

Kevin W. Bloom
7/31/92

MANOR MINING & CONTRACTING CORP.
Manor #44
Permit #17841301
Subsidence Map - Sheet 2C
Girard Township,
Clearfield County
Scale 1" = 100'
7/31/92