




**LEGEND**


- Regulator
- Proposed Air Flows
- Intake Air
- Return Air
- Belt Air
- Belt Line
- Permanent Stopping
- Check Curtain
- Proposed Stopping
- Doors
- Equipment Doors
- Seals
- Survey Station
- Permit Boundary
- Property Line
- Public Road
- Stream
- Mining Completed Area
- Contemplated Mining Area
- Projected Mining
- Projection No.
- Survey Date

**ESCAPEWAYS**

- Primary Escapeway
- Secondary Escapeway

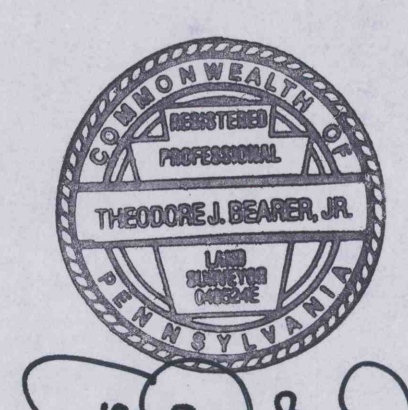

115101

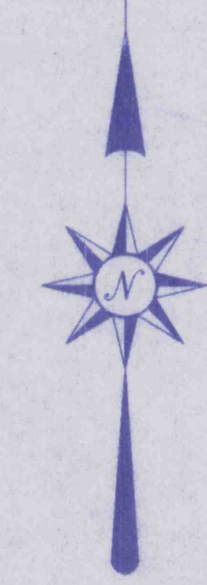

1
2
3
4
5
6
7
8
9
10

SHEET 2 OF 16

**ROSEBUD MINING COMPANY**

ROSEBUD NO. 2 MINE  
PERRY TWP. ARMSTRONG CO.

LOWER KITTANNING COAL SEAM

SCALE: 1"=100'



FINAL MAP