


LEGEND


- Regulator
- Proposed Air Flows
- Intake Air
- Return Air
- Belt Air
- Belt Line
- Permanent Stopping
- Check Curtain
- Proposed Stopping
- Doors
- Equipment Doors
- Seals
- Survey Station
- Permit Boundary
- Property Line
- Public Road
- Stream
- Mining Completed Area
- Contemplated Mining Area
- Projected Mining TO
- Projection No.
- Survey Date 11-1-00

ESCAPEWAYS

- Primary Escapeway
- Secondary Escapeway

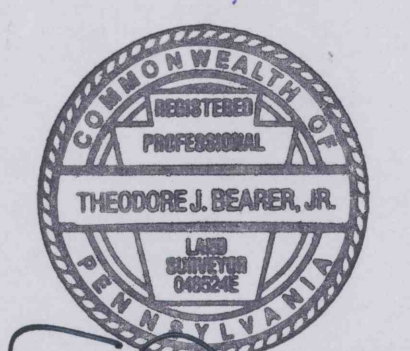

Walter B. Baker
WLS/21

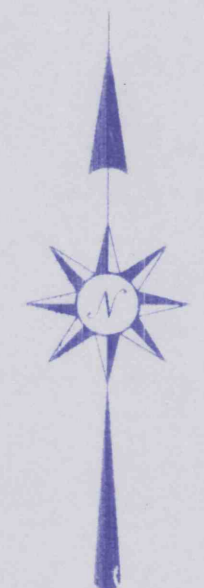

SHEET 6 OF 16

ROSEBUD MINING COMPANY
ROSEBUD NO.2 MINE
PERRY TWP. ARMSTRONG CO.
LOWER KITTANNING COAL SEAM
SCALE: 1"=100'



FINAL MAP