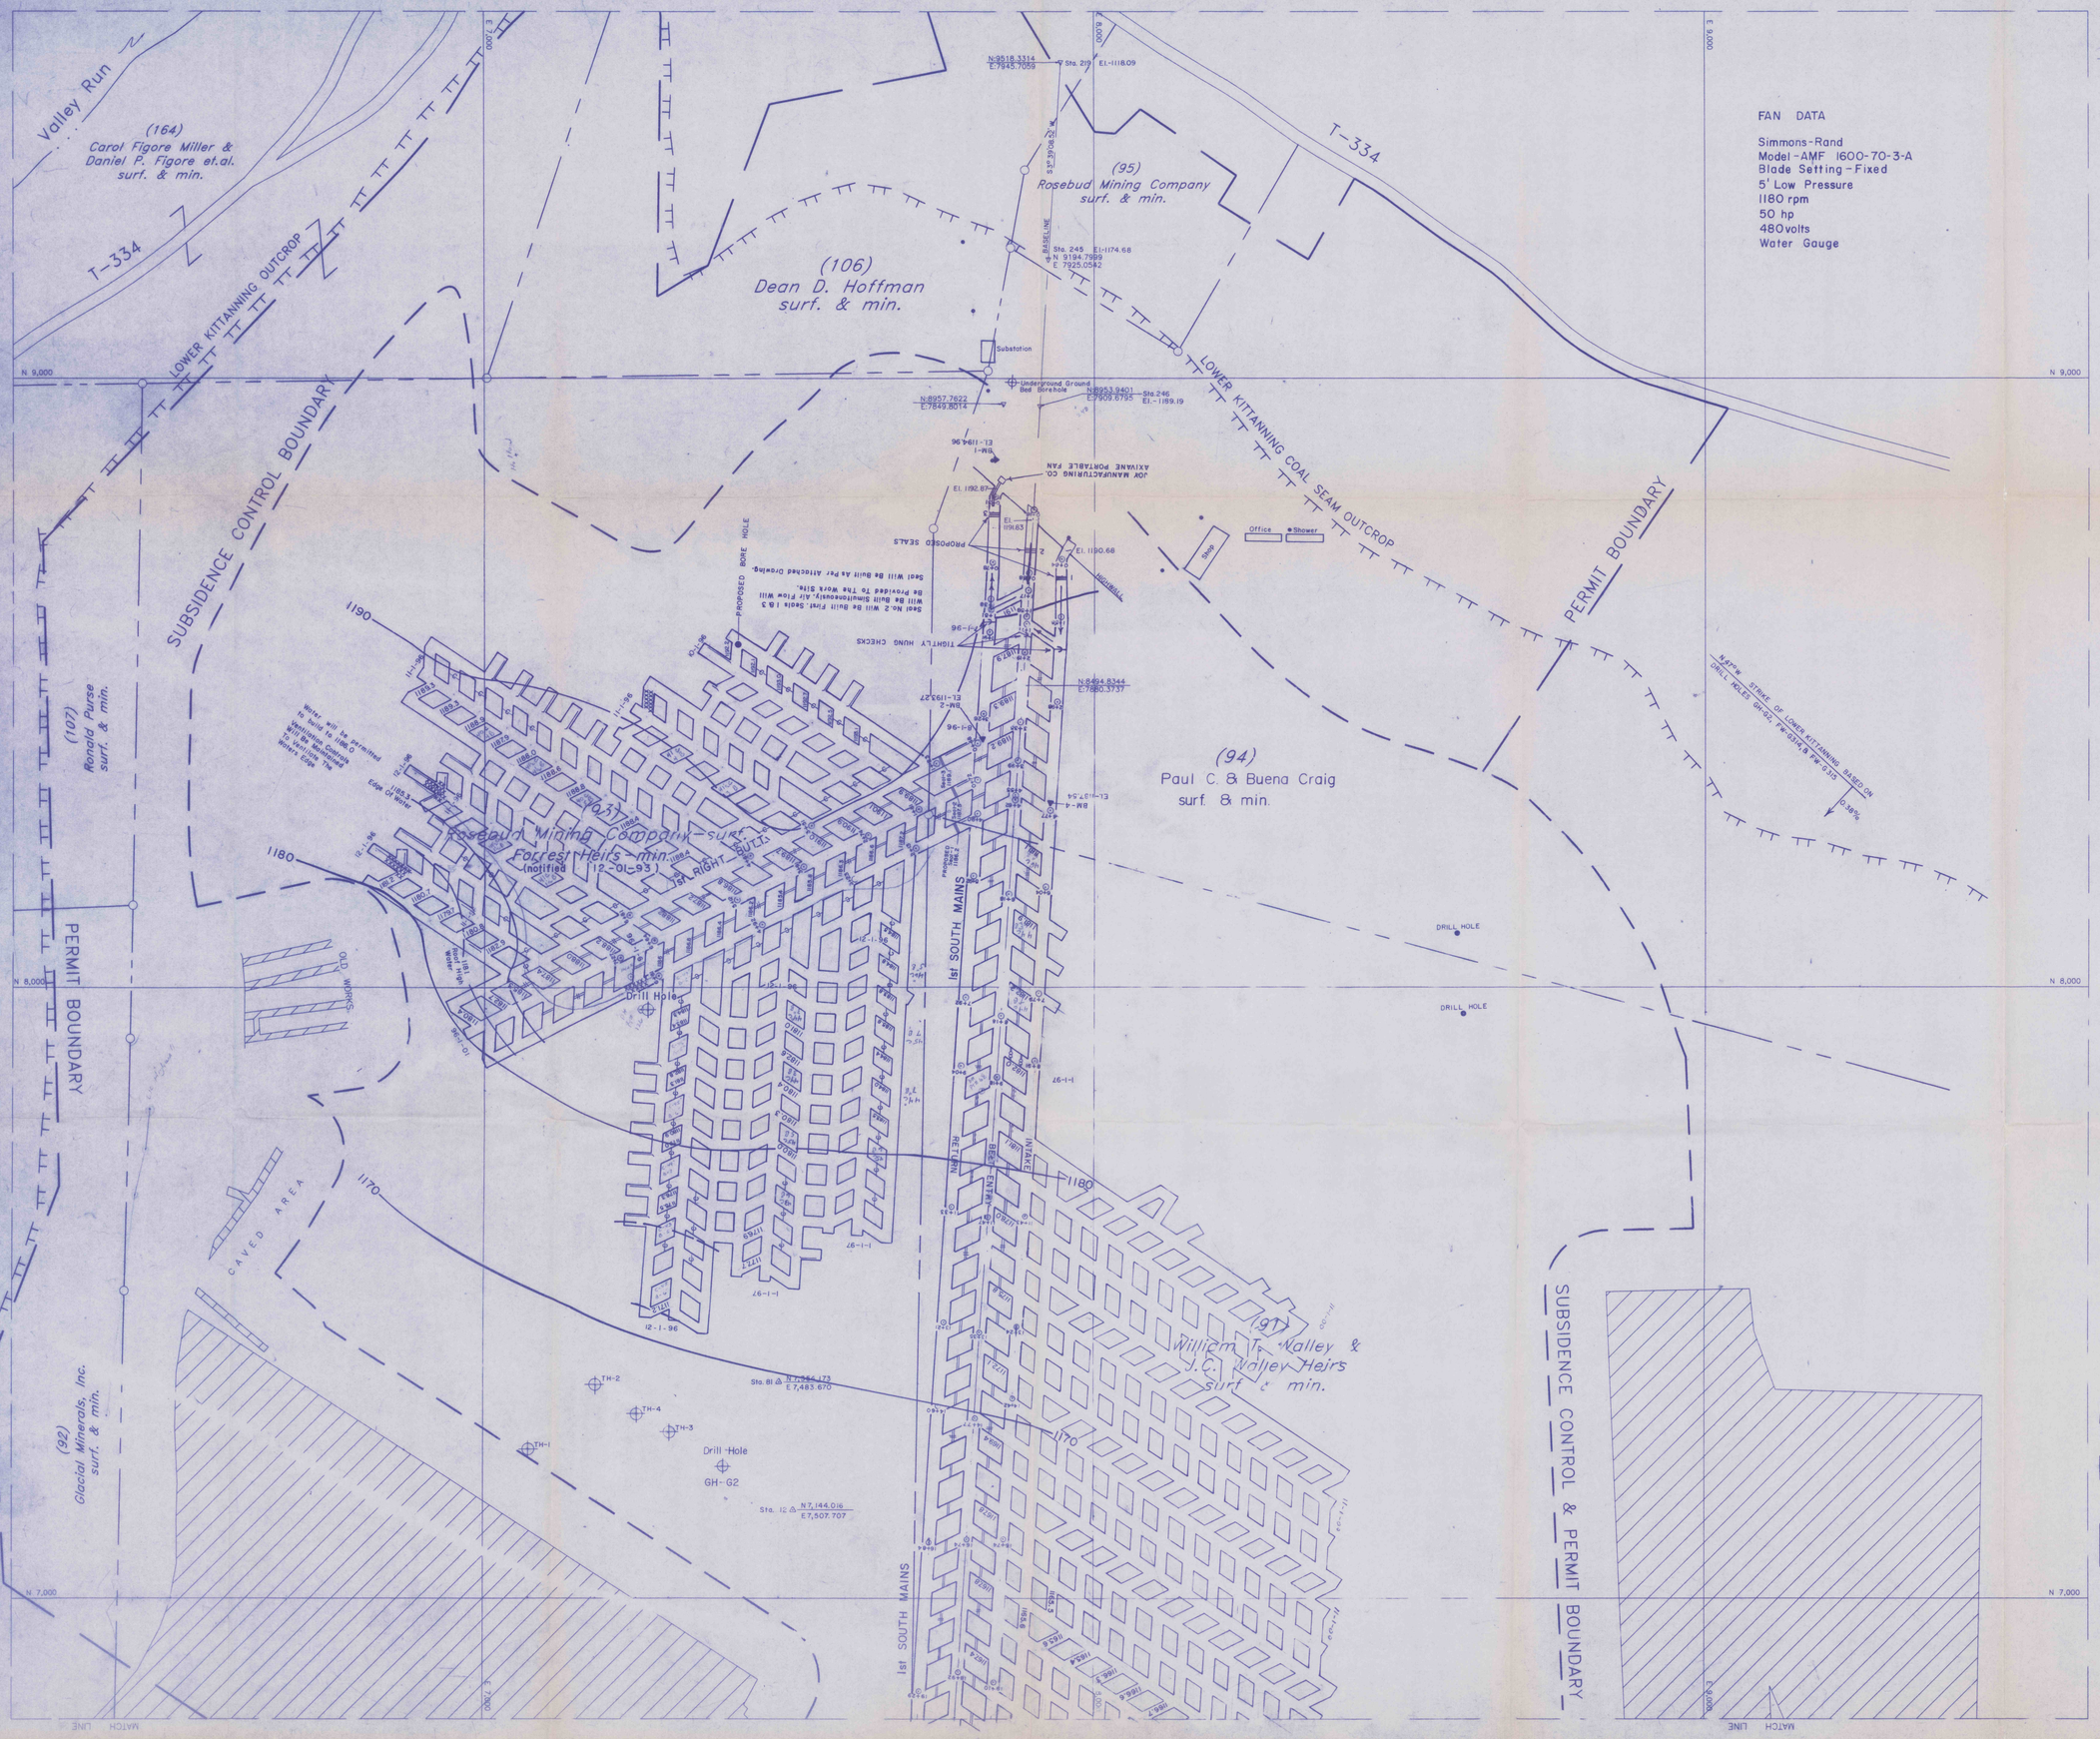

FAN DATA

Simmons-Rand
Model-AMF 1600-70-3-A
Blade Setting-Fixed
5' Low Pressure
1180 rpm
50 hp
480volts
Water Gauge

VAPCO ENGINEERING
P.O. Box 324 Rte. 210 & 119 Intersection Punxsutawney, PA 15767

LEGEND

- Regulator
- Proposed Air Flows
- Intake Air
- Return Air
- Belt Air
- Belt Line
- Permanent Stopping
- Check Curtain
- Proposed Stopping
- Doors
- Equipment Doors
- Seals
- Survey Station
- Permit Boundary
- Property Line
- Public Road
- Stream
- Mining Completed Area
- Contemplated Mining Area
- Projected Mining _____ TO _____
- Projection No. _____
- Survey Date 11-1-00

ESCAPEWAYS

- Primary Escapeway
- Secondary Escapeway

6/18/01

COMMONWEALTH OF PENNSYLVANIA
REGISTERED PROFESSIONAL
THEODORE J. BEARER, JR.
LAND SURVEYOR

Rosebud No.2 Mine
R.D.2, Box 324 B
Parker, PA 16049

6/15/01

FINAL MAP

MAP 75.372 & 75.1200

ROSEBUD MINING COMPANY

ROSEBUD NO.2 MINE
SHEET NO.1
PERRY TWP., ARMSTRONG CO.
LOWER KITTANNING COAL SEAM
SCALE: 1" = 100'
I.D. No. 36-08410

0' 100' 200' 300'

Person Responsible For Map: Joe Oberneder DATE: 11-1-00