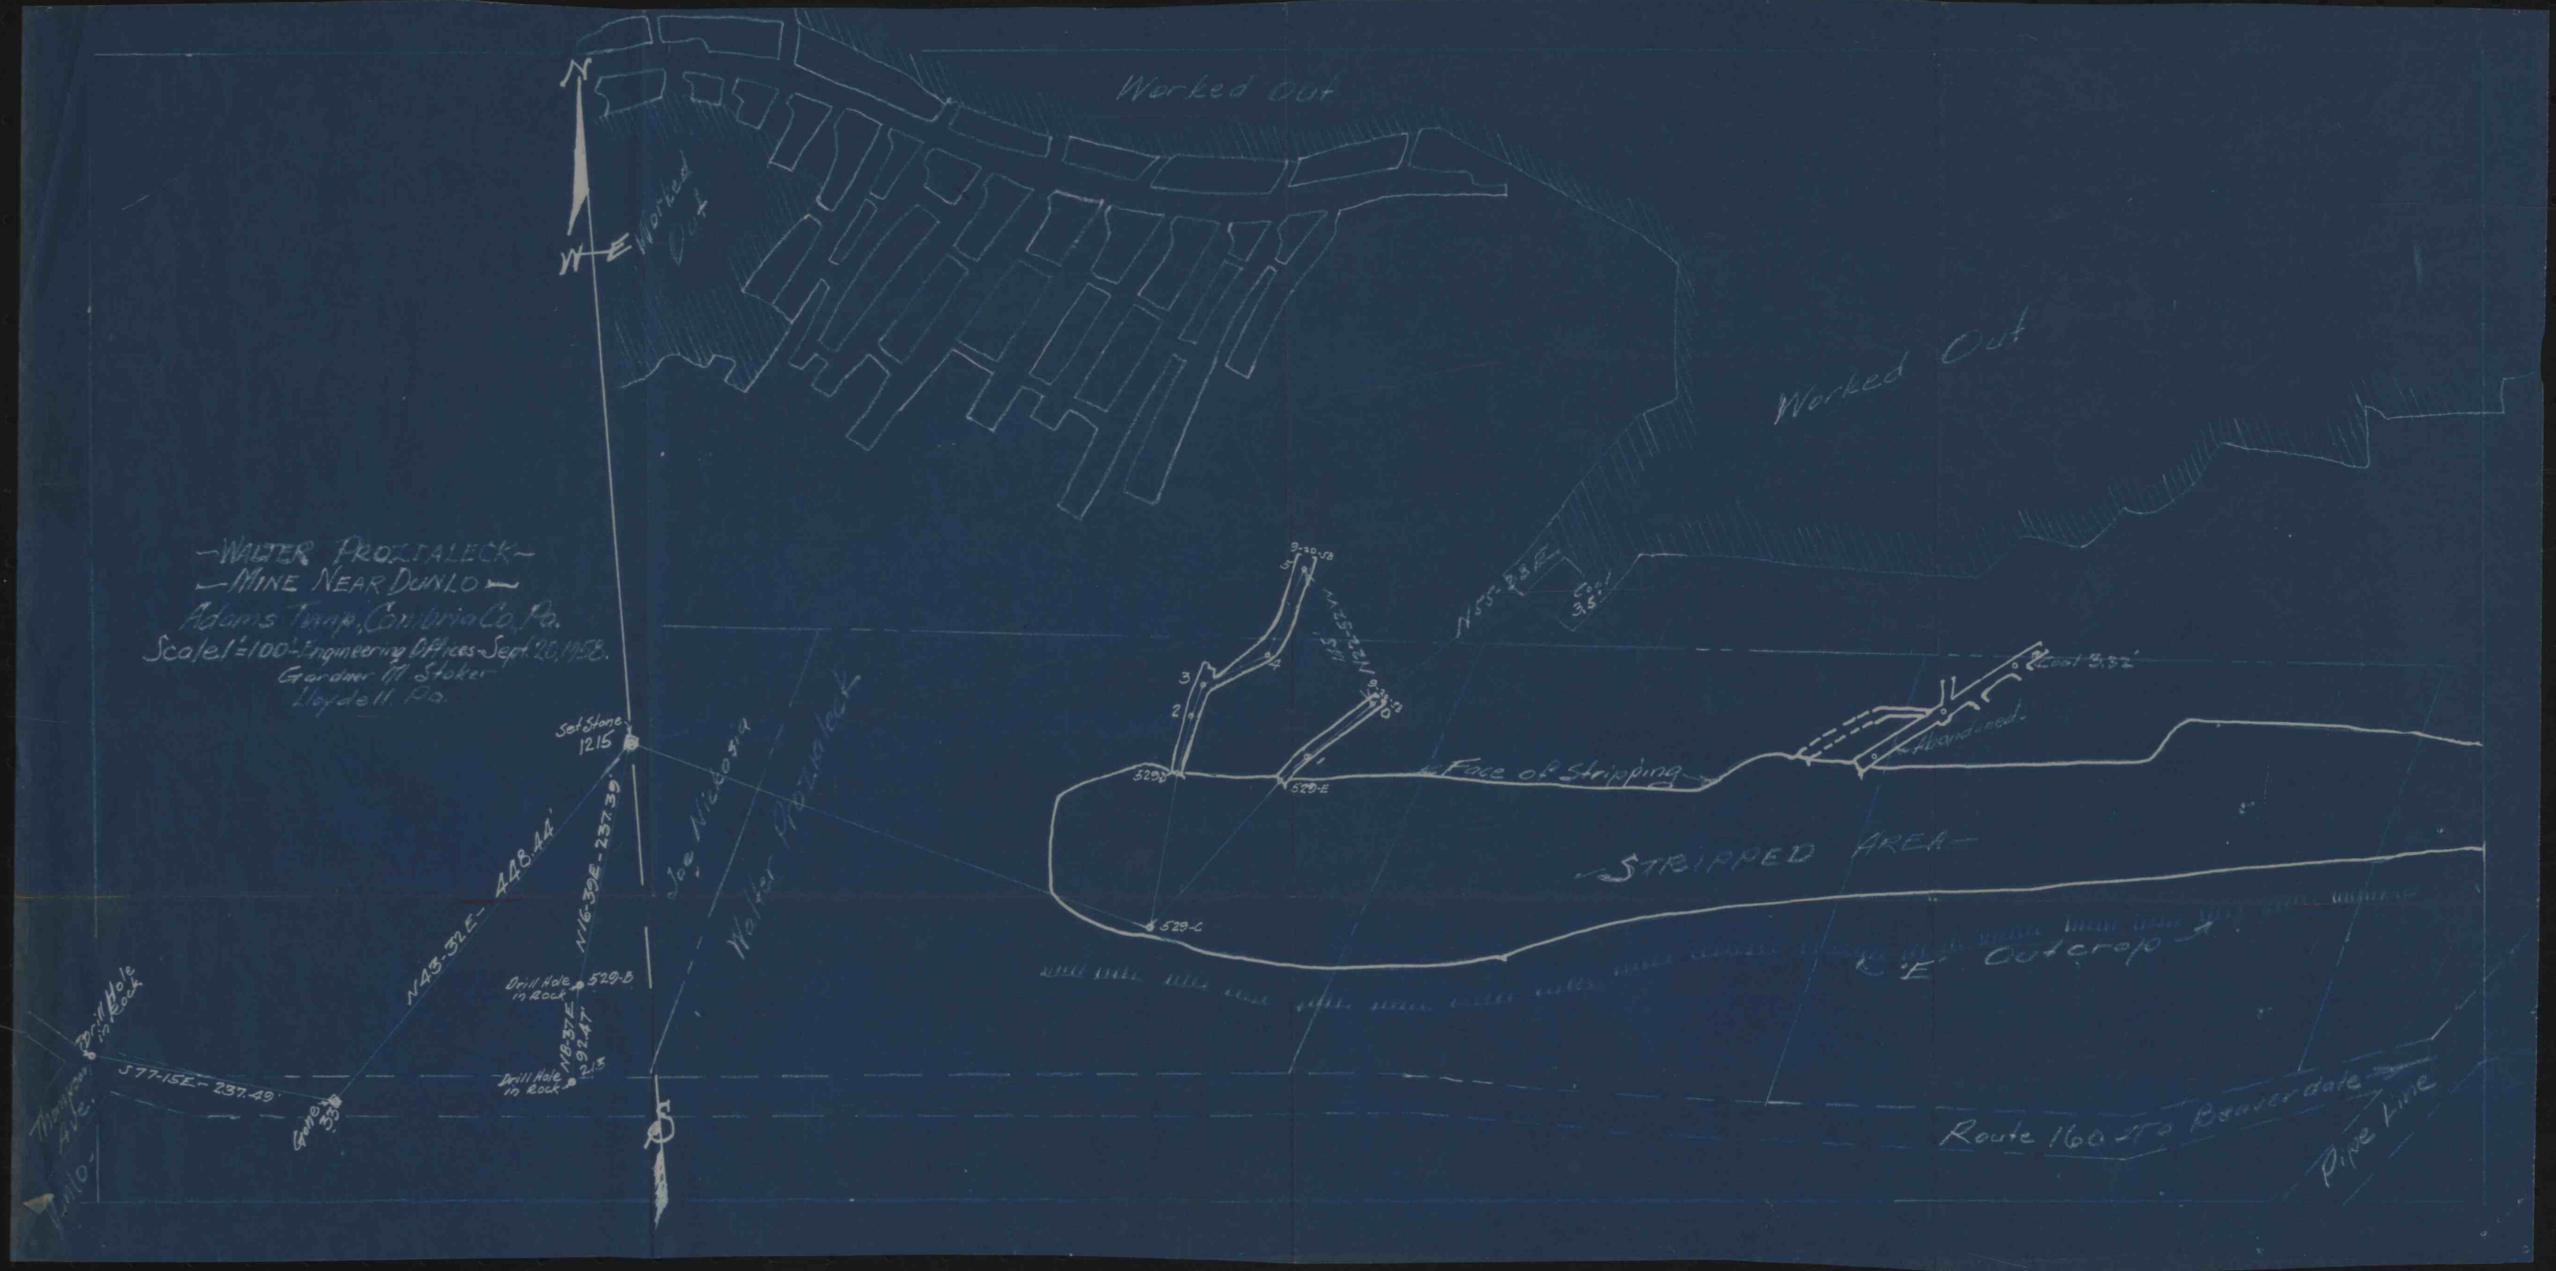

Worked Out
Worked Out
Worked Out
N
W
E
S
-WALTER PROZIALECK-
-MINE NEAR DUNLO-
Adams Twp, Cambria Co, Pa.
Scale 1"=100'-Engineering Offices-Sept. 20, 1958.
Gardner M. Stoker
Lloydell, Pa.
Set Stone 1215
N43-32E- 448.44'
N16-39E-237.39'
Joe Nickosia
Walter Prozialeck
Drill Hole in Rock 529-B
N8-37E 92.47'
Drill Hole in Rock 213
Drill Hole in Rock
S77-15E- 237.49'
Gone 33
Thompson Ave.
Dunlo
N55-23E
Coal 3.5'
Coal 3.32'
Abandoned
Face of Stripping
529-D
529-E
529-C
STRIPPED AREA
"E" Outcrop
Route 160 To Beaverdale
Pipe Line