


RESERVE

Don't Own

STOP

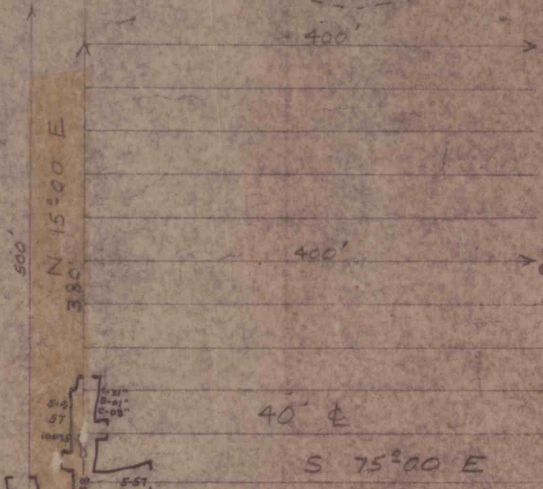

ELBERTON - 3 MI

Don't Own

N 82°00' E

N 15°00' E

N 75°00' W



Don't Own

(STRONG QUALITY COAL CO.)

E. & N. MINE

MAP OF MINE OPERATED BY LESTER WALKER - SHEL

Situated in PLUMCREEK TWP., ARMSTRONG CO., PA.

Surveyed Jan. 30, 1954 By J.C. Brillhart Scale: 1" = 100'

REVISED	7-23-55
"	5-12-56
"	5-4-57

E. & N. MINE