

FORMERLY
SOWERS & ELGIN

S 78°-50 E 684.75

POST

STONE

FORMERLY
D. YOUNT

N 32°-20 E 990.0

HICKORY

N 89°-40 E 429.0

FORMERLY
REARICK
PETER

0.8151


M. 07°-56 S

Branch of Hocking Run

Mine Drainage

47 A. 66 P.

FORMERLY
J. SHRUM

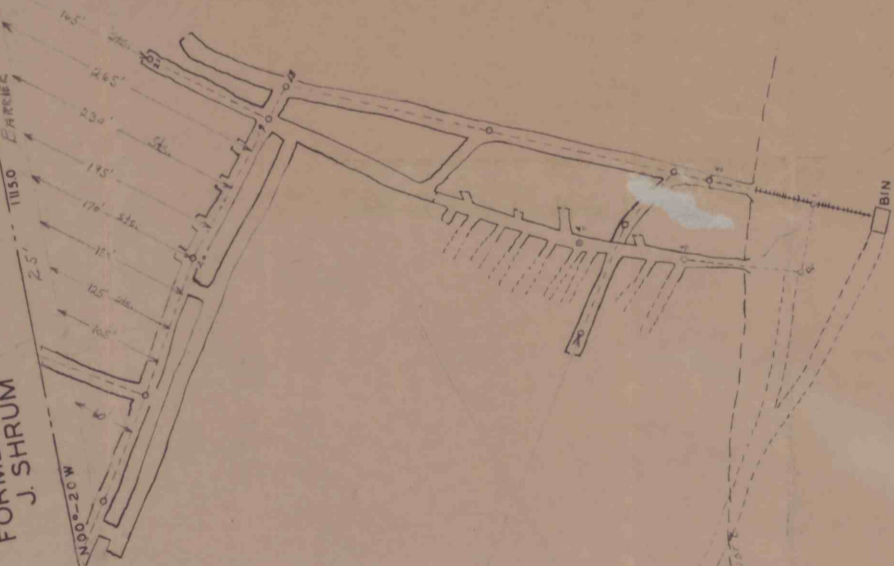

FORMERLY
UMBAUGH

N 88°-20 W 1155.0

OAK

W. OAK

05 21° 3 02°-00 S

1856 Annual
Armstrong Co. District 2
Smith Coal Co., George

ROSENBERGER MINE
OPERATED BY
GEORGE F. SMITH

KITTANNING & COWANSHANNOCK TWPS.,
ARMSTRONG COUNTY, PA. *Dist 2*
SCALE 1"=100'
MARCH, 1951
THOMAS PEALER - REG. ENGR.

Top Road to Margaret 1 1/2 Miles