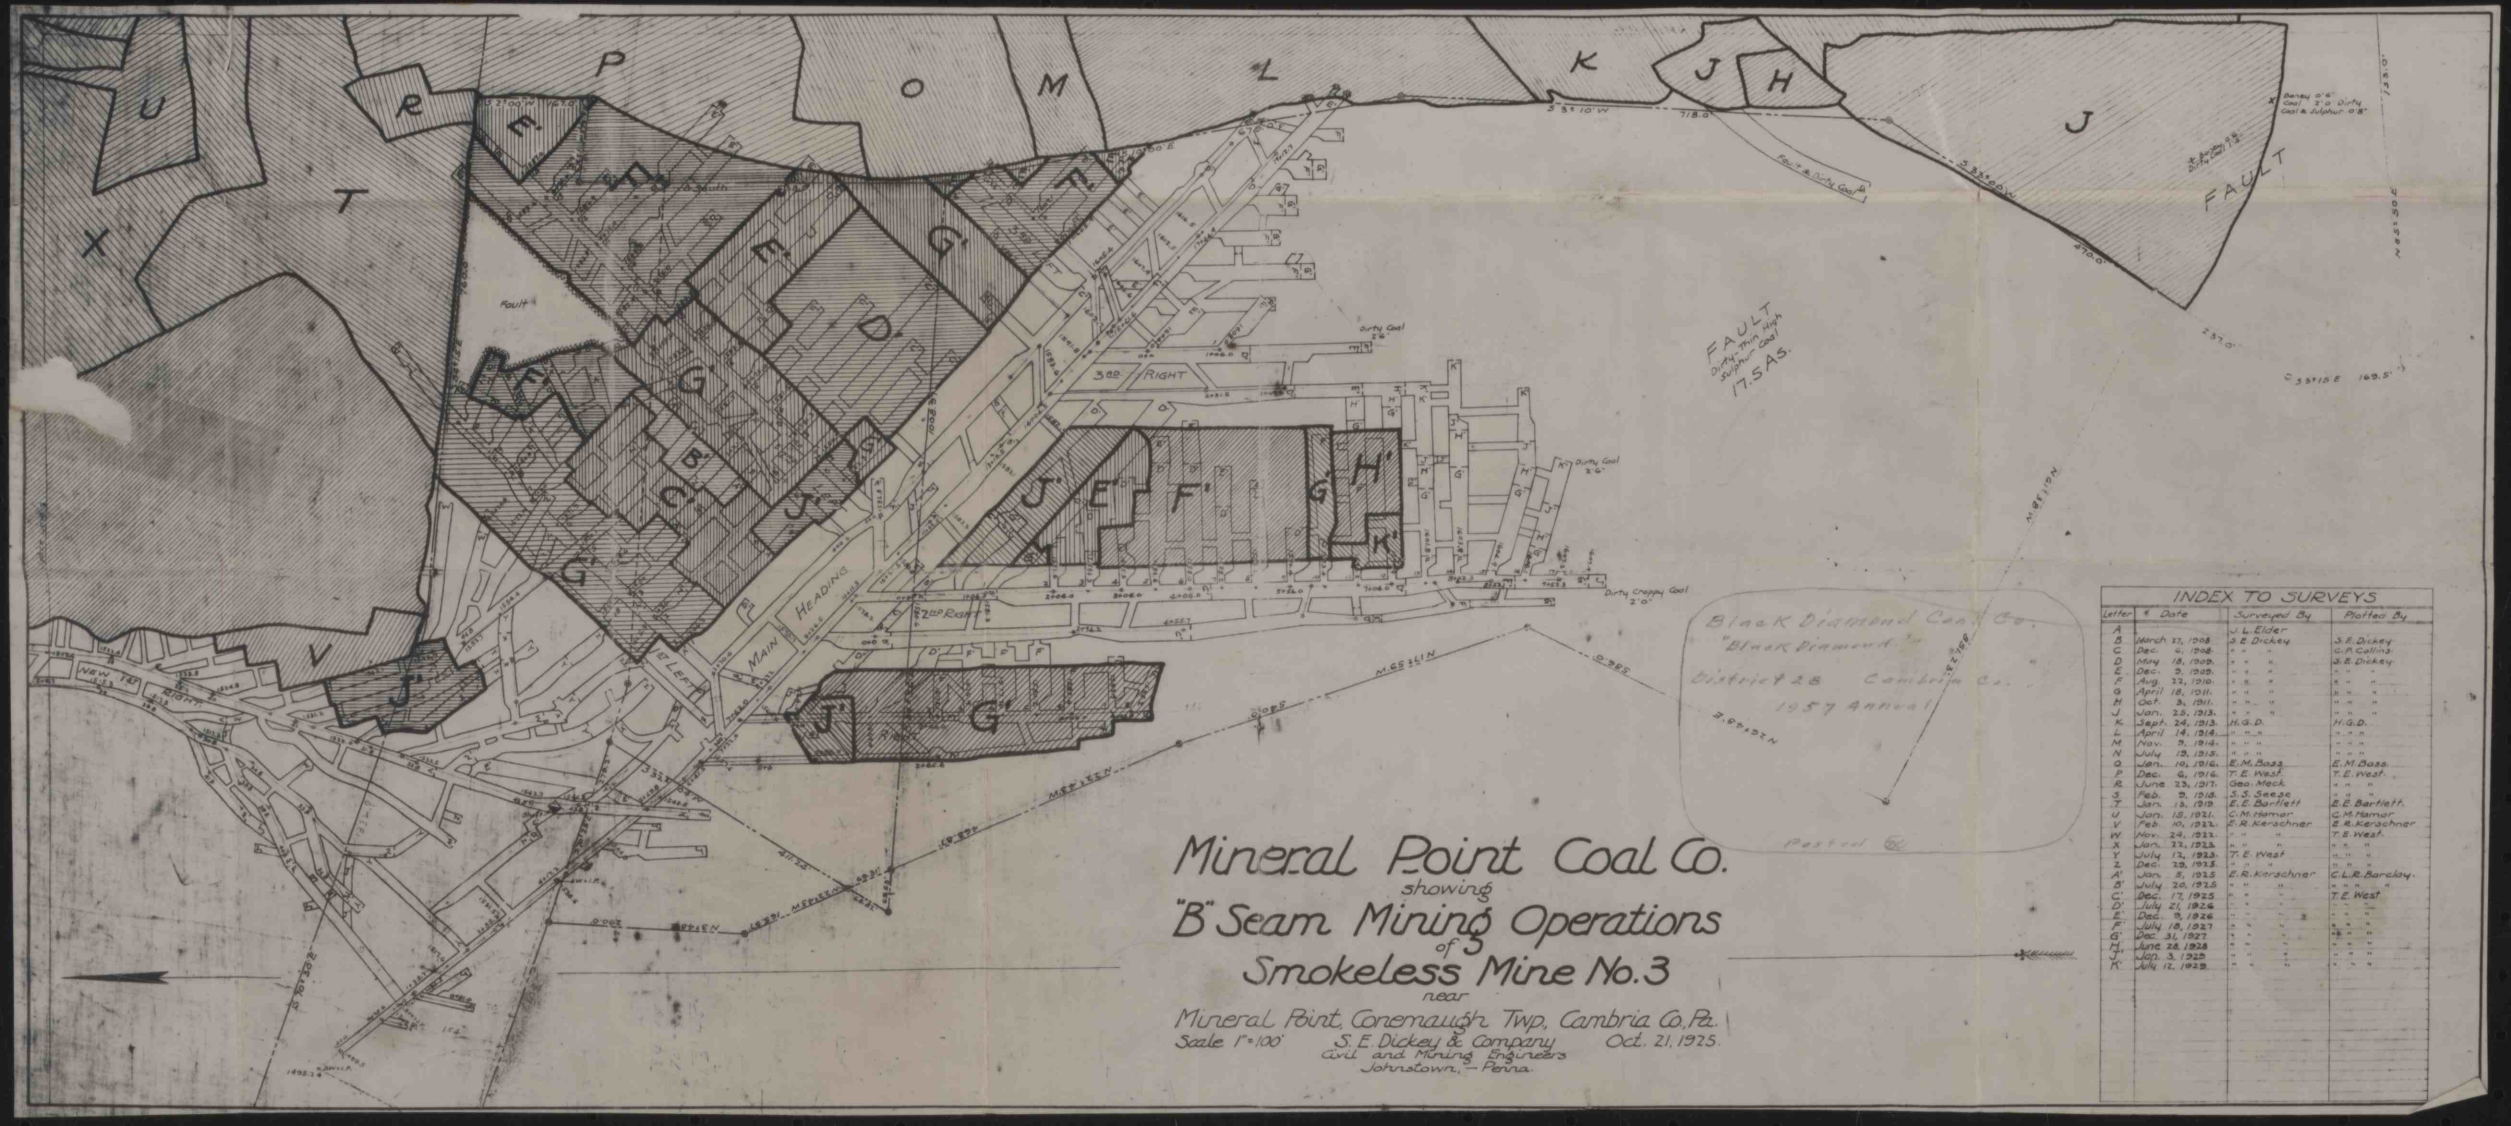

Mineral Point Coal Co.

showing

"B" Seam Mining Operations

of

Smokeless Mine No. 3

near

Mineral Point, Conemaugh Twp., Cambria Co., Pa.

Scale 1" = 100'

S. E. Dickey & Company
Civil and Mining Engineers
Johnstown, — Penna.

Oct. 21, 1925.

INDEX TO SURVEYS

Letter	Date	Surveyed By	Plotted By
A		J. L. Elder	
B	March 17, 1908	S. E. Dickey	S. E. Dickey
C	Dec. 4, 1908	" "	C. P. Collins
D	May 18, 1909	" "	S. E. Dickey
E	Dec. 3, 1909	" "	" "
F	Aug. 23, 1910	" "	" "
G	April 18, 1911	" "	" "
H	Oct. 3, 1911	" "	" "
J	Jan. 28, 1913	" "	" "
K	Sept. 24, 1913	H. G. D.	H. G. D.
L	April 14, 1914	" "	" "
M	Nov. 5, 1914	" "	" "
N	July 19, 1915	" "	" "
O	Jan. 10, 1916	E. M. Bass	E. M. Bass
P	Dec. 6, 1916	T. E. West	T. E. West
R	June 23, 1917	Geo. Meek	" "
S	Feb. 5, 1918	S. S. Seese	" "
T	Jan. 15, 1919	E. E. Bartlett	E. E. Bartlett
U	Jan. 15, 1921	C. M. Hamer	C. M. Hamer
V	Feb. 10, 1921	E. R. Kerschner	E. R. Kerschner
W	Nov. 24, 1921	" "	T. E. West
X	Jan. 23, 1923	" "	" "
Y	July 12, 1923	T. E. West	" "
Z	Dec. 28, 1923	" "	" "
A'	Jan. 5, 1925	E. R. Kerschner	C. L. R. Barclay
B'	July 20, 1925	" "	" "
C'	Dec. 17 1925	" "	T. E. West
D'	July 21, 1926	" "	" "
E'	Dec. 9, 1926	" "	" "
F'	July 18, 1927	" "	" "
G'	Dec. 31, 1927	" "	" "
H'	June 28, 1928	" "	" "
J'	Jan. 3, 1929	" "	" "
K'	July 12, 1929	" "	" "