


N

William Rose Tr.

W. Hill
Abundant
Crest

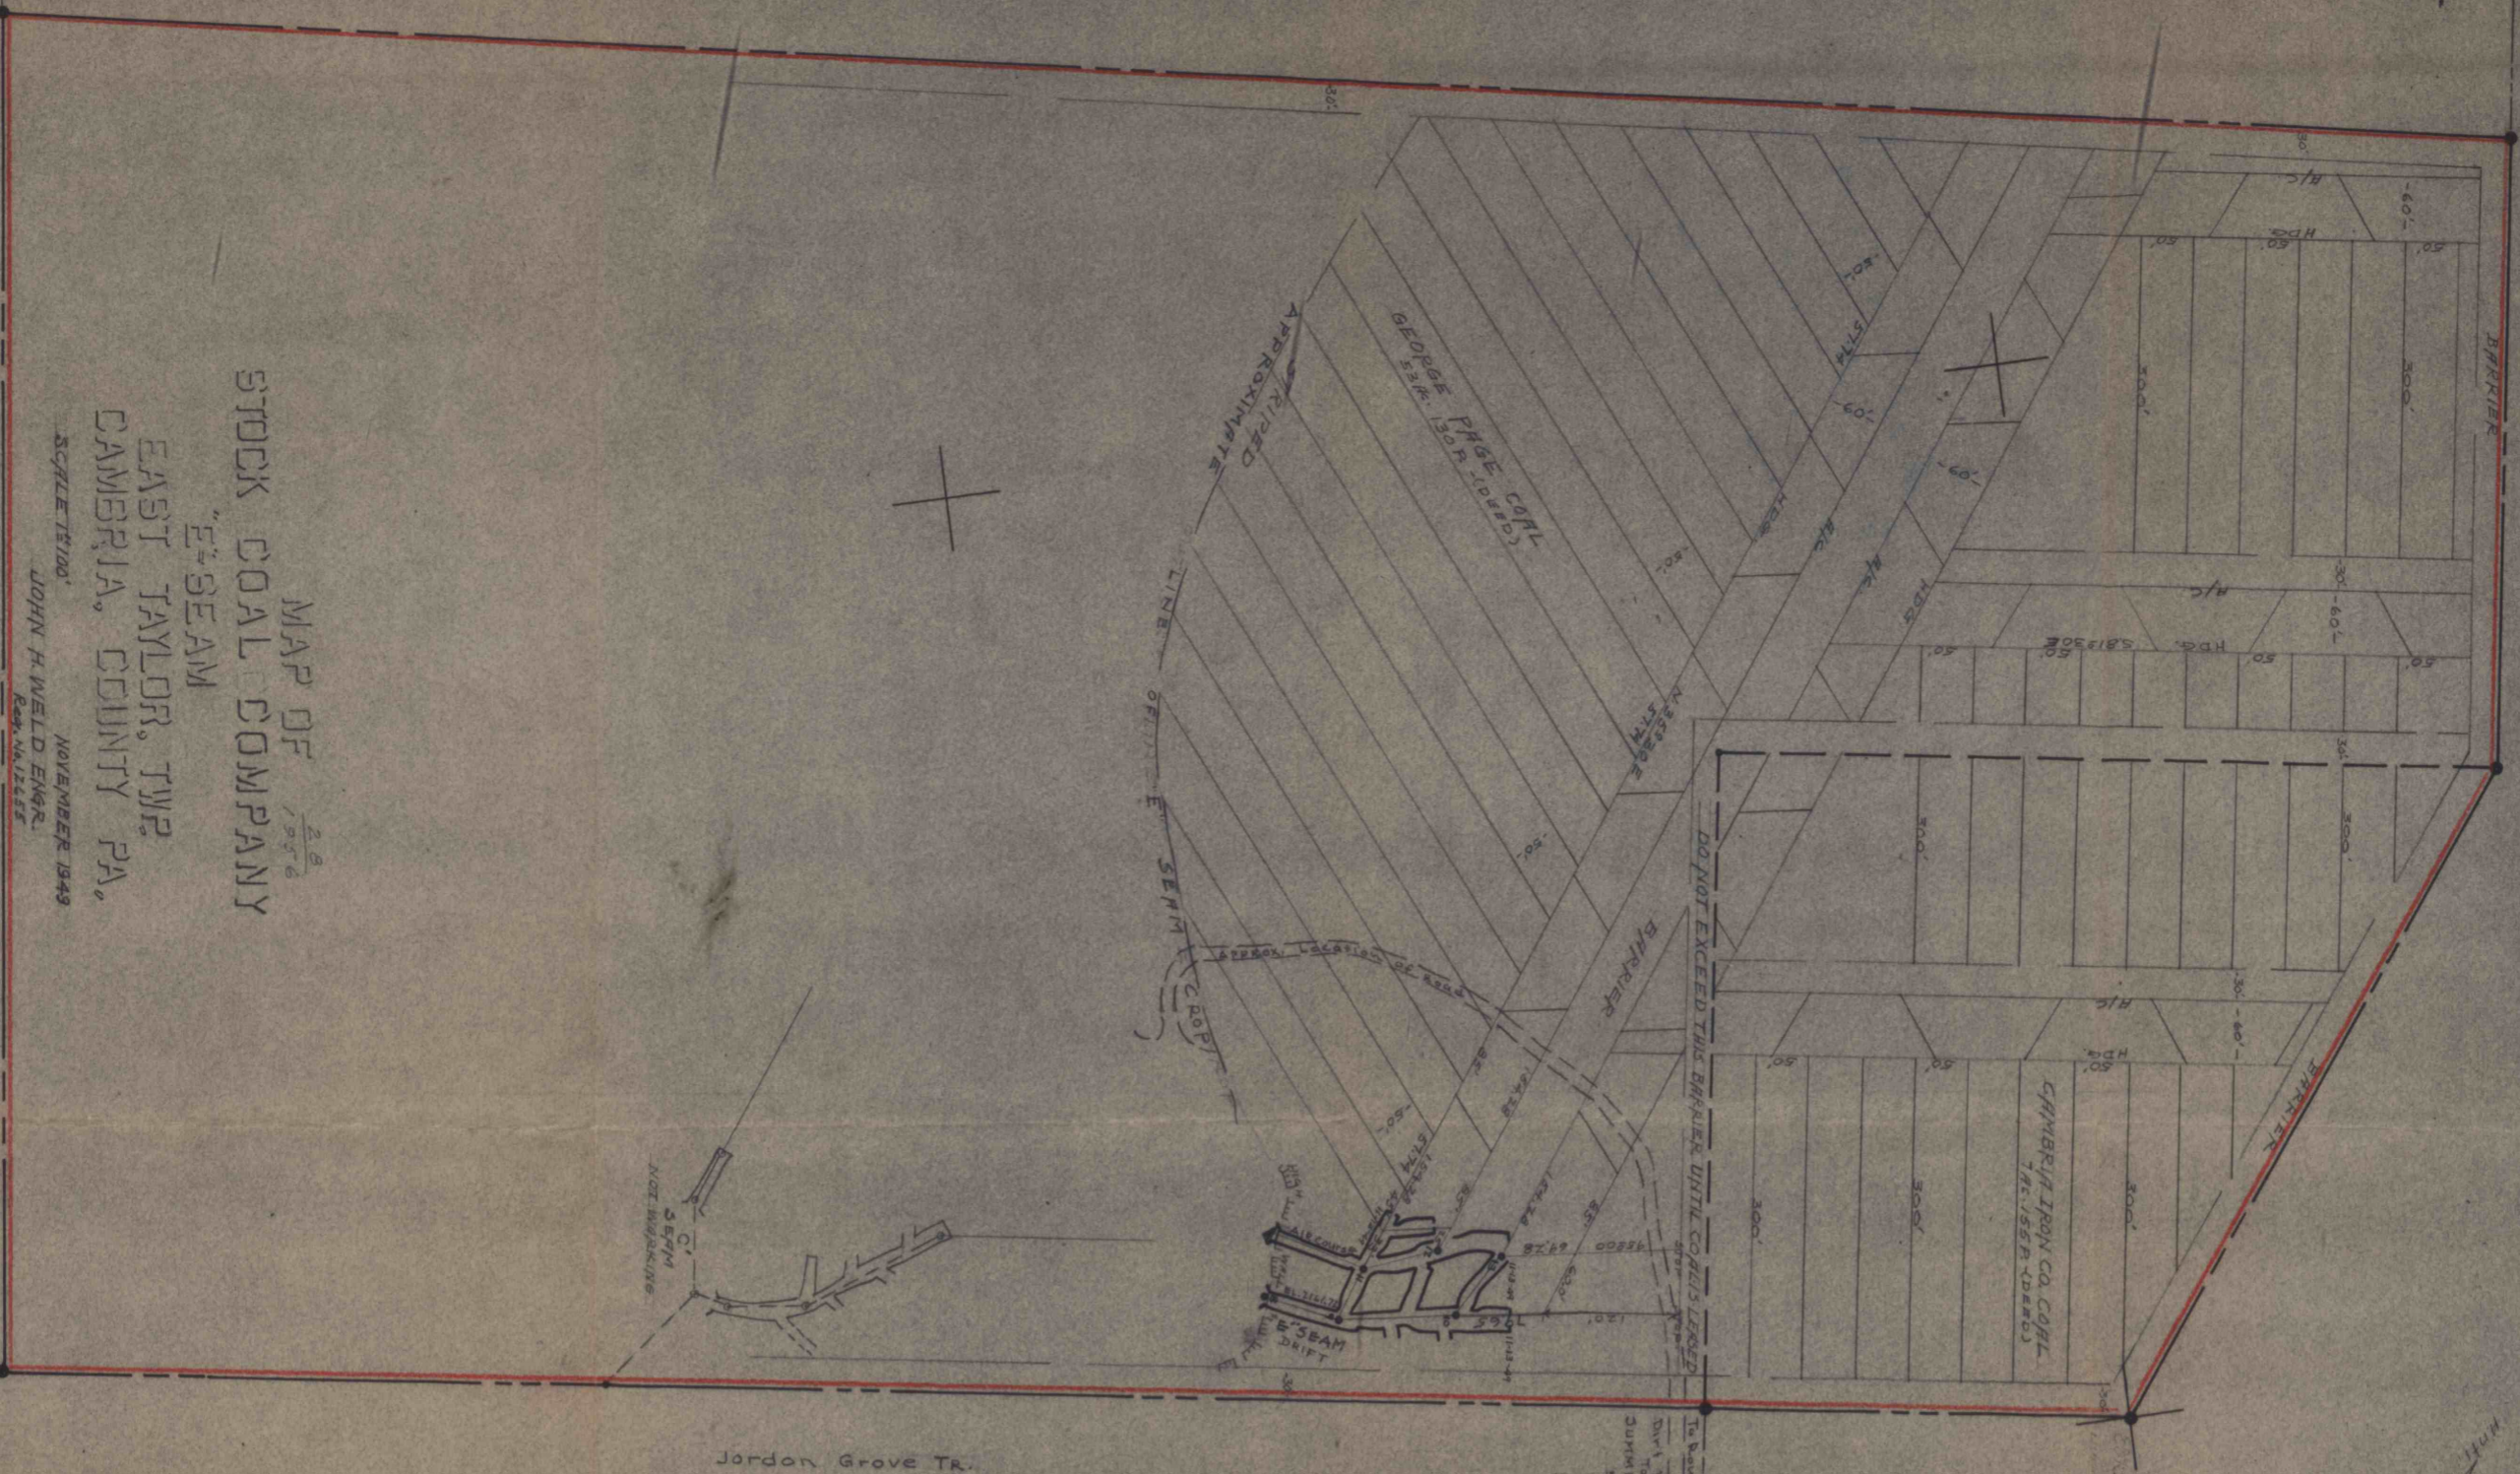

MAP OF
STOCK COAL COMPANY

"E-SEAM"
EAST TAYLOR, TWP

NOVEMBER 1949
JOHN H. WELD ENGR.
Res. No. 12255

John Durso Tr.



©