


MAP
 SHOWING POSITION OF
 RICHLAND ROAD
 AND
 SUGAR RUN MINE WORKS
 DEAN TOWNSHIP
 CAMBRIA CO., PA.
 SCALE 1"=100'

Frost Hollow
 Sept. 1925

W. H. F. ...
 DEAN TOWNSHIP

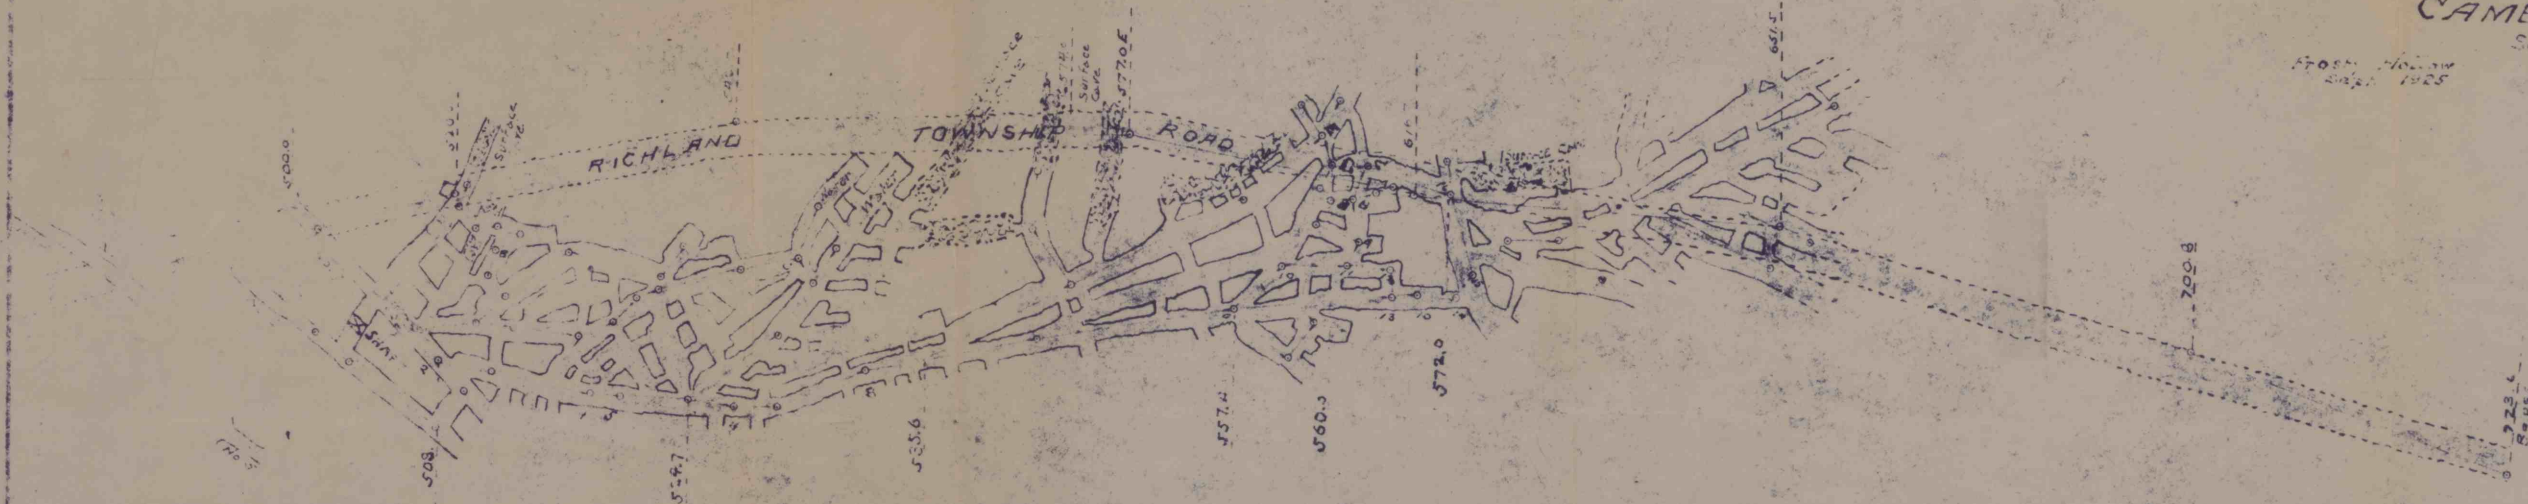

Link Coal Company
 Herman Link
 Dept., R. H. 1
 Pa.

18-1356

Post-d-10-15-1956