


ESEAM OUT GRAB

MATTHEW GLASS

JOHN LANTZY

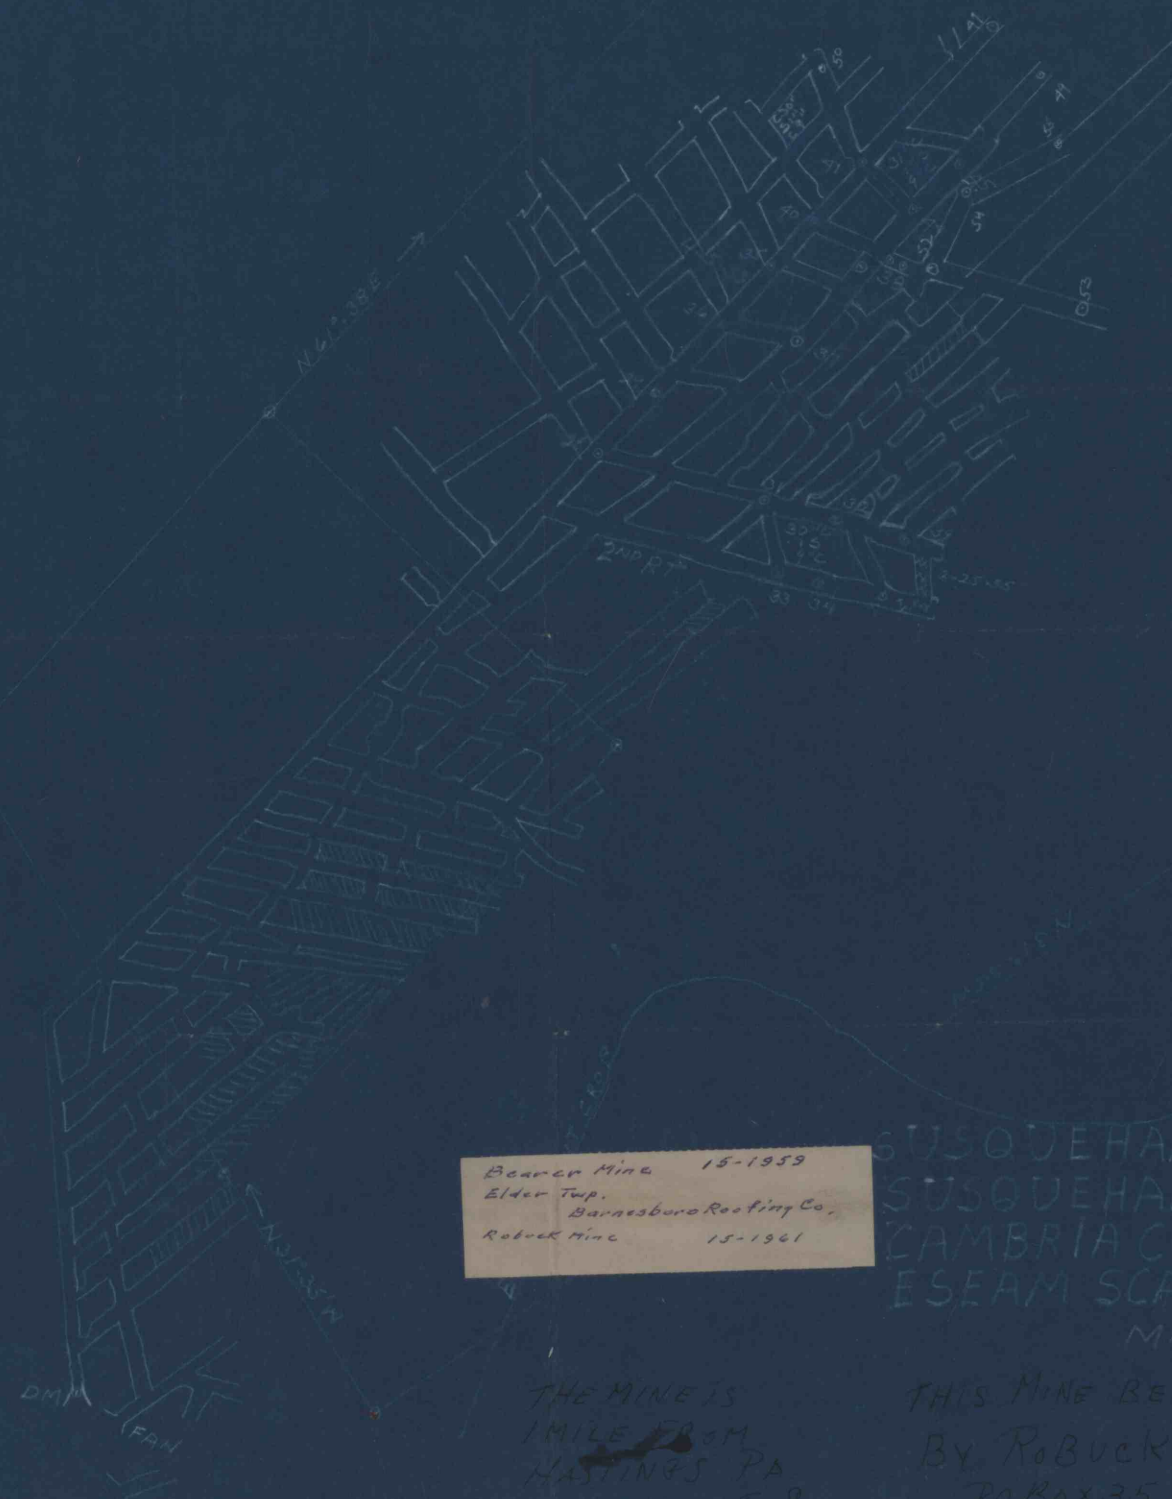

Bearce Mine 15-1959  
 Elder Twp.  
 Barnesboro Roofing Co.  
 Robuck Mine 15-1961

 CAMBRIA CO. PENNA.  
 ESEAM SCALE 1"=100'

MAY 1956

THE MINE IS  
 1 MILE FROM  
 HASTINGS PA  
 ON THE ROAD TO SPANGLER PA.

THIS MINE BEING RUN  
 BY ROBUEK COAL CO.  
 TO BOX 35  
 BARNESBORO PA.

Dist. 15

August 1955