

GEO. POPE TR (C.B.C. DEAL)

SOMERS BROS SUR

CHAS POPE TR

LECHENE

SWOPE

ALBERT C PRIME CREEK


LECHENE

SWOPE

WATER

CHAS POPE TRACT

CHAS POPE TRACT

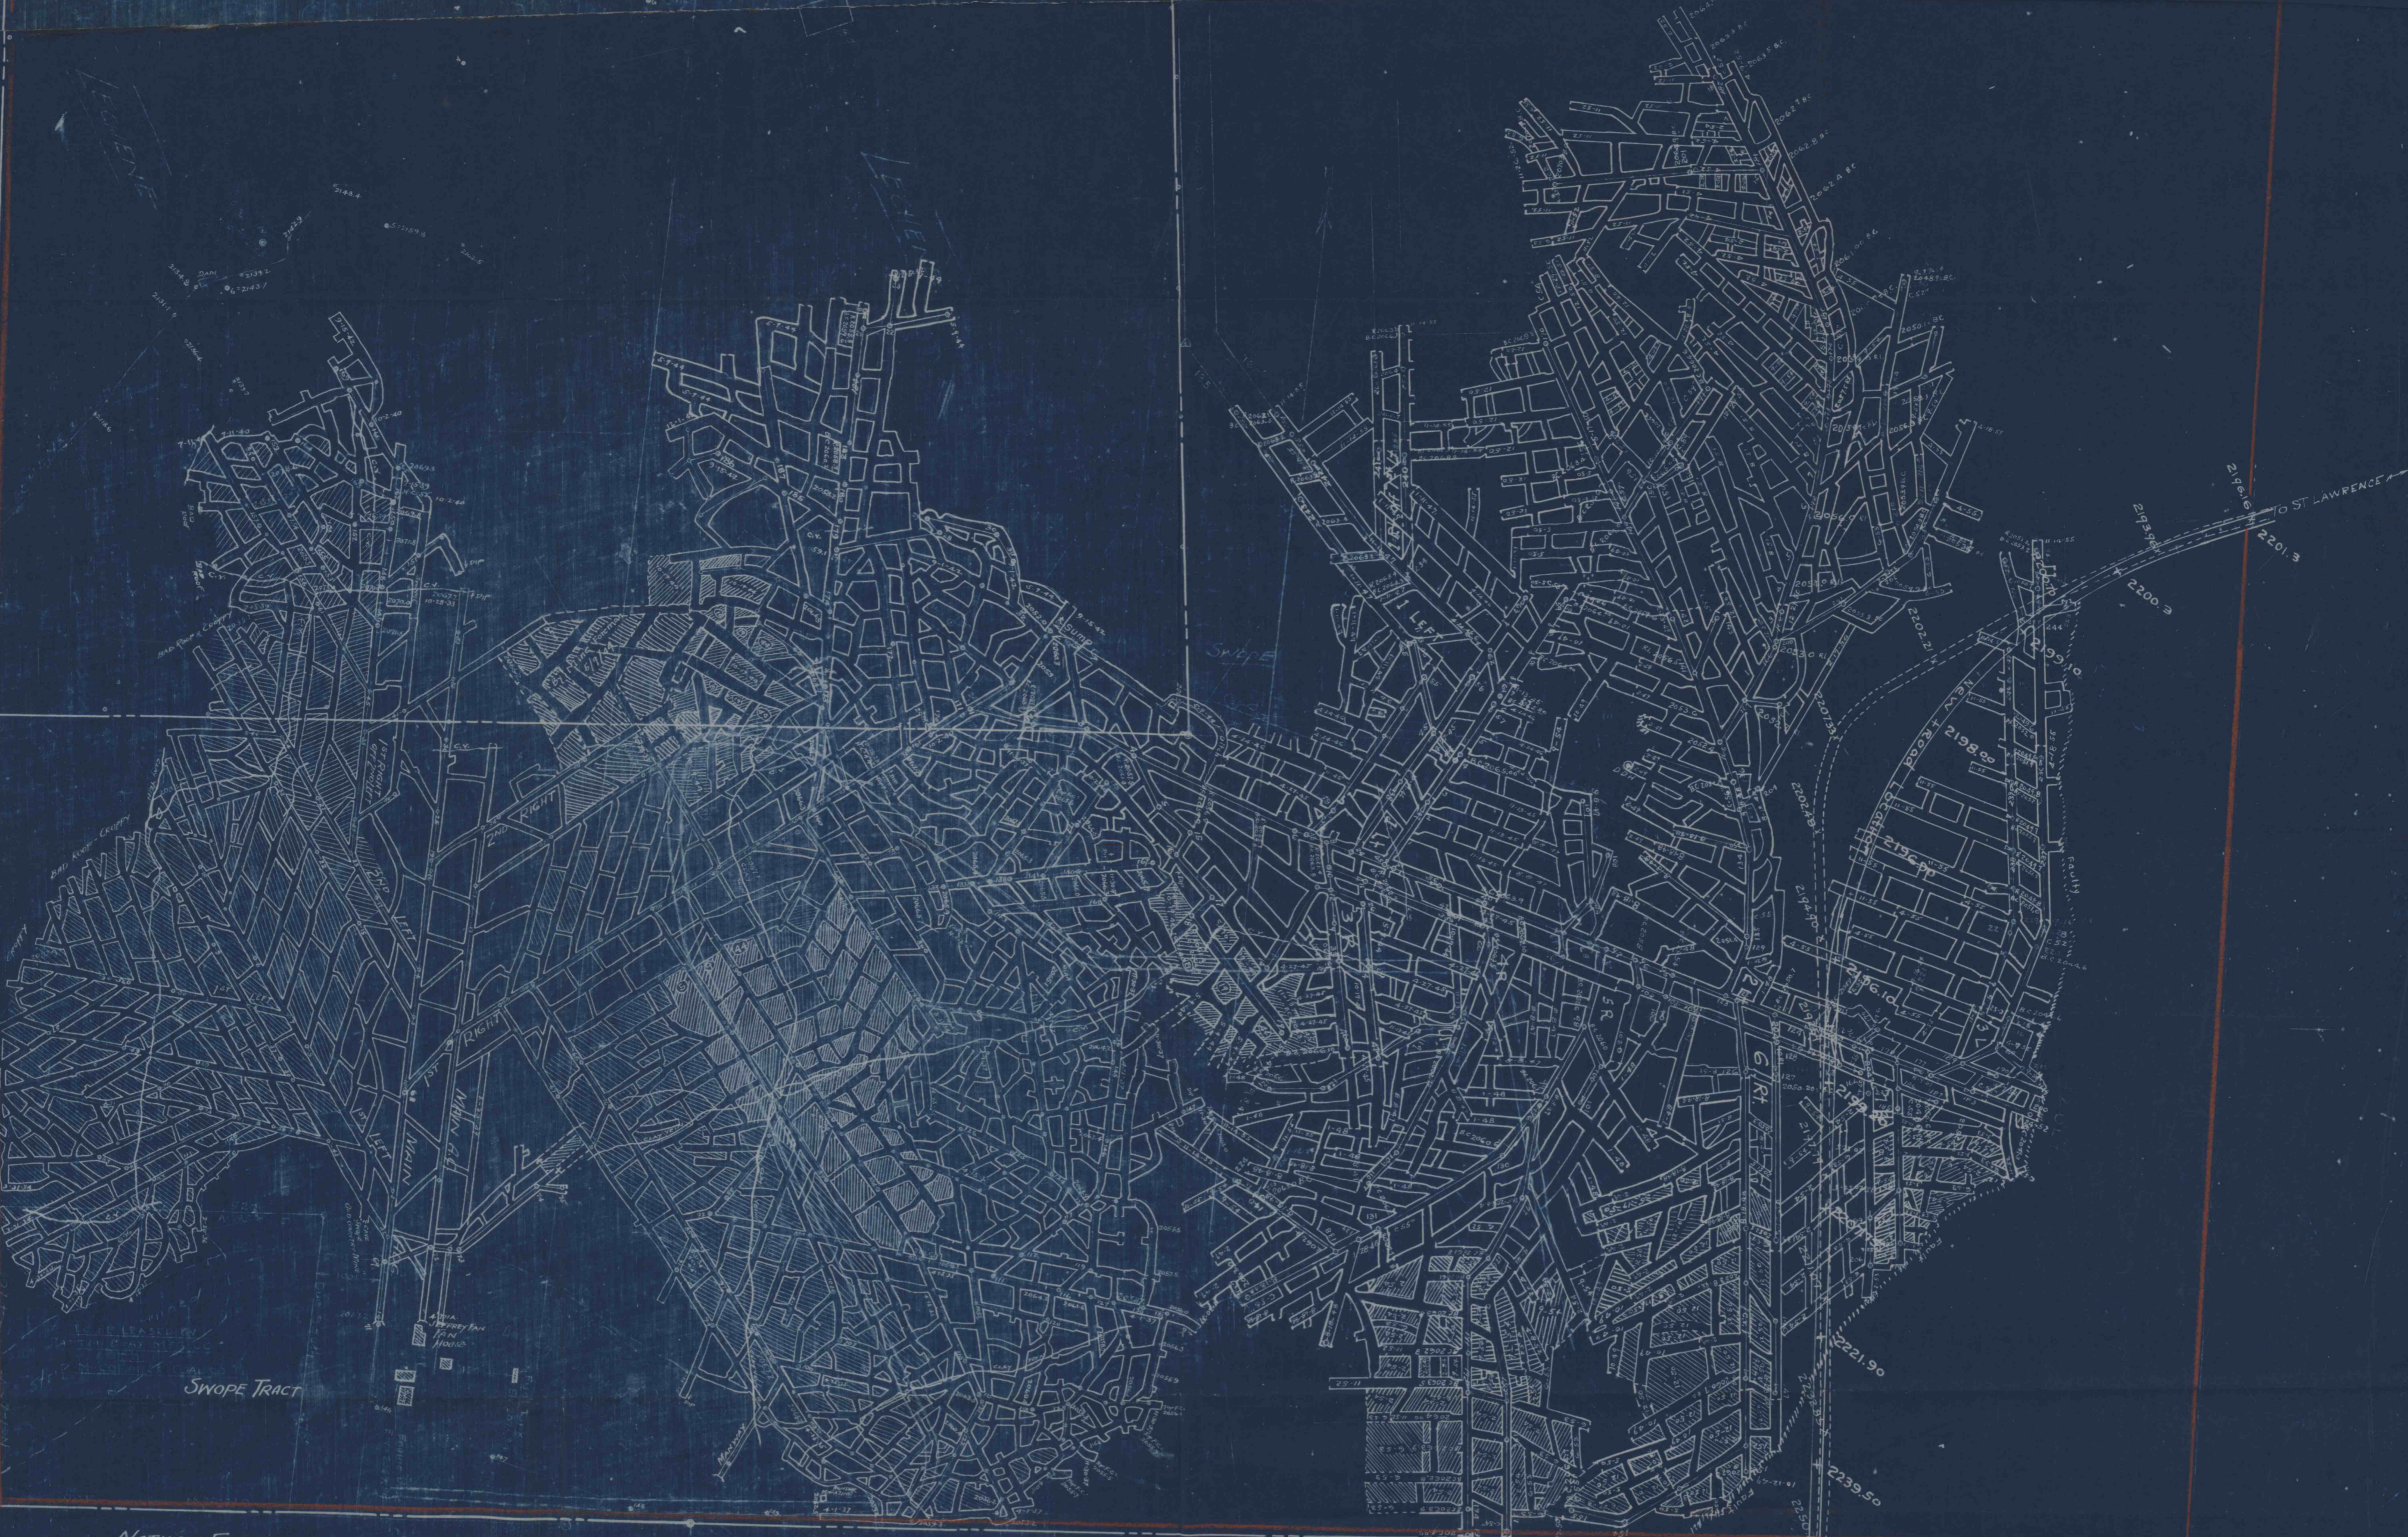

NATHAN FOSTER (C.C.C. CONVEYOR)

PATTON CLAY MFG. CO. MAP of No. 1 MINE

SCALE 1"=100' PATTON PA. NOV. 1ST 1933

C PRIME SEAM

Dated 12 1886
Charles Clay Mfg. Co.
Patton Clay Mfg. Co.

Wentz Tr.

ROAD HIGHWAY TO PATTON
STATE HIGHWAY ROUTE 11024