STEVENS PROPERTY LINE N84° 5'W

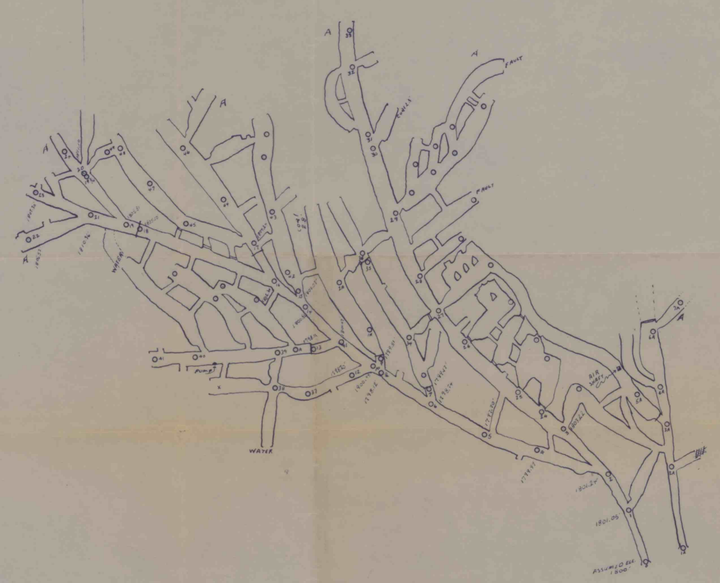

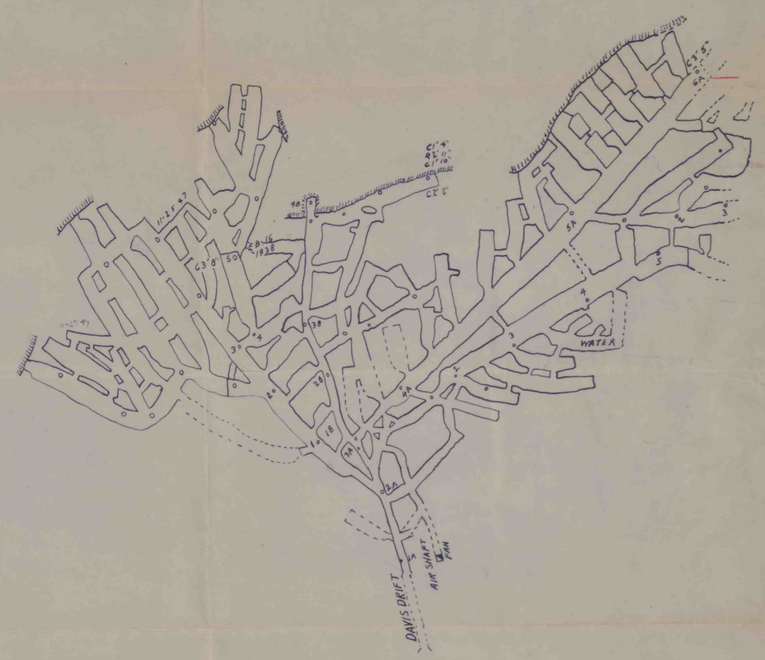

TOWNSHIP ROAD TO THE RICHLANDS

HIGHWAY ROUTE 53 TO ALTOONA

Link Coal Co.
Link No. 2
18-1960

Curry Coal Co.
Star No. 1
District 18 1959 Annual

Cavalet & Zimmerman
Juniata, Altoona, Pa.
Star No. 1 District 18
1956 Annual Cambria Co.

Zimmerman Coal Co., D.P.
Star #1
district 18 1957 Annual
Posted 9-11-1958

Operated To Sept. 1, 1956

STAR COAL COMPANY

MINE WORKINGS IN THE "B" SEAM
DEAN TOWNSHIP, CAMBRIA COUNTY,
PENNSYLVANIA. SCALE 1"=100'

NOW ZIMMERMAN COAL CO., D. P.
822- 4th Ave. - Juniata
Altoona, Pa.

INDEX TO MINE SURVEYS

LETTER	DATE	SURVEYED BY	PLATTED BY
A	4/1/52	[illegible]	[illegible]