


LEGEND
 DOTTED AREA
 COAL MINING
 SUPPORT AREA
 PROTECTED STRUCTURE
 MINING COMPLETED

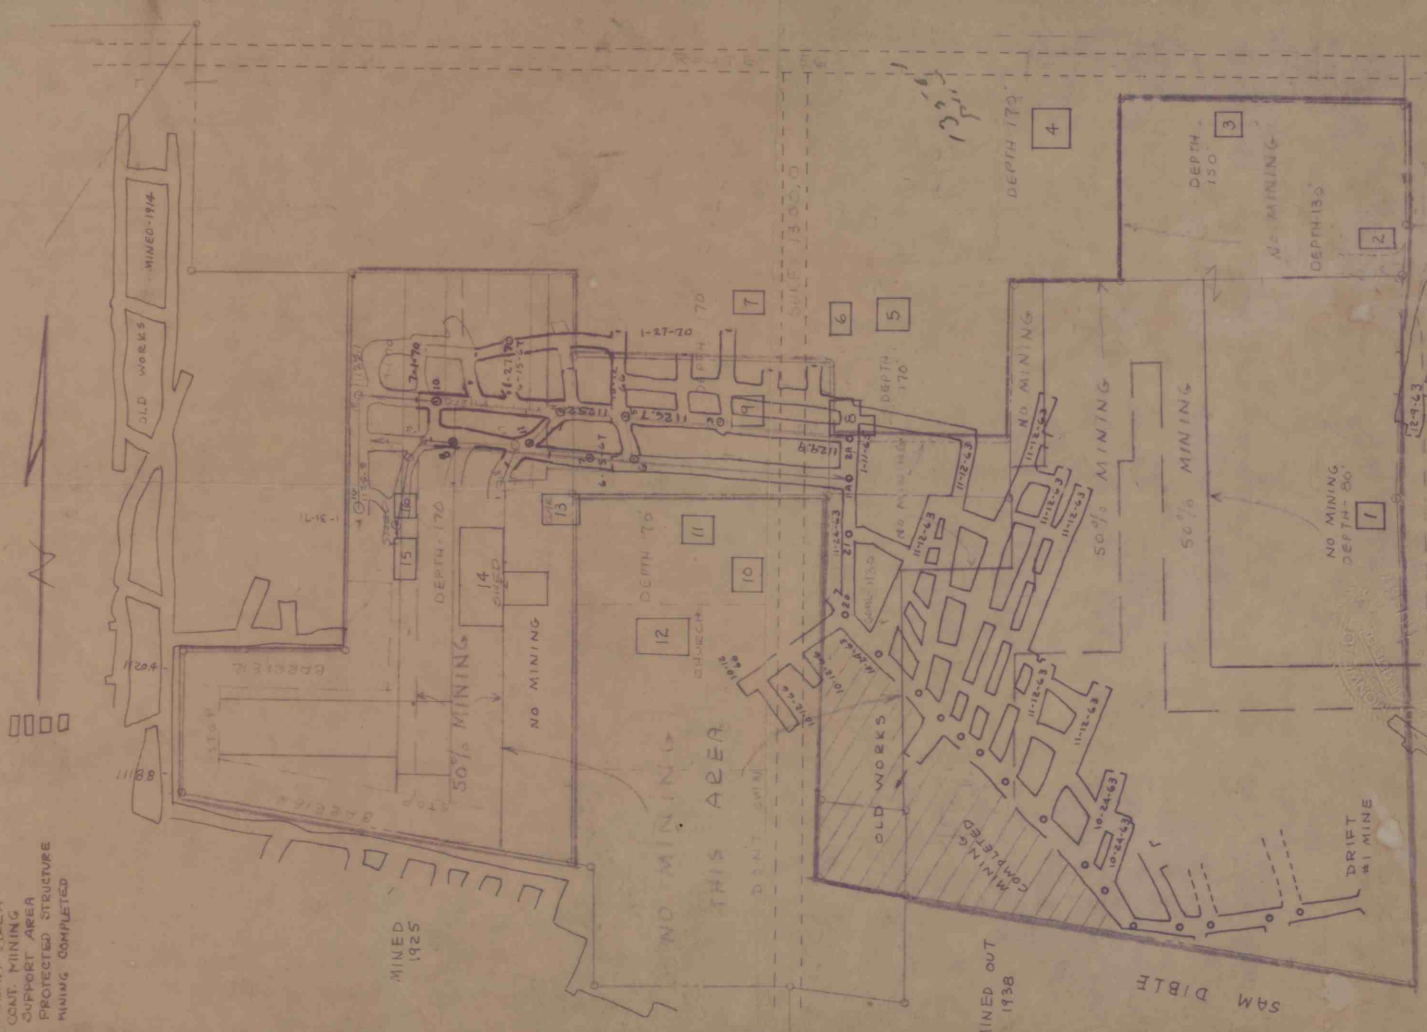

McCRACKEN COAL CO.
 McCracken #1 Mine
 Young, Twp, Indiana Co., Pa.
 Scale 1" = 100'
 Revised 3 - June 15, 1967
 1913, 60 - Dec. 15, 1967

J. Q. SMITH

Revised for 27, 1968
 Posted June 15, 1968 (No Mining) 2-22-71
 1-27-70

Charles S. Kautsky