

RICHARD M^cCOY

PENNA. STATE HIGHWAY ROUTE NO 857


APPROX LINE of old WORKS

SAMUEL HEGARTY EST.

THOMAS SHROCK (cont)
M. MEGLYNN (cont)

M. MEGLYNN

D Seam Coal out crop

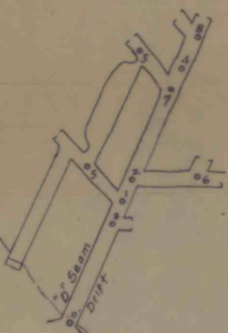

THOMAS SHROCK



YORKSHIRE COAL Co.
MADERA, PA.
MAP OF MINE dist. 27
BECCARIA TWP, CLFD. CO, PA 27
SCALE 1"=100'
CLEARFIELD, PA. ROY C. KINDIG
OCT. 15, 1957 REG. ENGR.