


COAL & LAND SURVEY FOR
 NORTH SEWICKLEY COAL CO
 IN NORTH SEWICKLEY TOWNSHIP
 BLAKE COUNTY, PENNA.
 SCALE 1"=100'
 JUNE 1947
 ADDITIONS NOV. 1956
 BY F. KOPRIVA, JR. M.E.

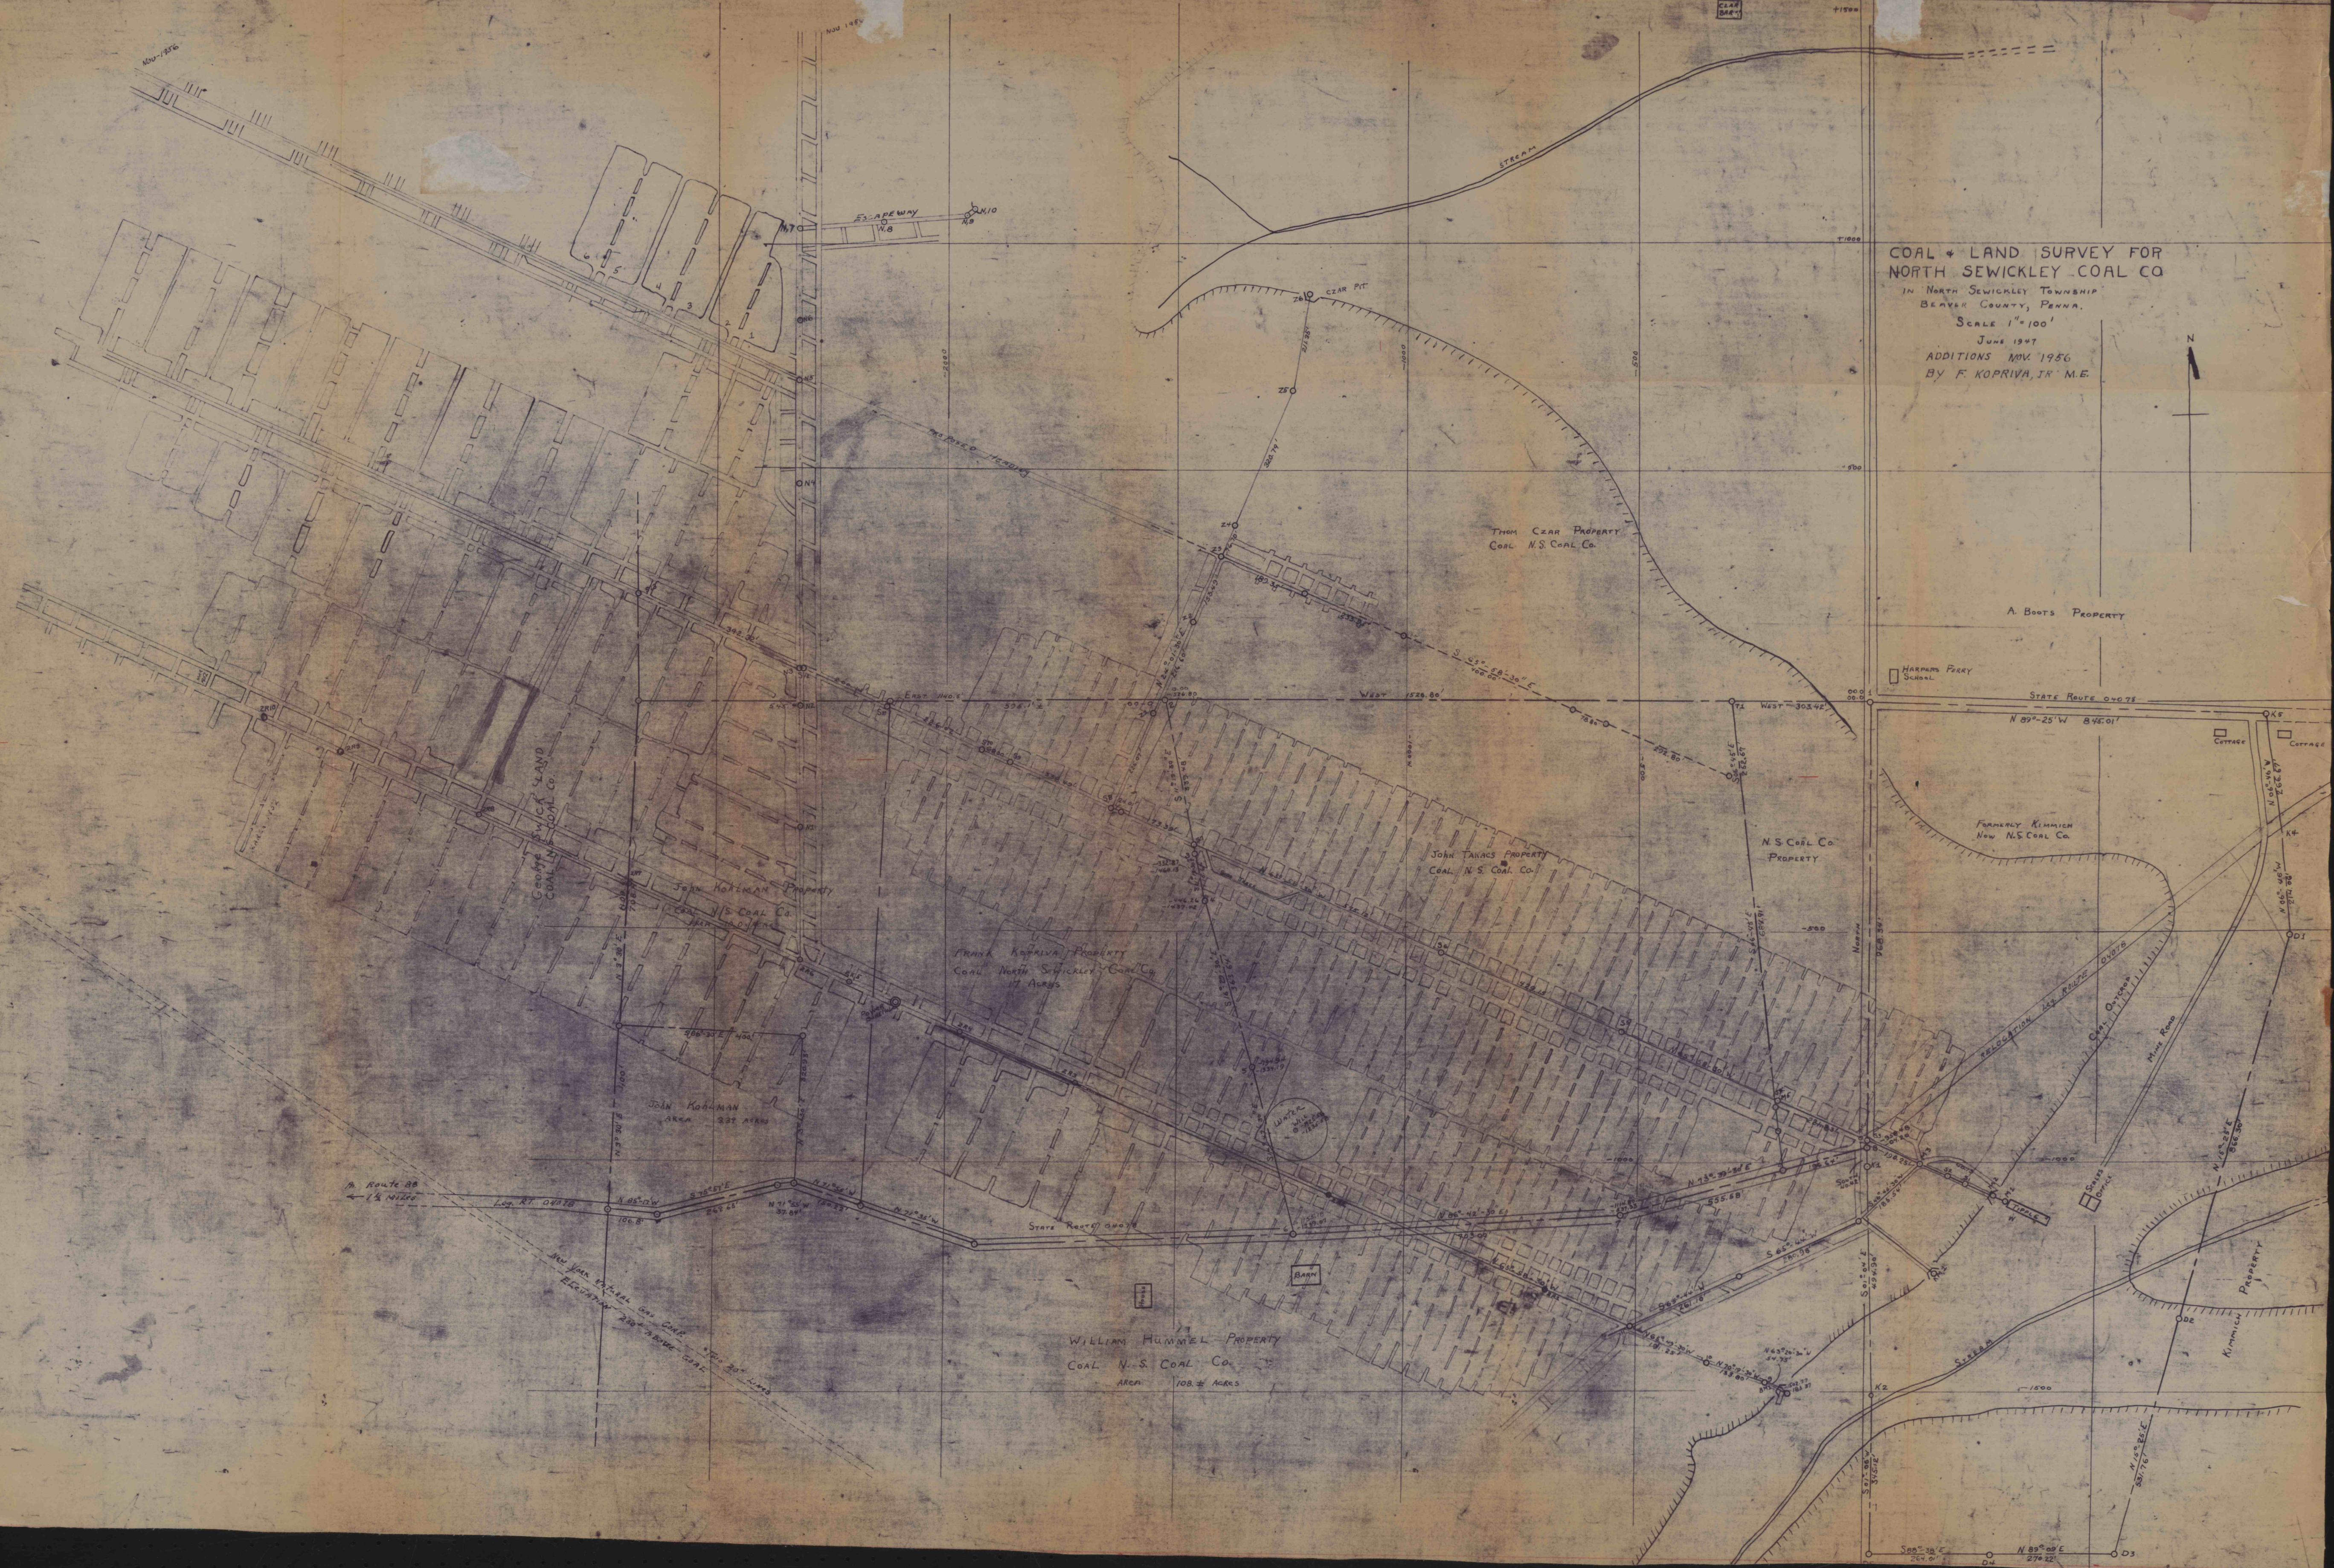

WILLIAM HUMMEL PROPERTY
 COAL N. S. COAL CO.
 AREA 108 ± ACRES

S 88° 38' E 264.07' O4
 N 89° 20' E 278.22' O3