

JAMES M. McINTYRE & CO.


BUNKER HILL COAL CO.


# MAP OF BACON No 5 MINE

OPERATED BY  
**E. EICHELBERGER & CO.**  
Broad Top Township — Bedford County

KELLY SEAM  
— 1928 —

MINE	OPERATORS	REVISION
No. 6	Neville & Everitts	
No. 9	Wm. H. Martin	

JAMES M. McINTYRE & CO.

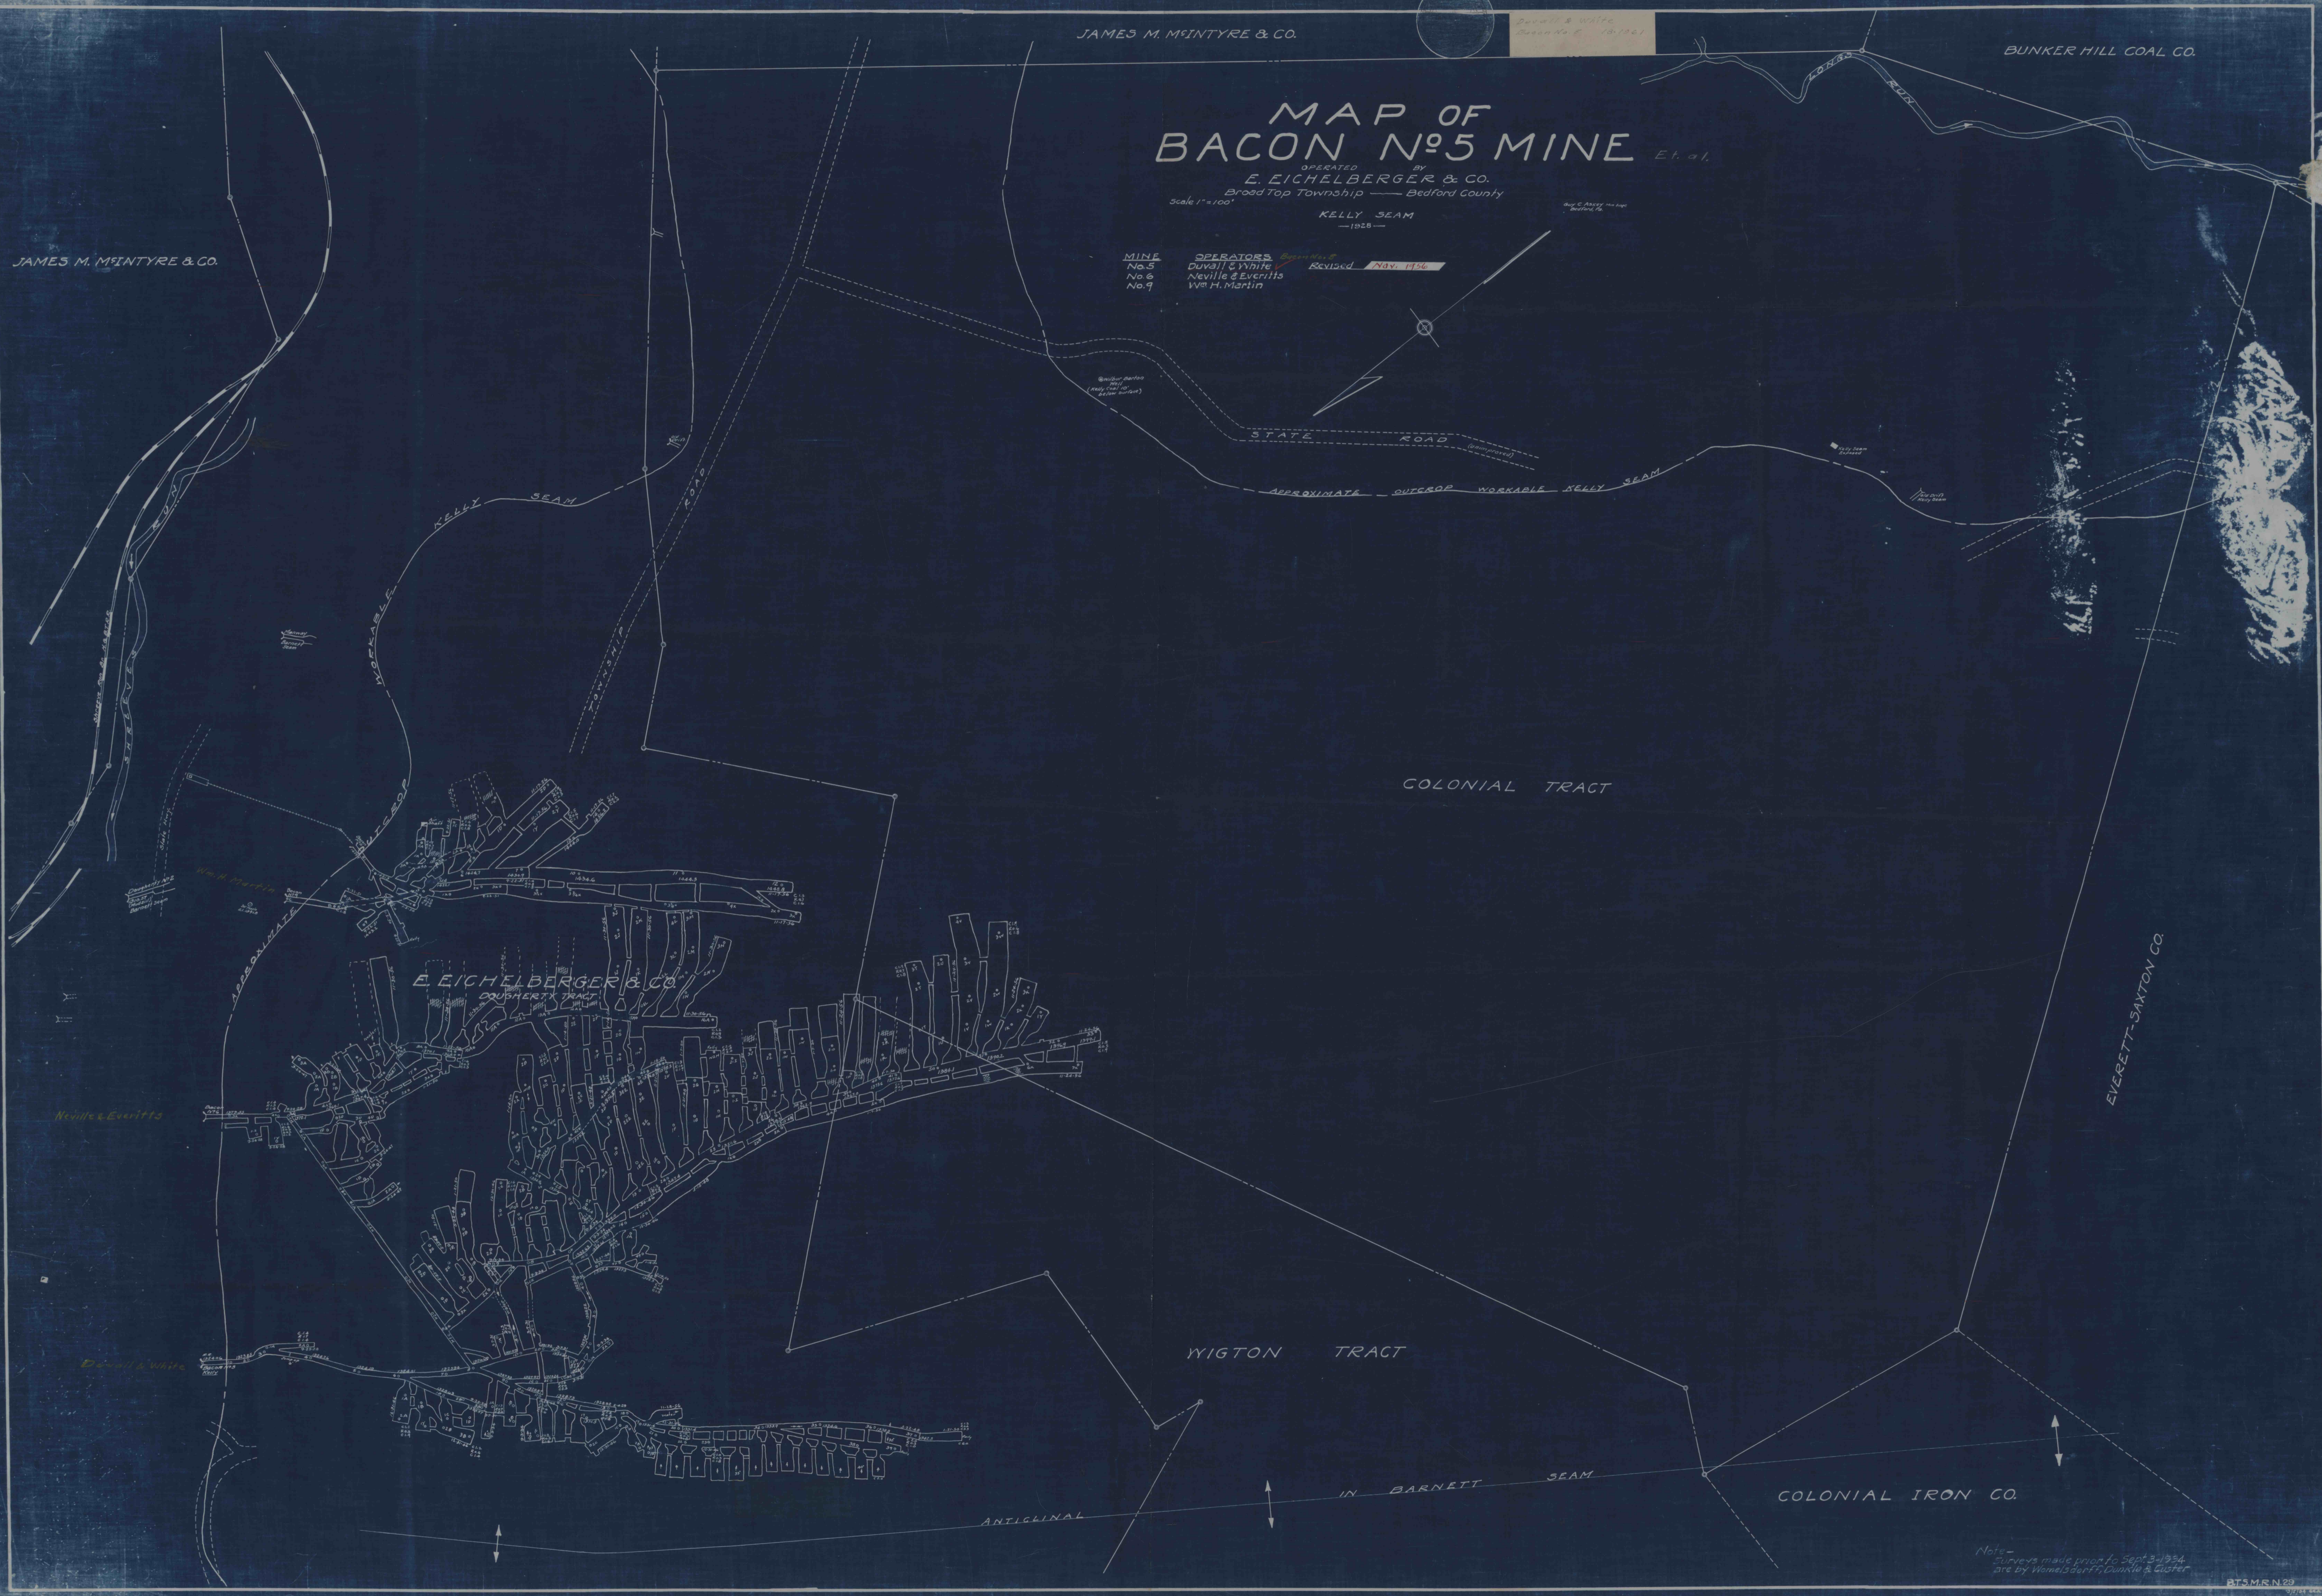

COLONIAL TRACT

E. EICHELBERGER & CO.  
DOUGHERTY TRACT

WIGTON TRACT

EVERETT-SAXTON CO.

COLONIAL IRON CO.

ANTICLINAL

IN BARNETT SEAM

Notes -  
Surveys made prior to Sept 3-1934  
are by Womels Dept. of Dunlap & Custer