

JAMES M. MCINTYRE & CO.

JAMES M. MCINTYRE & CO.

BUNKER HILL COAL CO.

MAP OF BACON No 5 MINE

OPERATED BY EICHELBERGER & CO.
Broad Top Township Bedford County

KELLY SEAM
— 1928 —

MINE DEPARTMENTS
Nos. 5, 6, 7, 8, 9
Duvall, C. White, Level 1, 2, 3, 4, 5, 6, 7, 8, 9

RECORDED IN DEEDS
Book 17, Page 172

STATE ROAD


COLONIAL TRACT

EICHELBERGER & CO.


WIGTON TRACT

COLONIAL IRON CO.

EVERETT-SAXTON CO.

ANTICLINAL

IN BARNETT SEAM

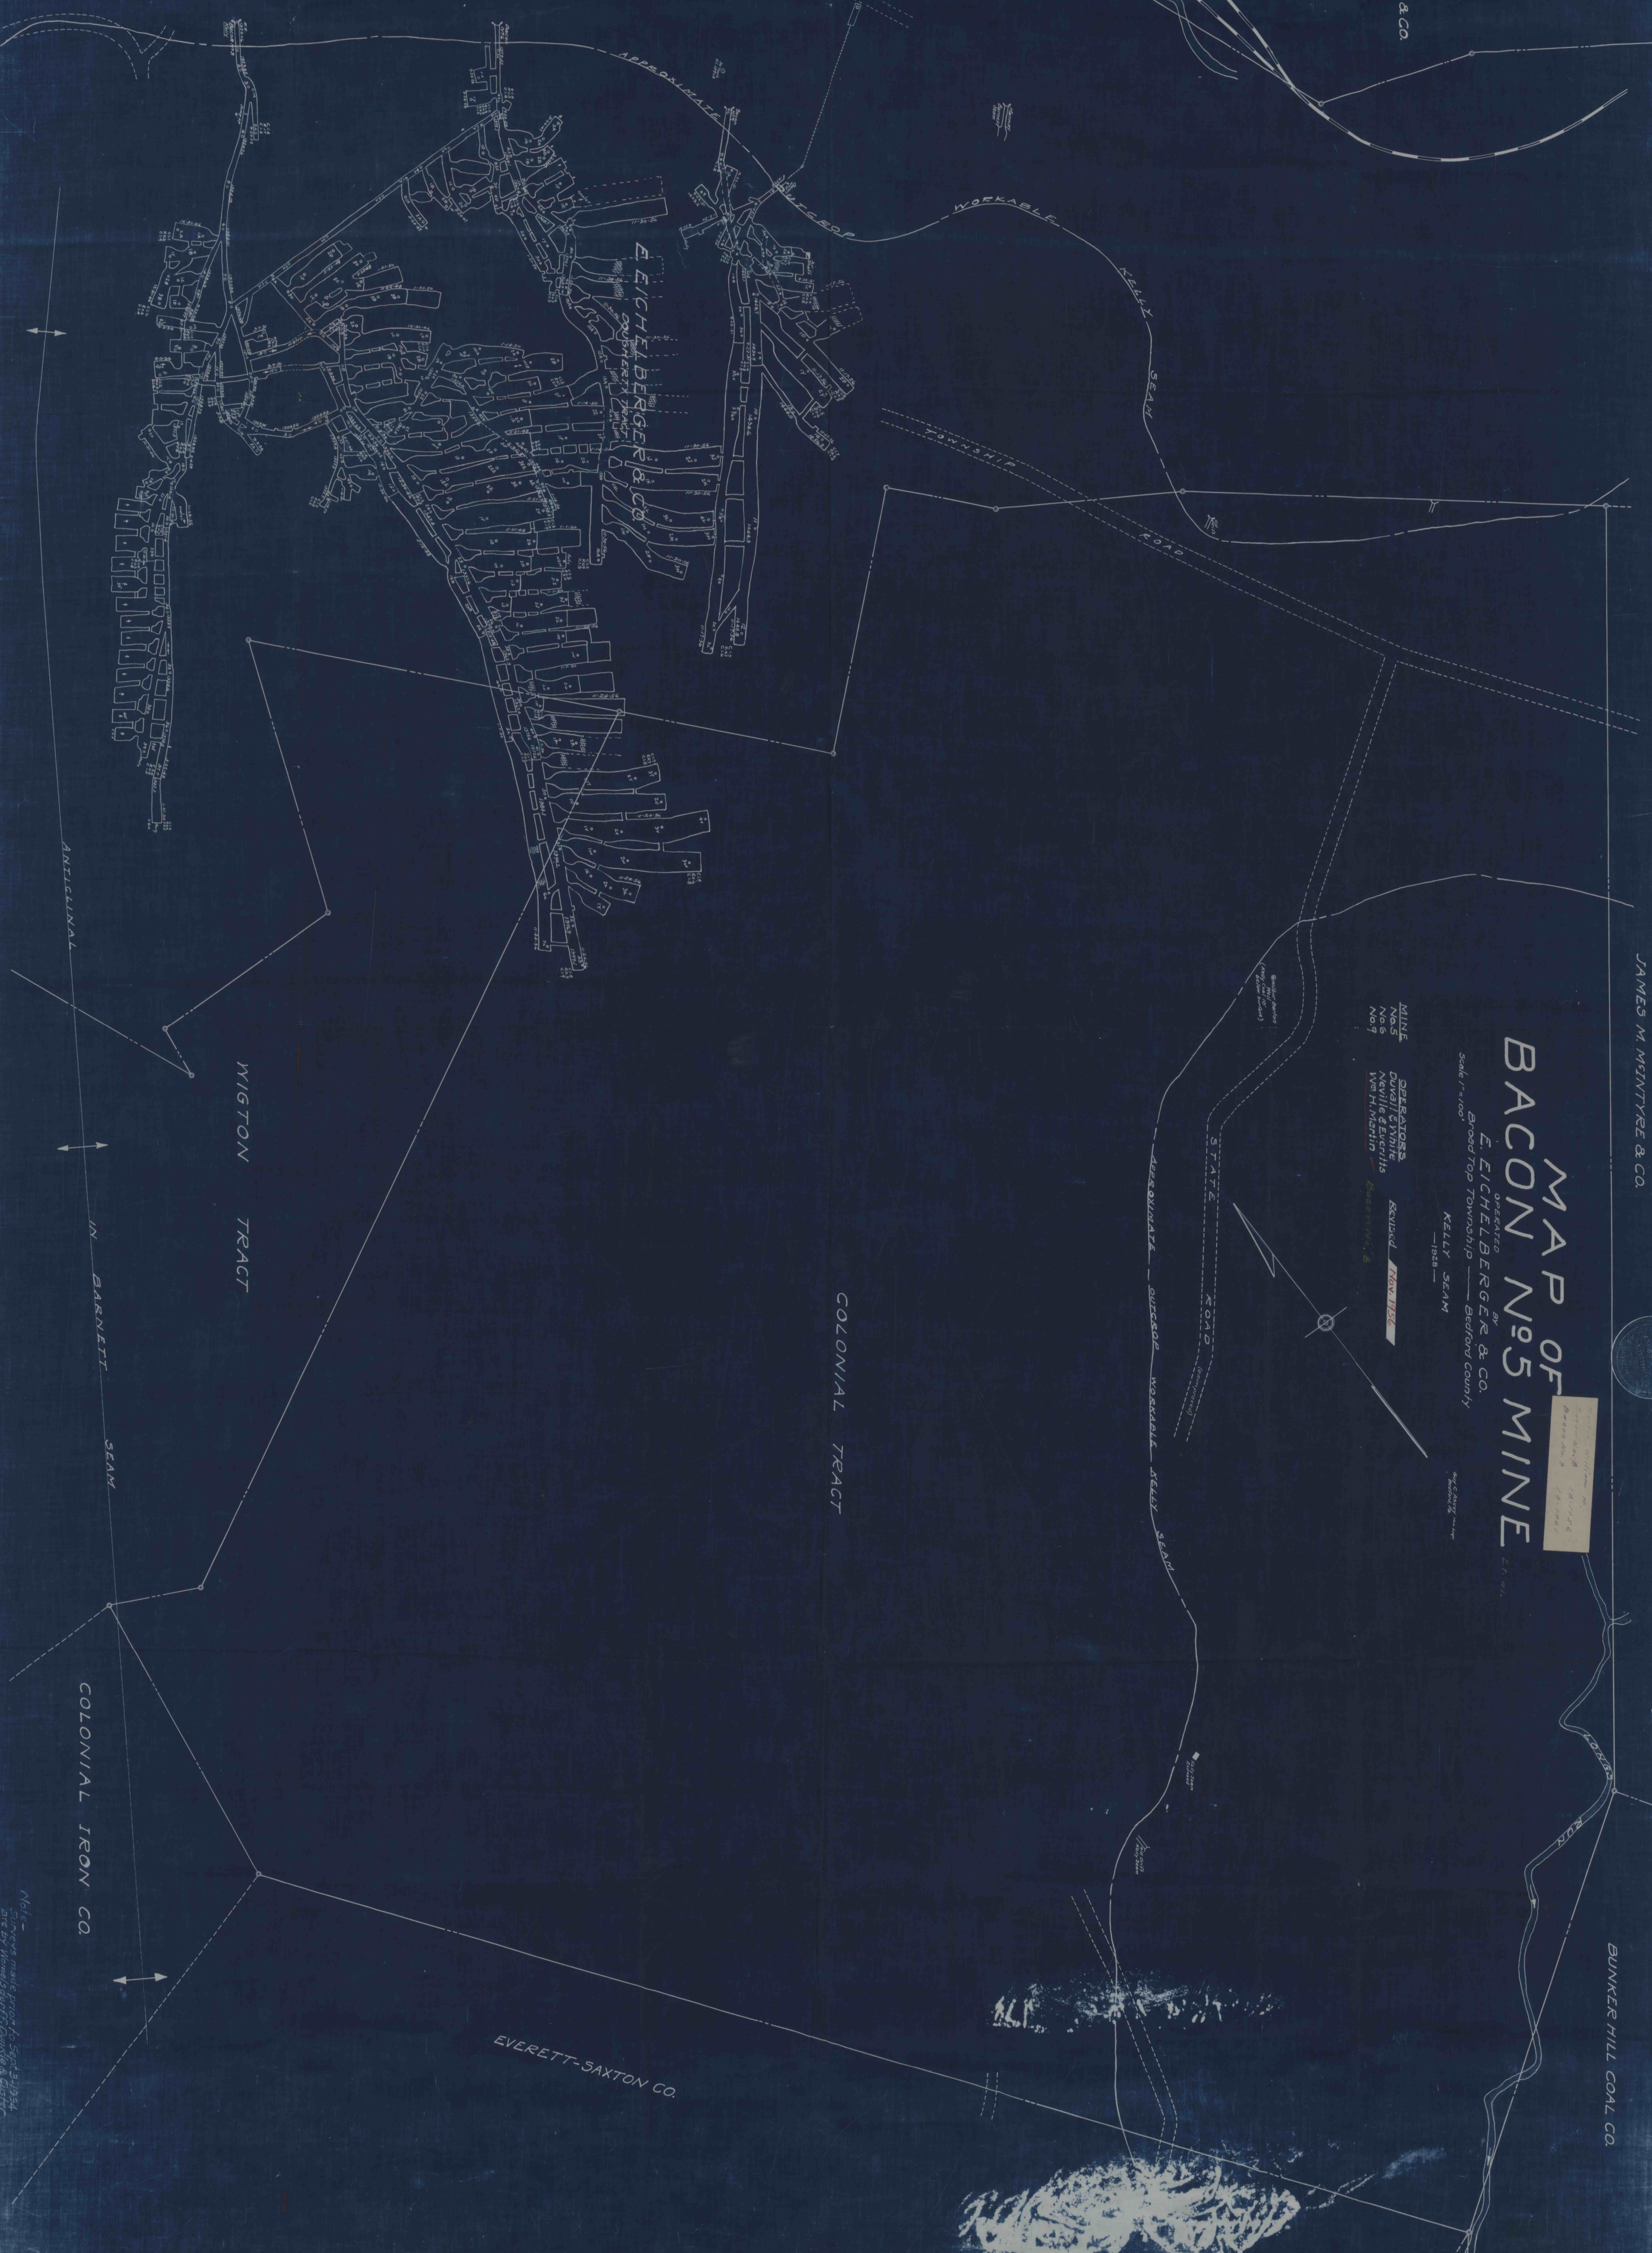

Note: Changes made from No. 5, 6, 7, 8, 9 are by Wm. L. Duvall, C. White & Co.