


Map Showing Mine workings on the Property of S. S. Loucks Situated in Broad Top, The Bedford County Pennsylvania
Sept. 1906 1" = 100' Estate Map, Reference 12

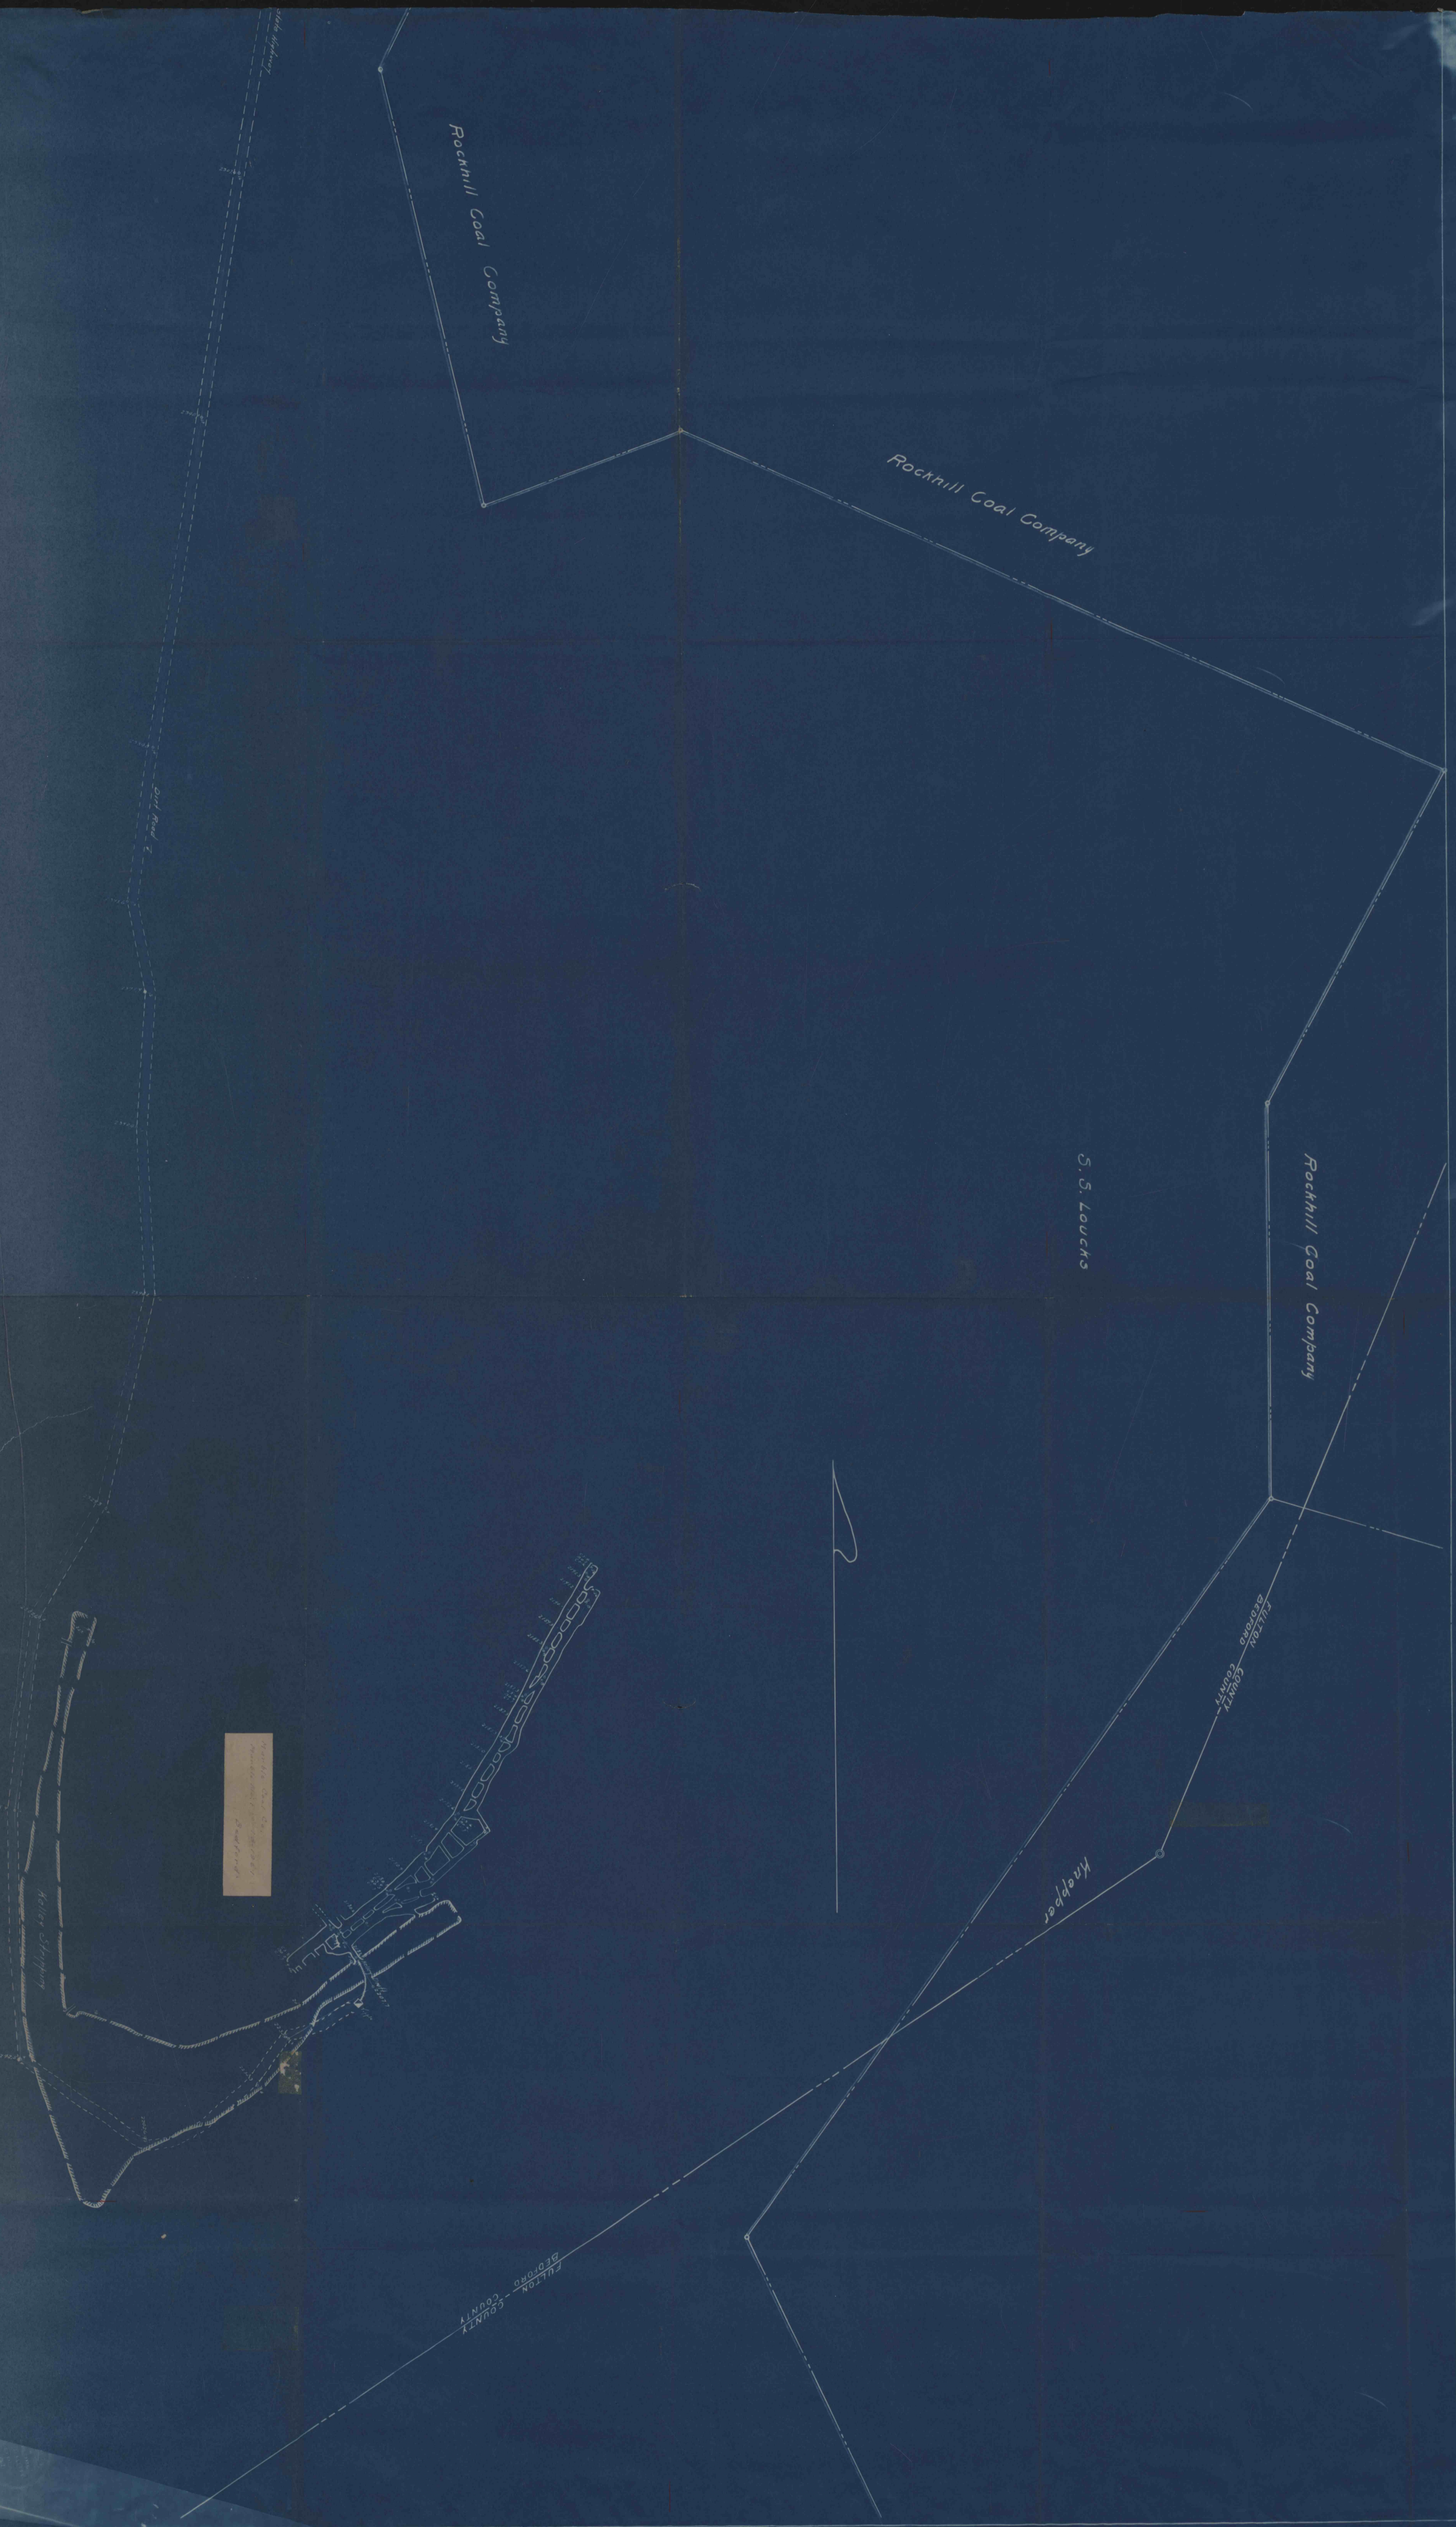

Small rectangular label with illegible text, possibly a title or reference number.