
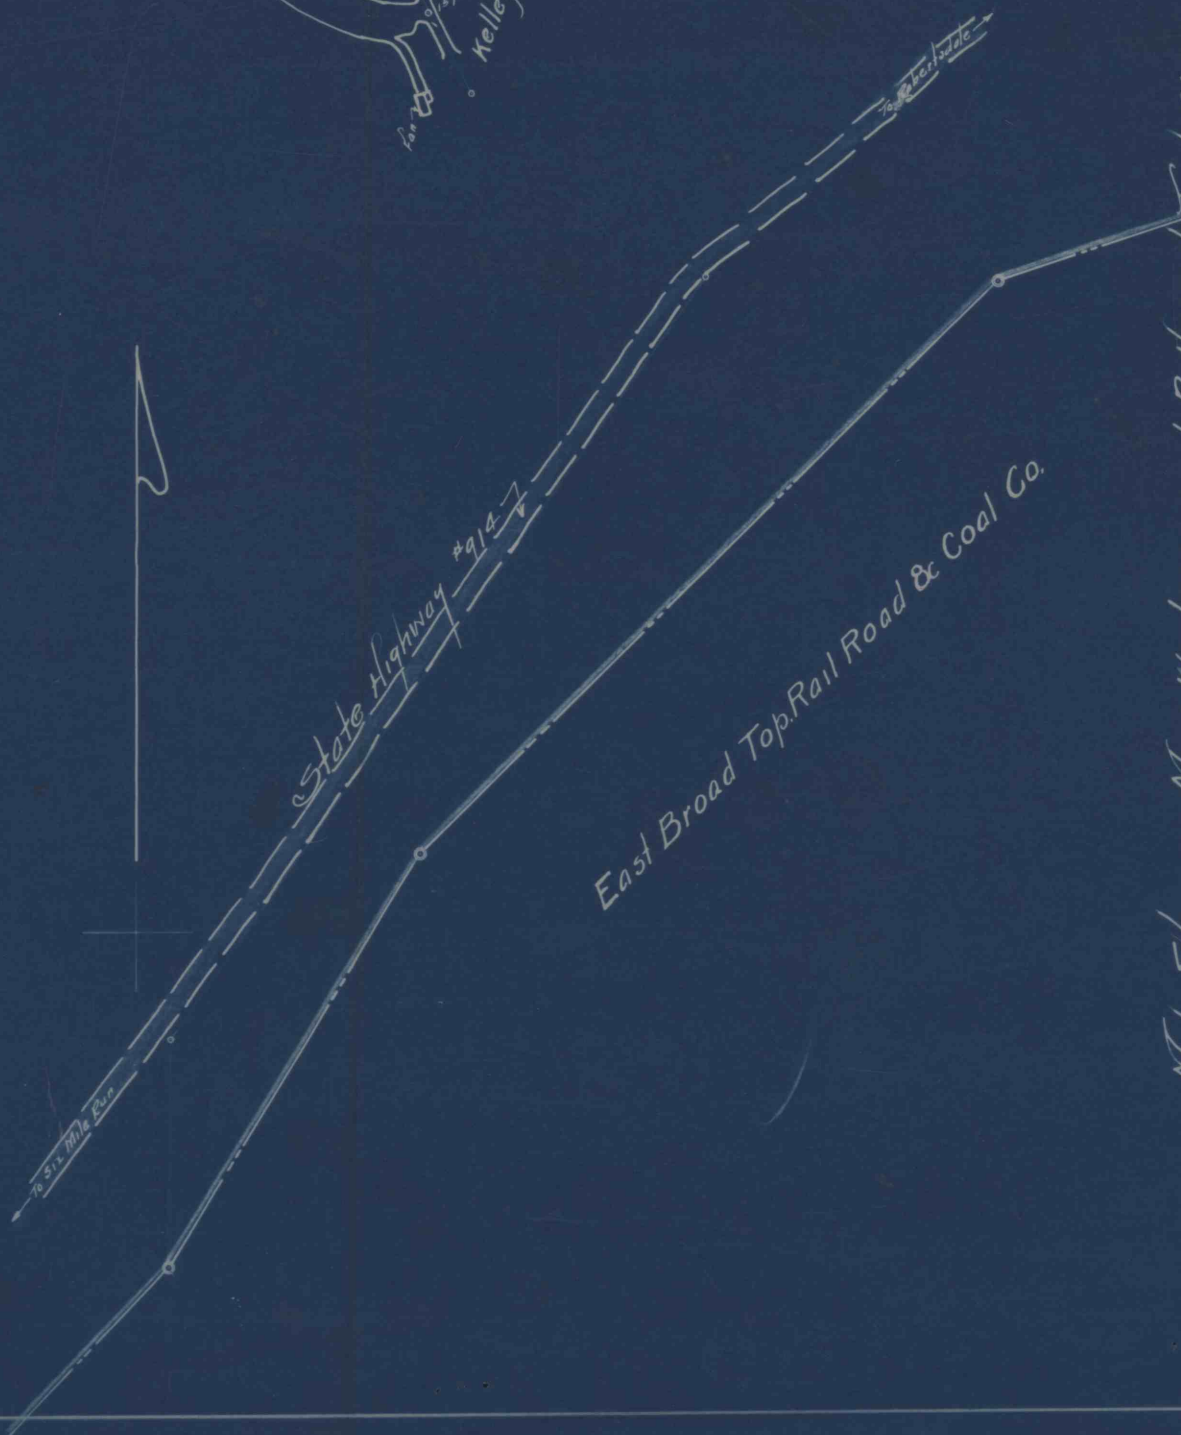


Hinrich & Kaituma
Wright 18-1961

J. B. Harnish Tract

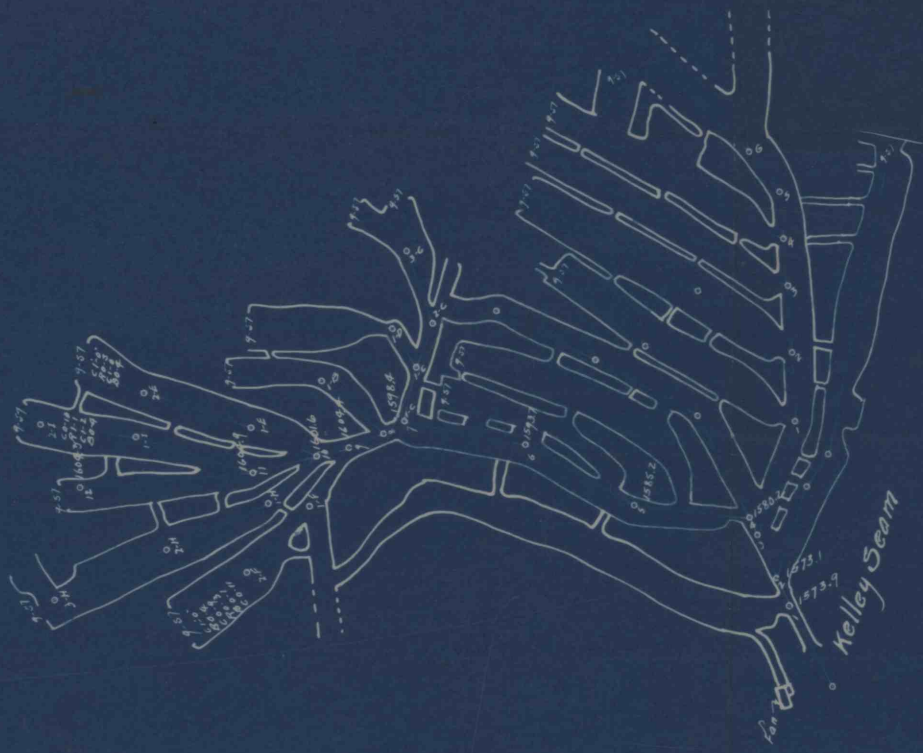

Map Showing Mine Workings on J. B. Harnish Tract Operated By C. Wright Situated in Broad Top Tap Bedford County Pennsylvania. 1" = 1 Mi. Sept. 1957 E. Corrie Eng. Robertsdale Pa.