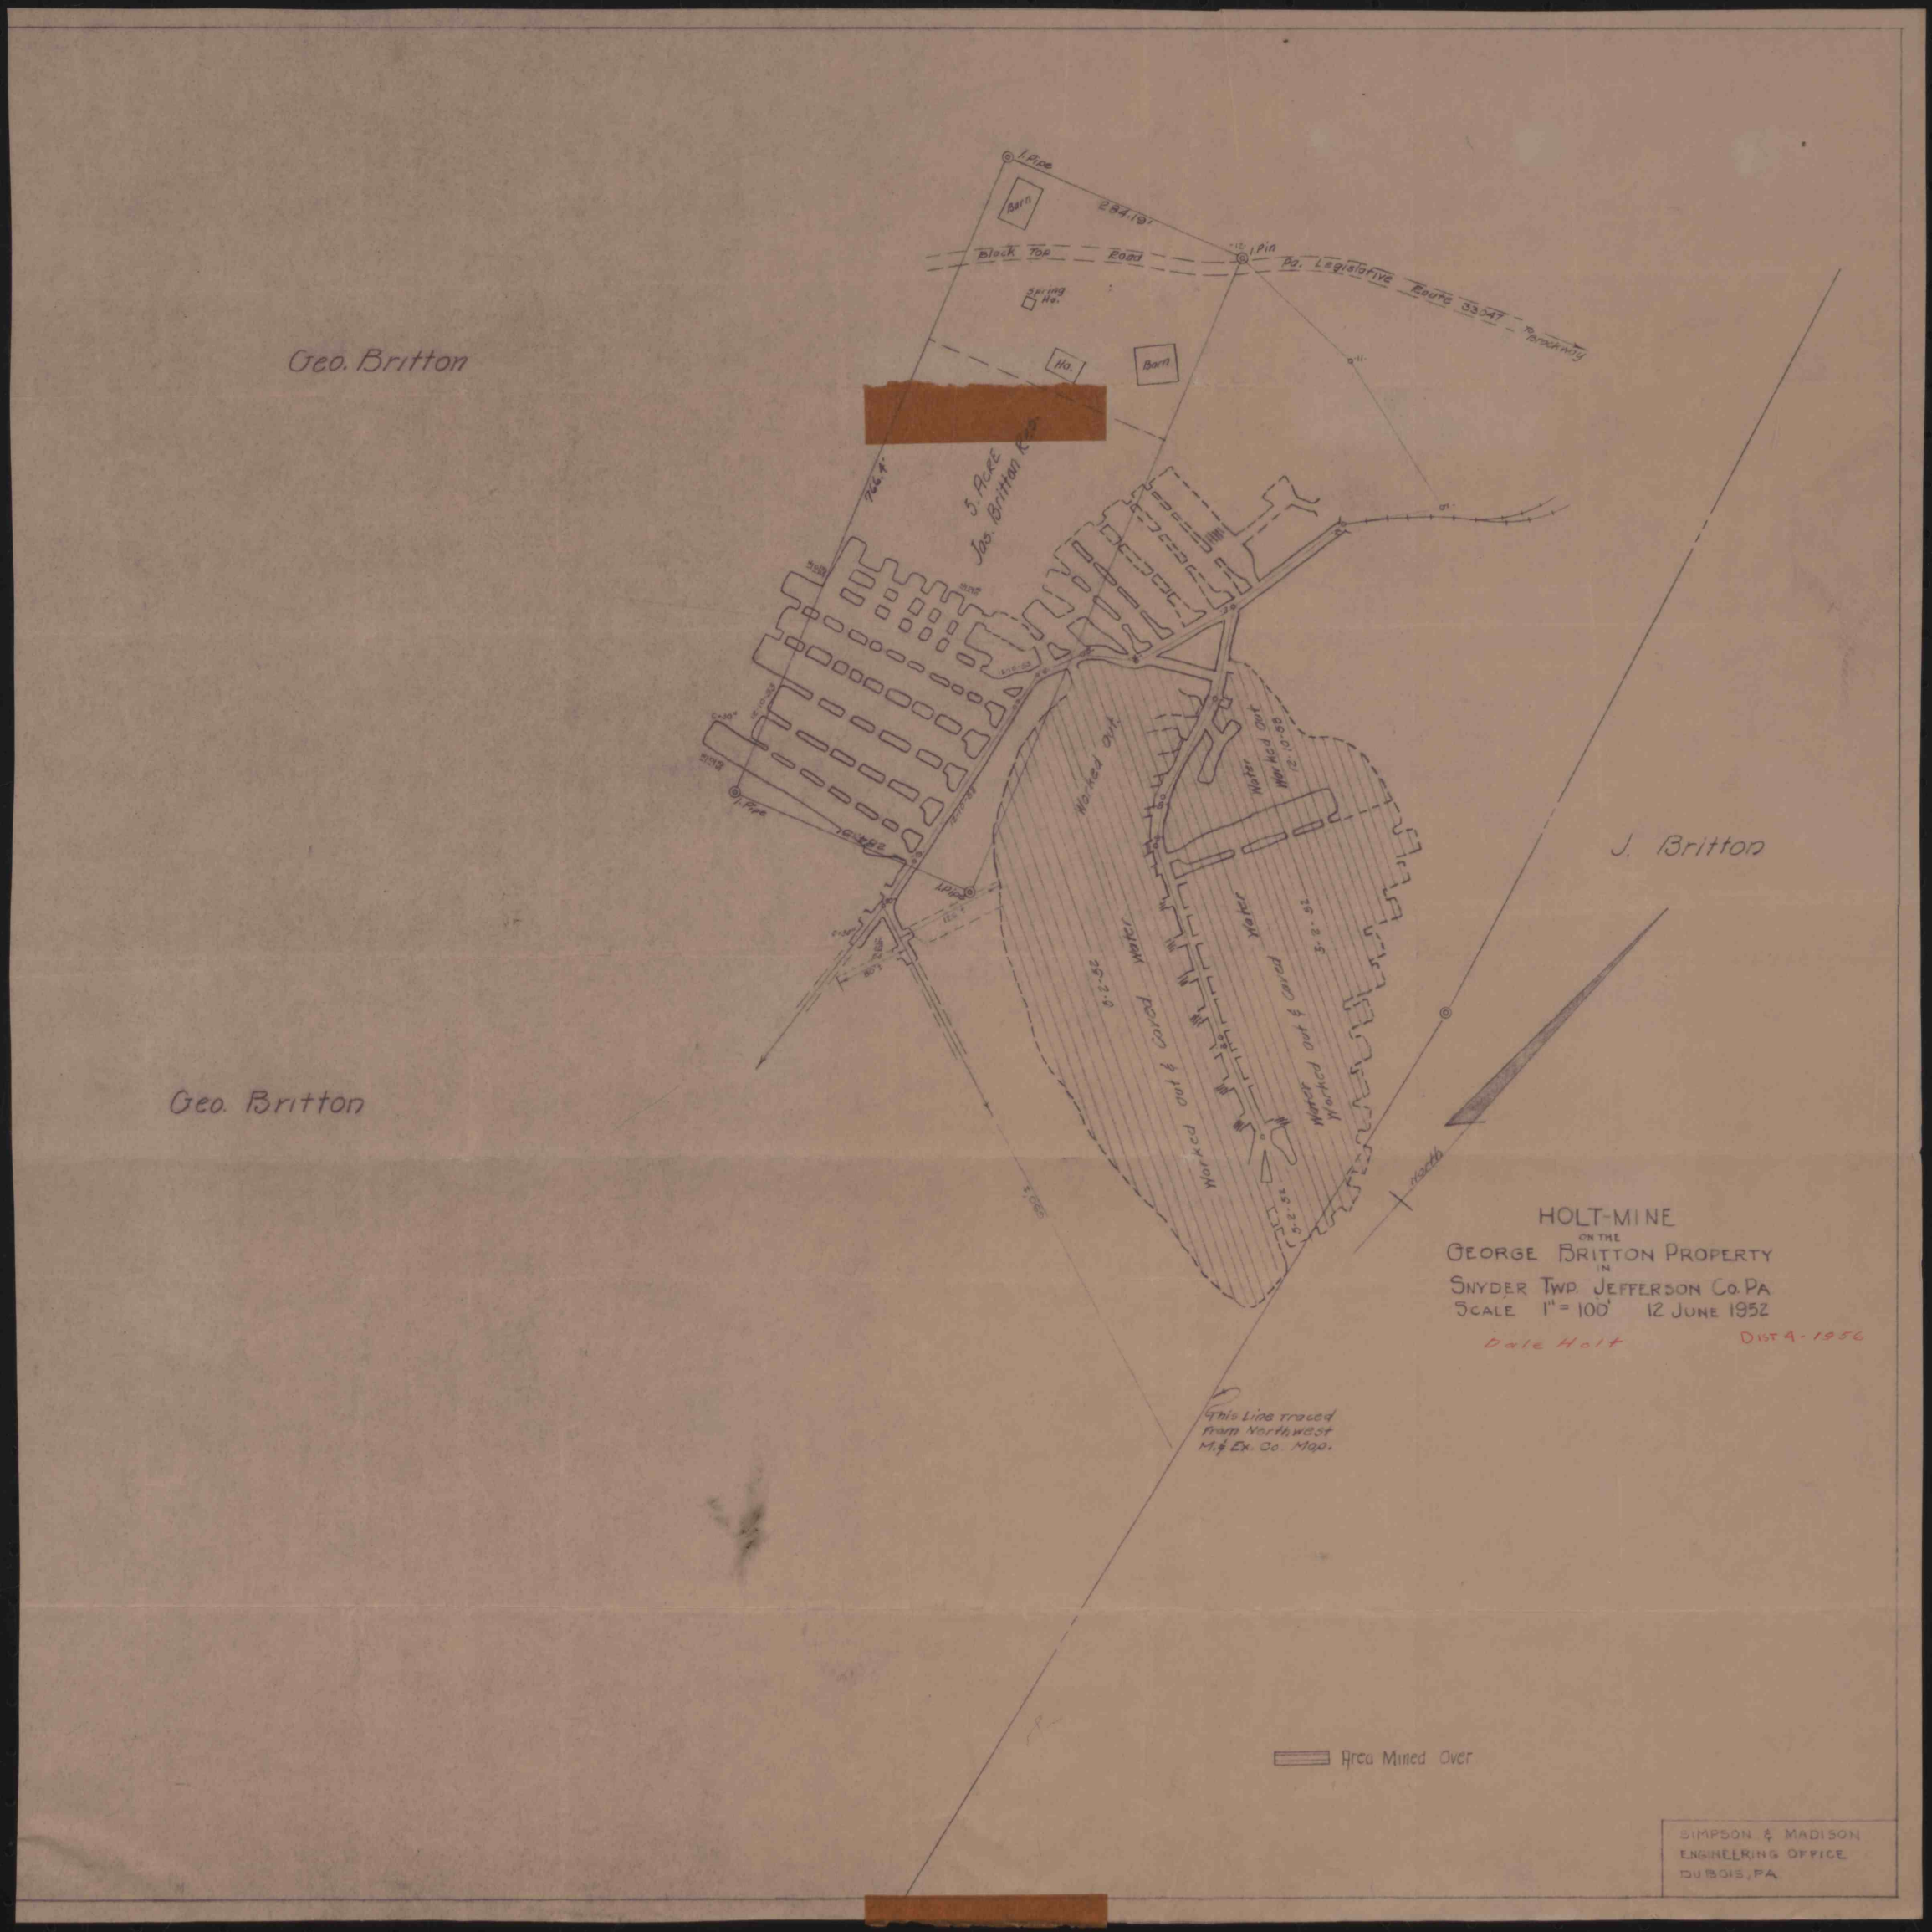

Geo. Britton
Geo. Britton
J. Britton
Barn
Ho.
Barn
Block Top Road
Pa. Legislative Route 33047
To Brockway
Spring Ho.
I. Pipe
I. Pin
284.19'
766.4'
5 ACRE
Jas. Britton Res.
Worked out
Water
Worked out & Caved
Water
Worked out & Caved
Water
Worked out
12-10-53
5-2-52
5-2-52
5-2-52
North
This Line traced from Northwest M. & Ex. Co. Map.
Area Mined Over
HOLT-MINE
ON THE
GEORGE BRITTON PROPERTY
IN
SNYDER TWP. JEFFERSON CO. PA
SCALE 1" = 100'
12 JUNE 1952
Dale Holt
DIST 4 - 1956
SIMPSON & MADISON
ENGINEERING OFFICE
DUBOIS, PA.