


JOHN RALCORN
C. HUEFFMAN

OLD WORKS
COOLSPRING NAT
ANITA COAL CO.

STRAITIFF

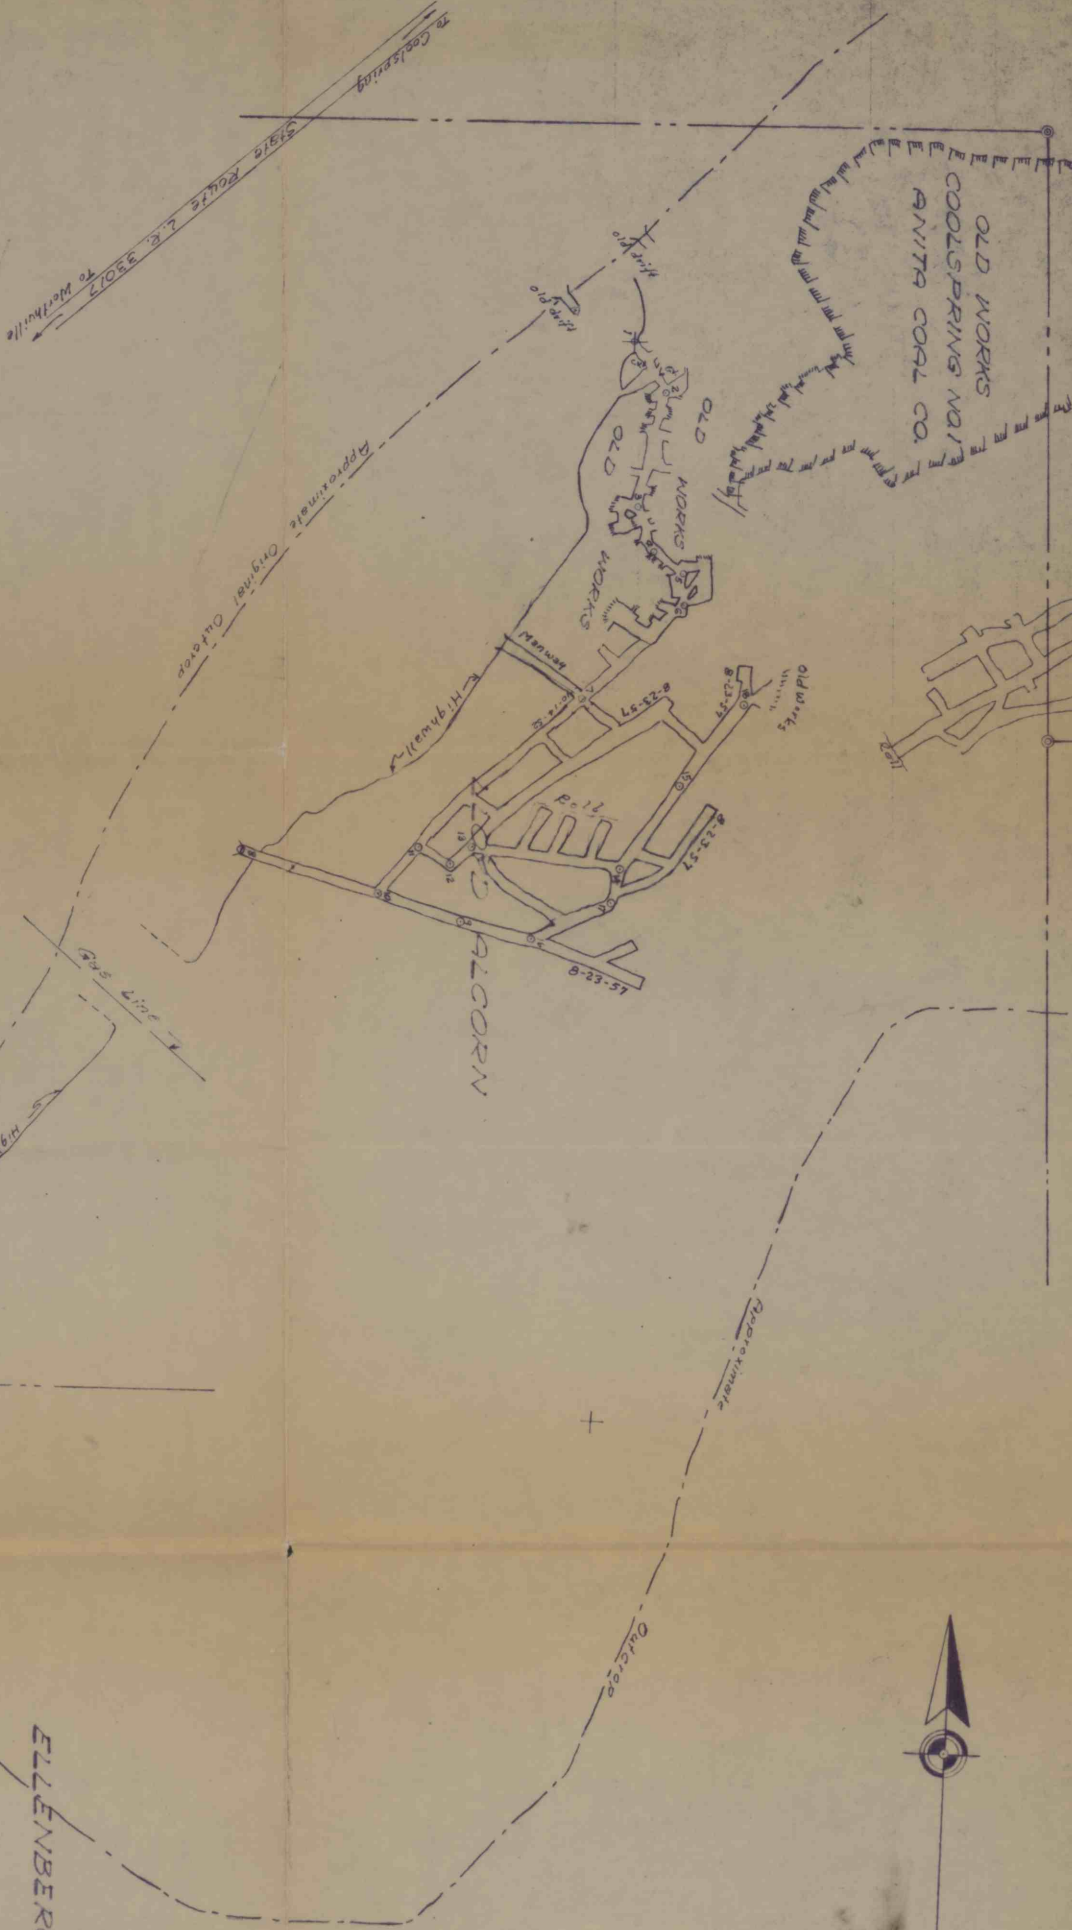

Shaffer & Hoffman Coal Co.
Huffman, #6
Shaffer & Hoffman #5
1956 Renewal
District 12

NINE MAP
R. L. SHAFER MINE

OLIVER TWP, JEFFERSON CO., PENNA.
SCALE 1" = 100' - AUG. 1952
Heller & Zimmerman - Surveyors - Engineers - Bucks & Lehigh, Pa.

ELLENBERGER

General Survey
Aug. 23, 1957