


MINE MAP  
**A. KENNEDY AND SONS**  
 NORTHWEST OF HAMILTON  
 PERRY TWP. JEFFERSON CO.  
 PENNSYLVANIA  
 LOWER FREEPORT SEAM  
 SCALE 1" = 100' MARCH 9, 1957  
 SURVEYED BY: R.L. HAAG

CURTIS SCHROCK

**SMITH AND REED HEIRS**

*Formerly David M. Blasc  
 Now H. S. Reed 2-20-1963  
 United Industries, Inc. District 12  
 Schrock Mine  
 Inspected 4/8/1962 Shaffner, Myron  
 Supt.*

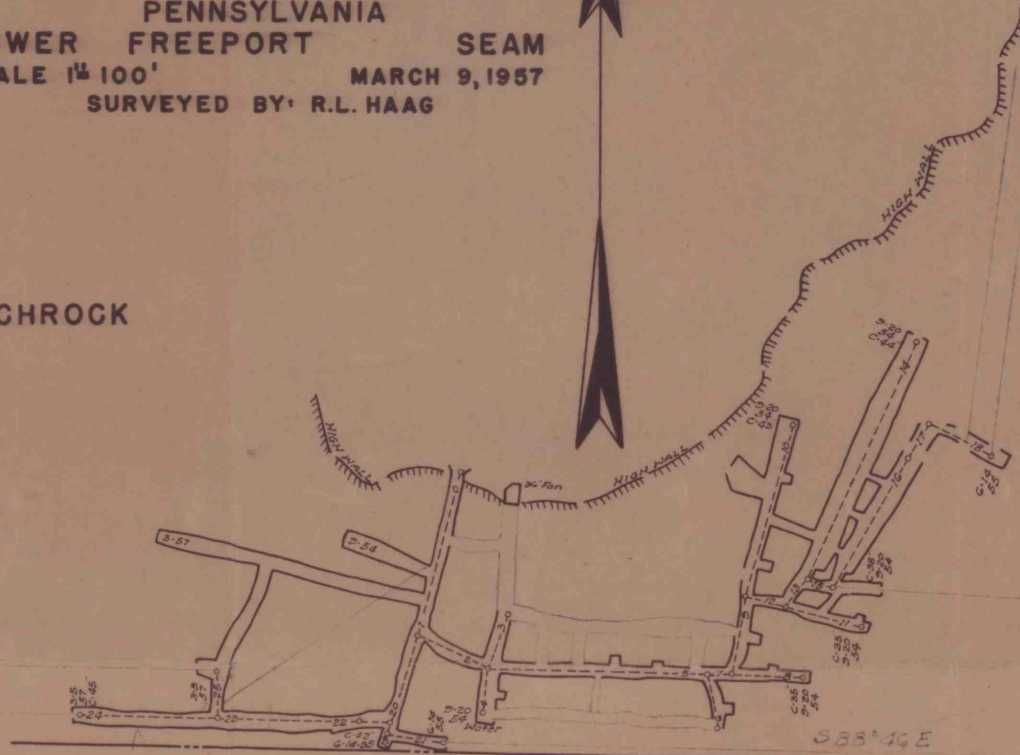

ALVIN KENNEDY

MEANS HEIRS

*Kennedy Coal Co.  
 Kennedy  
 District 12  
 1956 Annual*