BRUCE SMITH SURFACE
P. L. BROWN HEIRS COAL

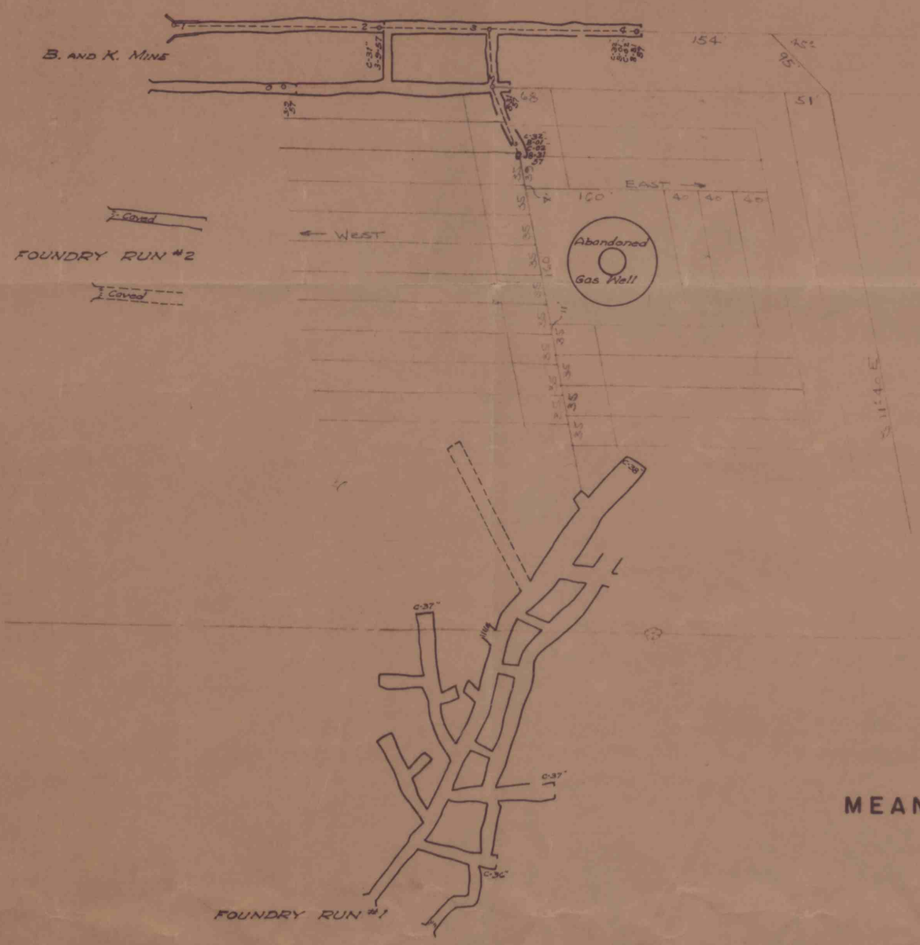

MEANS HEIRS

Kennedy Coal Co.
Kennedy
1956 Annual District 12

MINE MAP
OF
B. AND K. MINE NUMBER-5
NORTHWEST OF HAMILTON
PERRY TWP. JEFFERSON CO.
PENNSYLVANIA
LOWER FREEPORT SEAM
SCALE 1"=100' MARCH 9, 1957
SURVEYED BY: R. L. HAAG