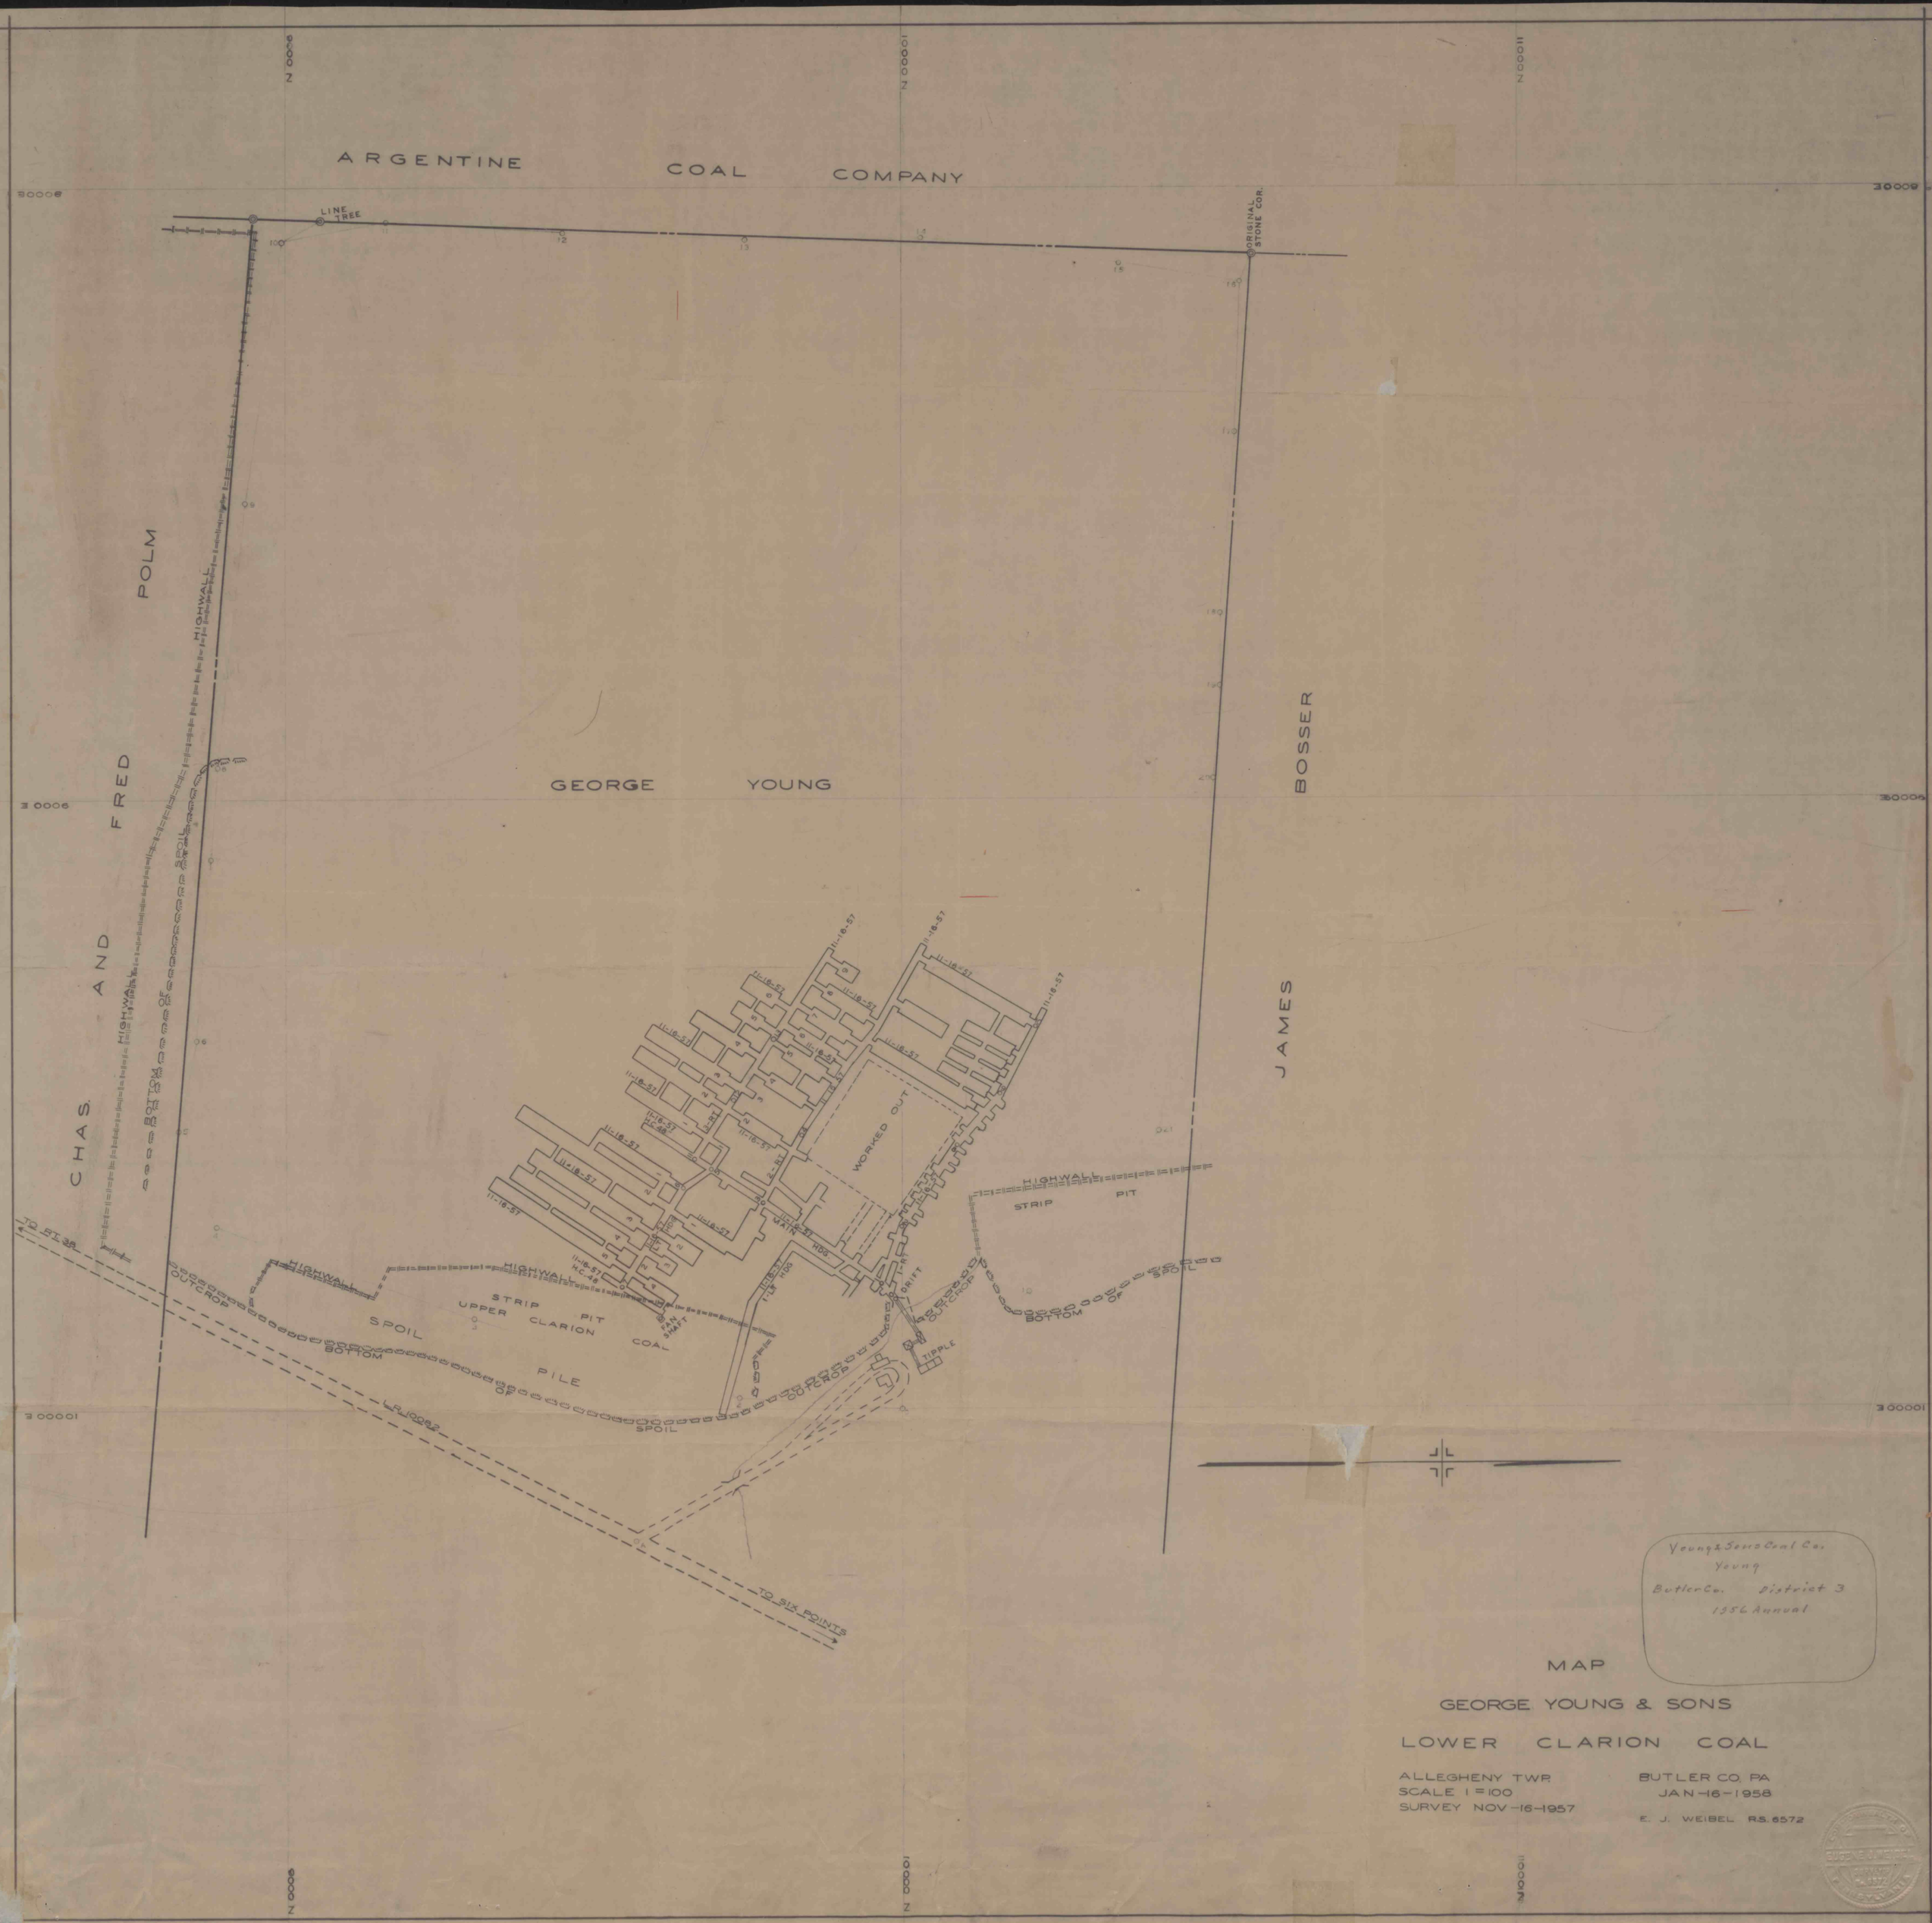
ARGENTINE COAL COMPANY
LINE TREE
ORIGINAL STONE COR.
CHAS. AND FRED POLM
HIGHWALL
BOTTOM OF SPOIL
GEORGE YOUNG
BOSSER
JAMES
WORKED OUT
MAIN HDG.
DRIFT
TIPPLE
HIGHWALL
STRIP PIT
UPPER CLARION COAL
SPOIL PILE
OUTCROP
BOTTOM OF SPOIL
TO RT. 38
L.R. 10082
TO SIX POINTS
Young & Sons Coal Co.
Young
Butler Co. District 3
1956 Annual
MAP
GEORGE YOUNG & SONS
LOWER CLARION COAL
ALLEGHENY TWP.
SCALE 1=100
SURVEY NOV-16-1957
BUTLER CO. PA
JAN-16-1958
E. J. WEIBEL R.S. 6572