

RALPH A. WEISS TRACT  
54.32 AC




SOUTH BOUND  
PI = 868+12.91  
Δ = 172-41-12' RT  
D = 12-30'  
R = 3817.83  
T = 594.30  
L = 1179.11

PITTSBURGH-ERIE FREEWAY  
LEG. ROUTE # 1021  
This Data from SHEET 17 & 19  
Of Recorded Plan, Butler County  
Recorder's Office, RAK 31 PAGE 2  
TRANSFERRED TO THIS PLAN.

2357+14.22/29  
SD = 852125.43

See sheet  
45 for data  
on location

Rebate  
T-336

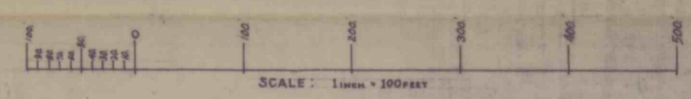

STANFORD COAL CO.  
MUDDY CREEK TOWNSHIP  
BUTLER COUNTY, PA.  
NOV. 1953 SCALE 1" = 100'  
McMAHON ENGINEERING CO.  
BUTLER, PENNA.  
SURVEY DATA

SYMBOL	SURVEY BY	DATE SURVEY EXTENDED	CHECKED BY
	McMahon Engineering Co.	SIGHTS DEC 19 1953	
	McMahon Engineering Co.	REVISED MAR 14 1954	
	McMahon Engineering Co.	REVISED 1957	
A	Charles Keller, Jr. and Tom Deverell, Butler, Pa.	August - 1961	Charles Keller
B	Charles Keller, Jr. and Tom Deverell, Butler, Pa.	July & September 1967	Charles Keller