Dist 3-1961

MINE SURVEY FOR GEORGE AMBROSE SITUATE WINFIELD TWP. BUTLER CO. PENNA.

SCALE: 1"=100' AUG. 1957

LUCAS ENGINEERING CO.
BUTLER, PA.
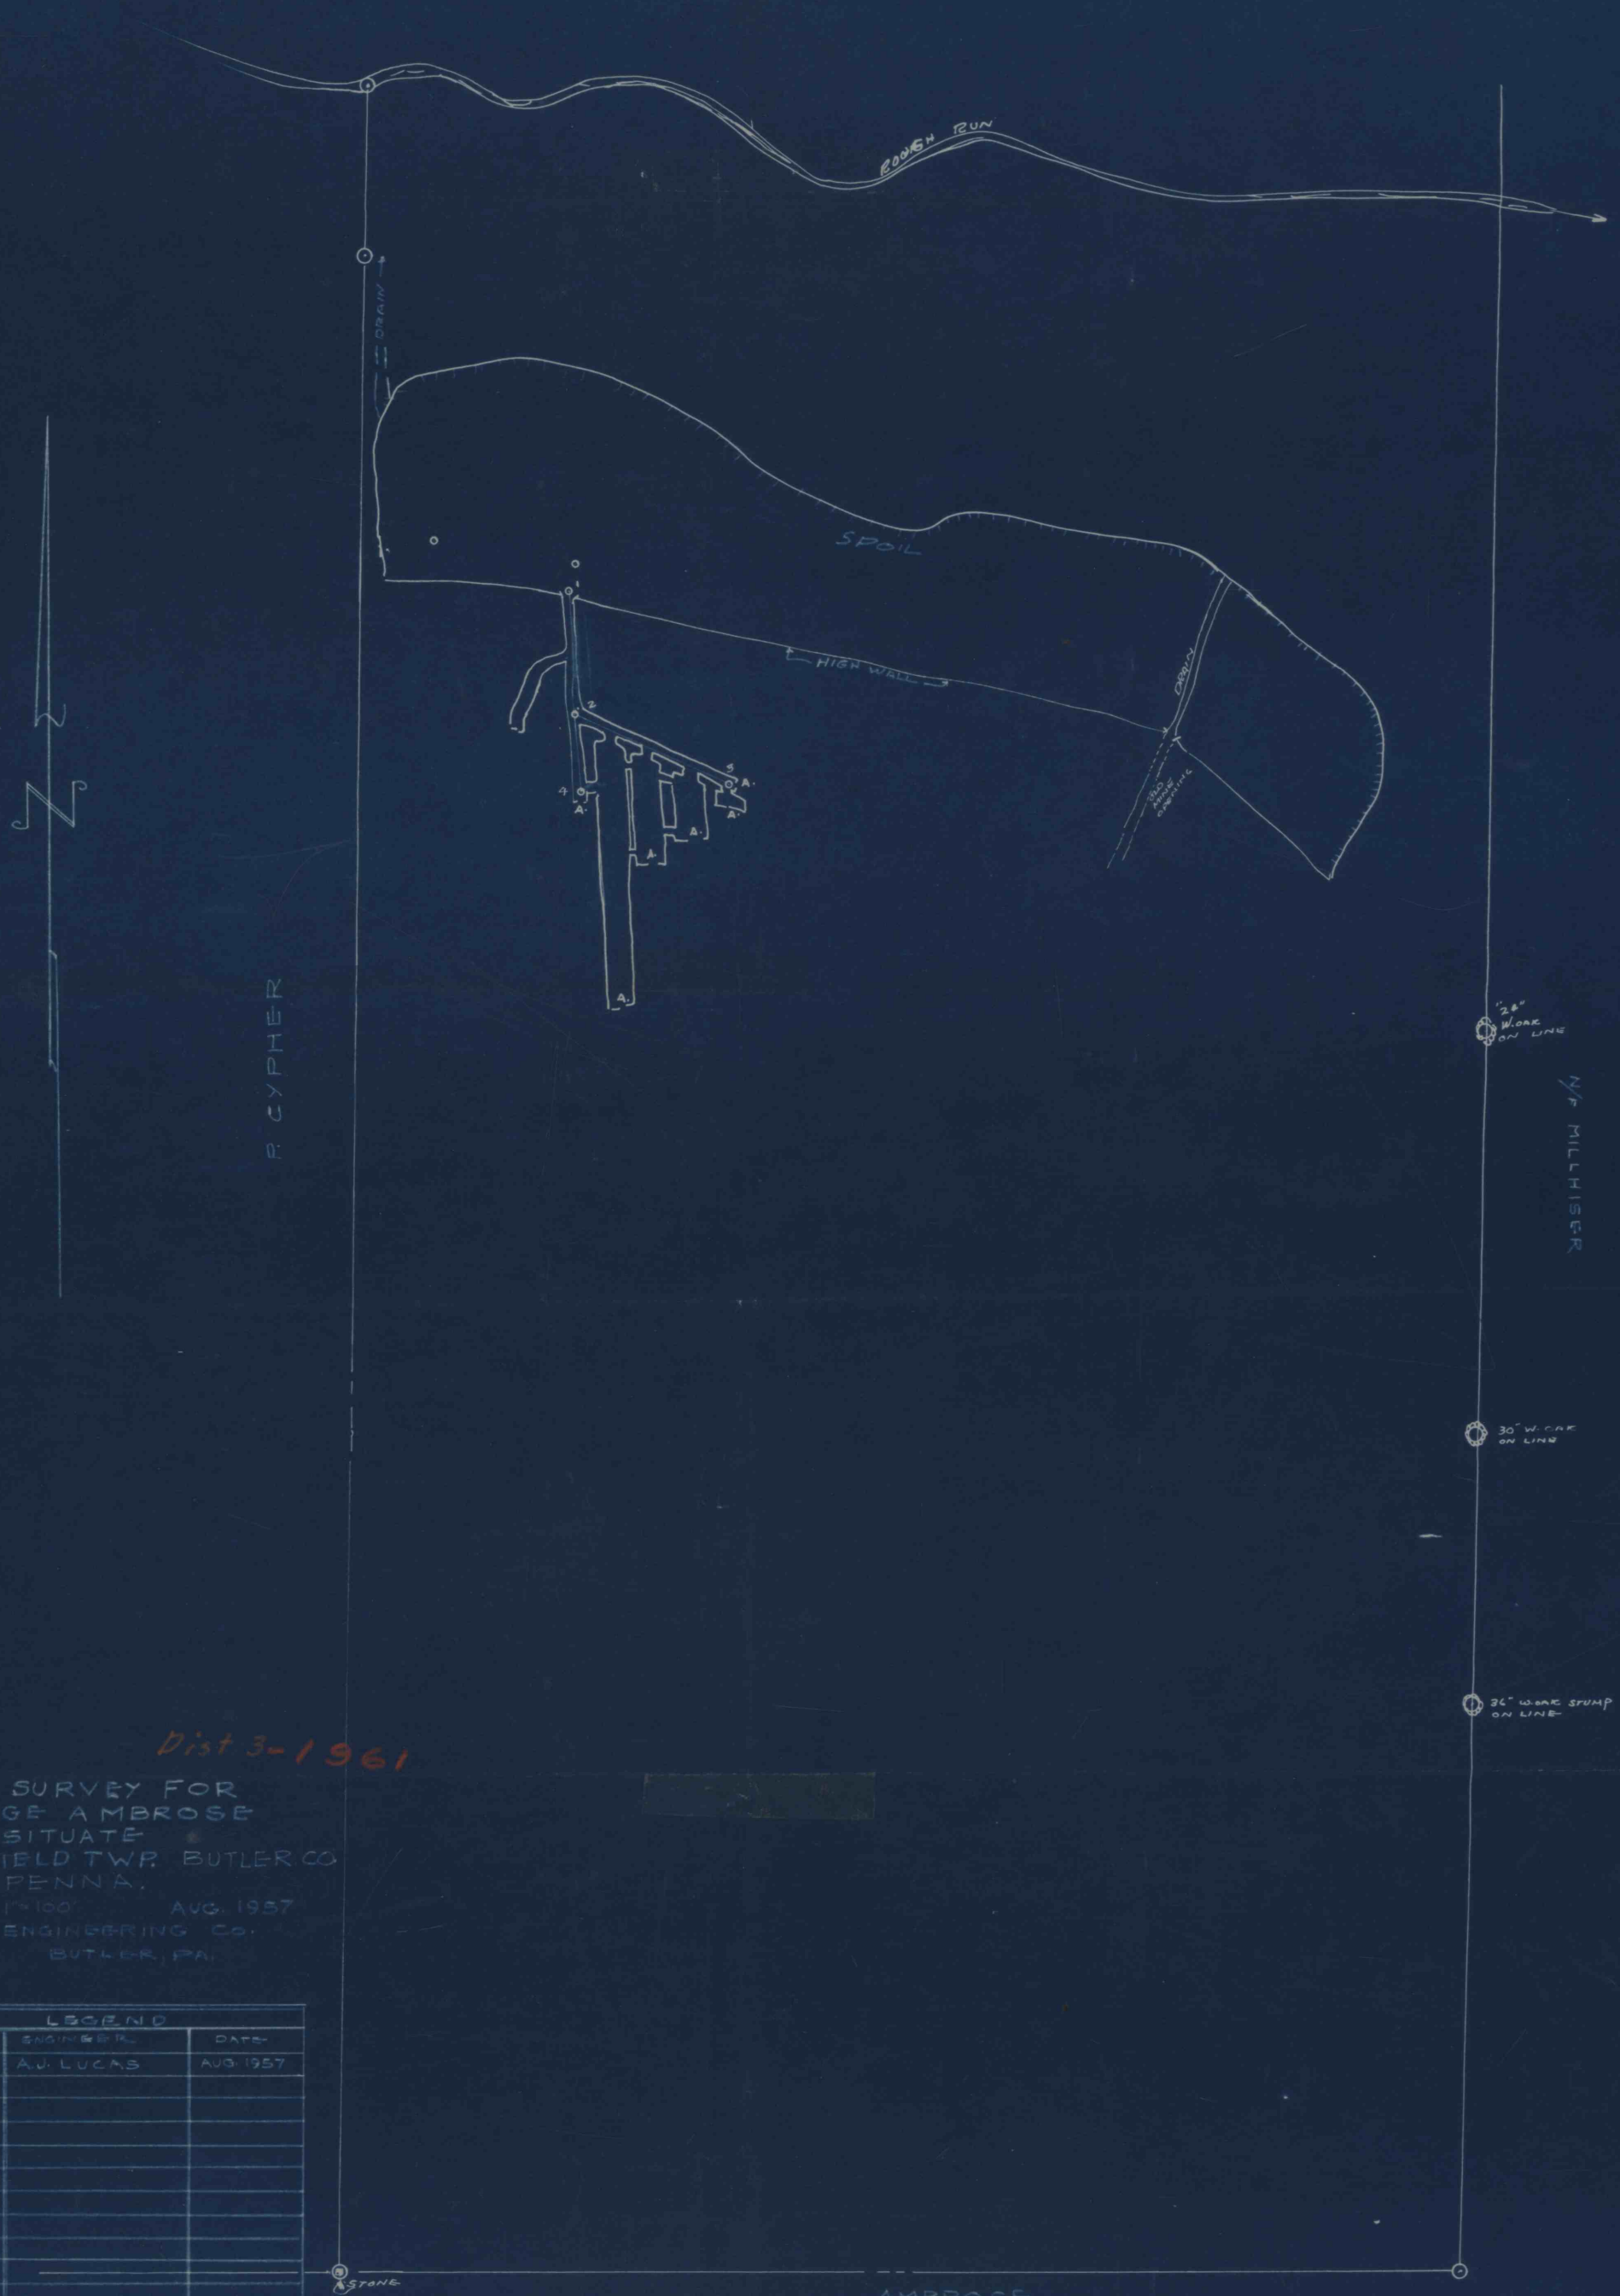
LEGEND		
SYMBOL	ENGINEER	DATE
A	A.J. LUCAS	AUG. 1957